IREDELL COUNTY HEALTH DEPARTMENT

Statesville Phone TR 3-7271 Mooresville Phone NO 3-1271

PERMIT TO INSTALL SEPTIC TANK

Permit No. 146 Permit Date 1/23 1923

Owner Hope Bro. Builders Address Route 7, Barkley Rd

Installed By Hope Bro. Builders Address Route 7, Barkley Rd


Location of Property Kings Dale Park off 115 on dirt road - 15-61 Lot No. 2

Tank		Capacity		Length of Lines		Fixtures	
Block	( )	1000	(✓)	225'	( )	No. of Baths	(1)
Precast	(✓)	1250	( )	250'	( )	Dishwasher	( )
		1500	( )	Other 900 sq ft		Garbage Grdr.	( )
		Other				Other	

NOTIFY HEALTH DEPARTMENT AT LEAST EIGHT HOURS BEFORE TANK IS TO BE INSPECTED.

Final Inspection 1/23 1923 Approved (✓) Disapproved ( )

Remarks Call In But Not Check

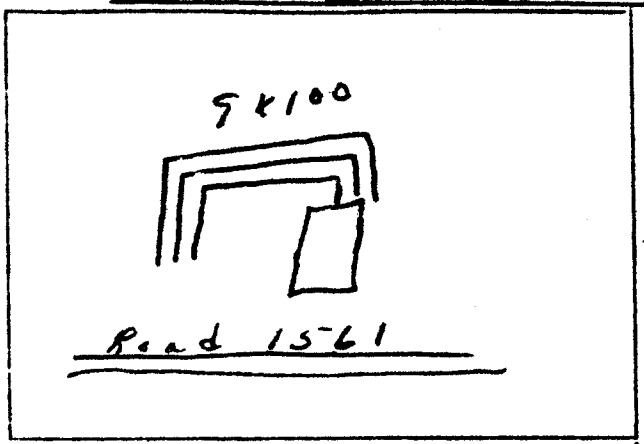

Sketch of Installation

Sanitarian