IREDELL COUNTY HEALTH DEPARTMENT

STATESVILLE 704-878-5305 MOORESVILLE 704-664-5281

IMPROVEMENT PERMIT / AUTHORIZATION TO CONSTRUCT / OPERATION PERMIT / EXISTING SYSTEM INSPECTION

PERMIT# 13461220 PIN# 4729143138 DATE 5-18-06

OWNER OR APPLICANT Tammy Morris PHONE: Business 704 876 2110 Home

ADDRESS 3853 Wilkesboro Hwy

LOCATION Wilkesboro Hwy (1) Country Life 1st of (2)

SUBDIVISION Country Life Estates BLOCK / SECTION 1 LOT 45 LOT AREA SITE CLASS. PS DESIGN FLOW 360 total L.T.A.R. .3

Septic Tank: Ex. Gallons: STB Ex. Date Ex.
Pump Tank: Gallons: PT Date
Pump Make: Model Serial No.
Nitrification Field: No Fields Square Feet Linear Feet
No Lines 1 add Trench Width 36" Max Trench Bottom Depth 36"

☐ New System ☐ Repair ☒ Expansion System Type: I II III IV V VI
System Description: 25% Reduction Gravity
Repair System Description: 25% Reduction
Maintenance Agreement Required: ☐ Yes ☒ No
Gravel Depth n/a ☒ Gravity ☐ Pressure


☐ House/Mod. Home No. Bedrooms 3
☒ Mobile Home No. Persons
☐ Business No. Employees
☐ Other

Water Supply: ☒ Individual ☐ Public ☐ Community

☐ Slab ☒ Crawl Space ☐ Basement w/plumbing ☐ Basement wo/plumbing


Comments:/Conditions: Connect into existing d-box or replace distribution box with a larger one. 100' ft of 25% Reduction. New Home to be placed no further back than the back (marked) of existing trailer.

INITIAL SITE SKETCH

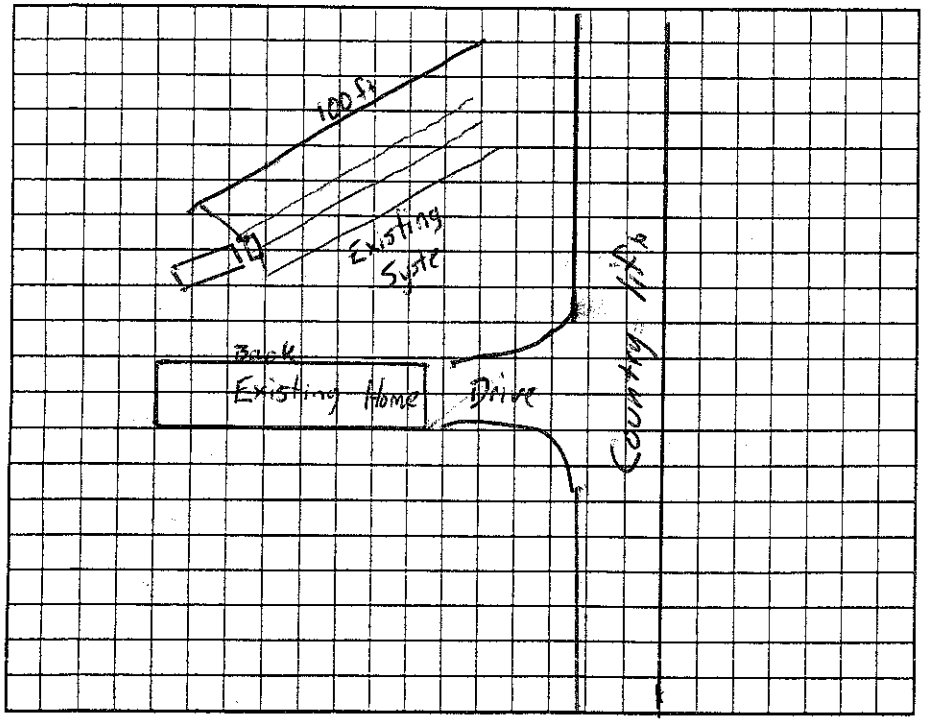

Comments:/Conditions: PUMPED TANK INSTALLED AS DRAWN

AS BUILT SKETCH

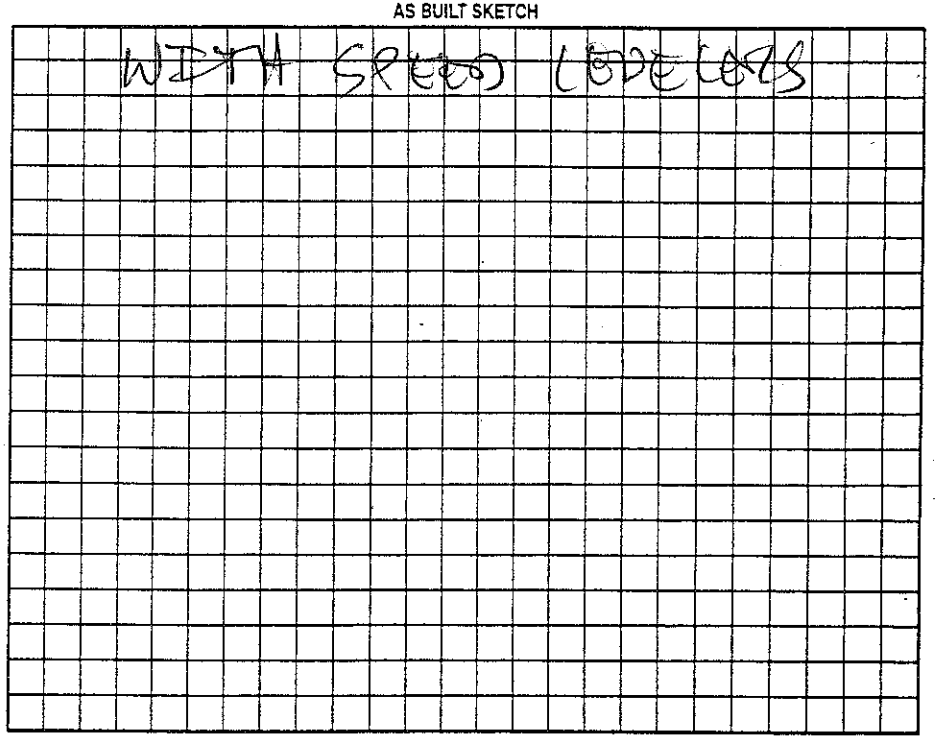

Permit can be suspended or revoked if any false information is supplied toward securing the permit/any unauthorized changes are made to the site/any unauthorized changes are made in the installation of the system. Improvement Permit with plat valid without expiration. ☐ Improvement Permit with site plan valid for sixty months ☐ Authorization to Construct is valid for a period equal to that of Improvement Permit – not to exceed sixty months.

Signed: Tammy Morris date 5-19-06 Installed by: Kerry Welborn

Improvement Permit by: date 5-18-06 Operation Permit by: date 5-26-06

Authorization to Construct by: date 5-19-06 Existing System Inspection by: date

HEALTH DEPT. COPY: WHITE OWNER COPY (FINAL): YELLOW OWNER COPY (INITIAL): PINK