Not located

IREDELL COUNTY HEALTH DEPARTMENT

STATESVILLE 704-878-5305 MOORESVILLE 704-664-5281

IMPROVEMENT PERMIT / CERTIFICATE OF COMPLETION / OPERATION PERMIT / EXISTING SYSTEM INSPECTION

PROPERTY DESCRIPTION NO. 19915 DATE 1/28/95 TAX MAP NO. 14F-3-A-4 Watershed: ☐ Yes ☒ No

OWNER OR CONTRACTOR JOHNNY S. HARRIS PHONE: Business Home (704) 876-6877

ADDRESS 3328 WILKSBORO HWY STATESVILLE NC 28677

LOCATION NC 115 N. 1st MH ON RIGHT PAST SNOW CREEK ROAD ~ 0.5 MILE,

SUBDIVISION JOHN S. KING, EST BLOCK / SECTION LOT 4 LOT AREA 1.0 ACRE SITE CLASS. P5 DESIGN FLOW 360 L.T.A.R. 0.33 GPD/FT²

Septic Tank: 1000 Gallons; STB 1012 Date 2/3/95

Pump Tank: Gallons; PT Date

Pump Make: Model Serial No.

Nitrification Field: No Fields 1 Square Feet 1080 Linear Feet 360

No Lines 4 Trench Width 36" Max Trench Bottom Depth 18-36" Gravel Depth 12"

☒ New System ☐ Repair System Type: I, II, III, IV, V, VI

System Description: CONVENTIONAL GRAVITY

Repair System Description: CONV. GRAVITY

Maintenance Agreement Required: ☐ Yes ☒ No

☐ House/Mod. Home ☒ Mobile Home ☐ Business ☐ Other

No. Bedrooms 3 No. Bathrooms 2 No. Employees


☐ Slab ☐ Crawl Space ☐ Basement w/plumbing ☐ Basement wo/plumbing

Water Supply: ☒ Individual ☐ Community ☐ Public WELL


Comments: ① KEEP SYSTEM MINIMUM 5' FROM MH, 10' FROM PROPERTY LINE, 100' FROM WELL ② INSTALL LINES ON CONTOUR, NO DEEPER THAN 36" 6' APART ON CENTER

Comments:

INITIAL SITE SKETCH

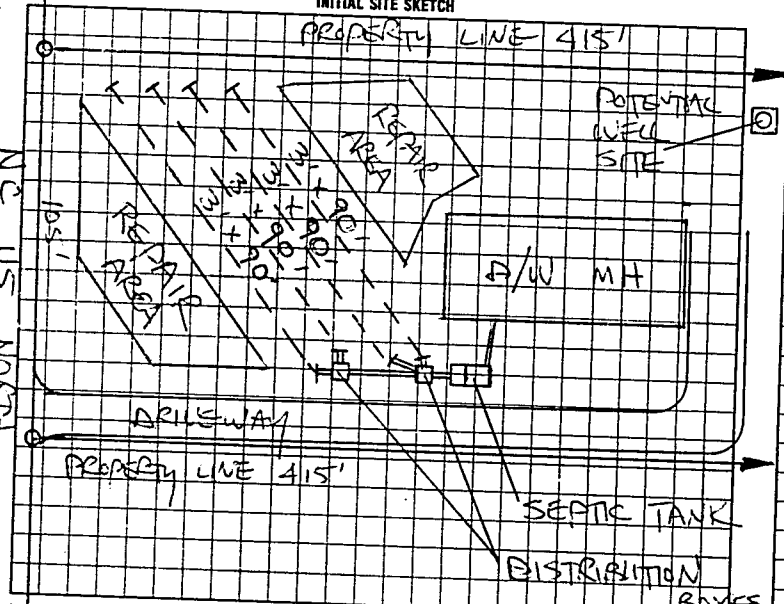

AS BUILT SKETCH

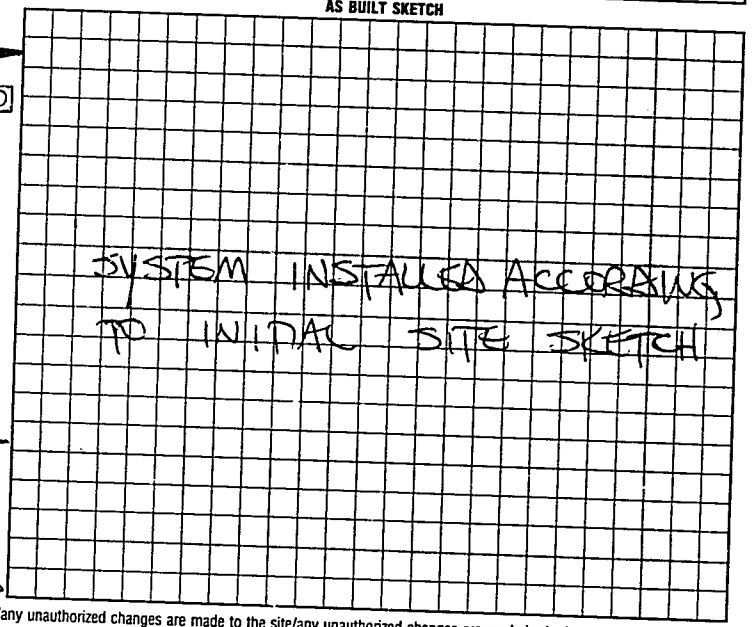

I understand that this permit can be suspended or revoked if any false information is supplied toward securing the permit/any unauthorized changes are made to the site/any unauthorized changes are made in the installation of the system. Improvement Permit is valid for 60 months from date of issuance.

Signed: X

Improvement Permit by: STEVE HEDRICK date 1/28/95

Existing System Inspection by: date

Installed by: ANDY DANIELS

Certificate of Completion by: STEVE HEDRICK date 4/6/95

Operation Permit by date

HEALTH DEPT. COPY: WHITE INSPECTION COPY (FINAL): GREEN OWNER COPY (FINAL): YELLOW INSPECTION COPY (INITIAL): PINK OWNER COPY (INITIAL): GOLD

165000