IREDELL COUNTY HEALTH DEPARTMENT

STATESVILLE 704-878-5305 MOORESVILLE 704-664-5281

IMPROVEMENT PERMIT / CERTIFICATE OF COMPLETION / OPERATION PERMIT / EXISTING SYSTEM INSPECTION

PROPERTY DESCRIPTION NO. 21778 DATE 7-26-95 TAX MAP NO. 14F-3-A-22 Watershed: ☐ Yes ☐ No

OWNER OR CONTRACTOR: W. G. HOPE PHONE: Business Home 592-9191

ADDRESS 5111 WILKESBORO RD, STATESVILLE, NC 28677

LOCATION NC 115 N, TL ESTATE DRIVE, 1ST LOT ON RIGHT

SUBDIVISION JOHN S. KING BLOCK / SECTION LOT 22 LOT AREA 55' x 436' SITE CLASS. PS DESIGN FLOW 240 L.T.A.R. 0.33 GPD/FT²

Septic Tank: 1000 Gallons; STB 1012 Date 5/20/95

Pump Tank: Gallons; PT Date

Pump Make: Model Serial No.

Nitrification Field: No Fields 1 Square Feet 720 Linear Feet 240

No Lines 7 Trench Width 36 Max Trench Bottom Depth 18"-36" Gravel Depth 12"

☑ New System ☐ Repair System Type: I, II, III, IV, V, VI

System Description: CONV. GRAVITY

Repair System Description: CONV. GRAVITY

Maintenance Agreement Required: ☐ Yes ☑ No

☐ House/Mod. Home No. Bedrooms 2

☑ Mobile Home No. Bathrooms 1

☐ Business No. Employees

☐ Other


☐ Slab ☑ Crawl Space ☐ Basement w/plumbing ☐ Basement wo/plumbing

Water Supply: ☑ Individual ☐ Community ☐ Public WELL


Comments: (1) KEEP SYSTEM MINIMUM 100' FROM WELL, 10' FROM PROPERTY LINE (2) INSTALL SEVEN (7) LINES AS SHOWN ON CONTOUR, NO DEEPER THAN 36", 9' MINIMUM APART ON CENTER

Comments: SYSTEM INSTALLED ACCORDING TO INITIAL SITE SKETCH

INITIAL SITE SKETCH

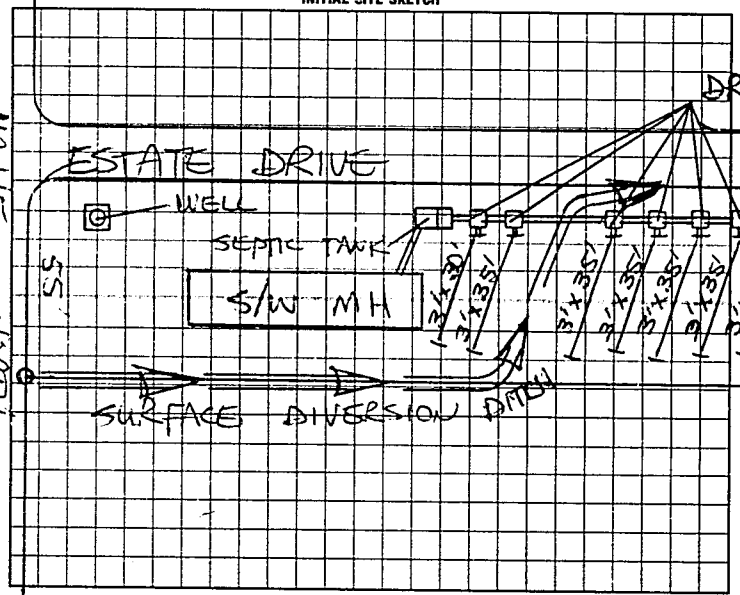

AS BUILT SKETCH

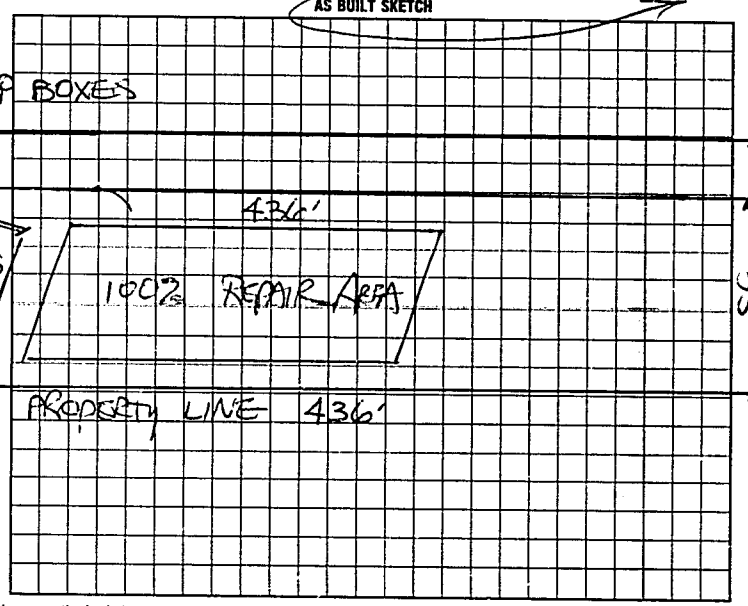

I understand that this permit can be suspended or revoked if any false information is supplied toward securing the permit/any unauthorized changes are made to the site/any unauthorized changes are made in the installation of the system. Improvement Permit is valid for 60 months from date of issuance.

Signed: W. G. Hope

Improvement Permit by: STEVE HENDRICK date 7-26-95

Existing System Inspection by date

Installed by: JEFF HURLBUT, UNION GROVE BACKHOE

Certificate of Completion by: STEVE HENDRICK date 8-22-95

Operation Permit by date

HEALTH DEPT COPY WHITE INSPECTION COPY (FINAL) GREEN OWNER COPY (FINAL) YELLOW INSPECTION COPY (INITIAL) PINK OWNER COPY (INITIAL) GOLD

6 Σ 7 0 0 0