IREDELL COUNTY SOLID WASTE TRANSFER STATION

IREDELL COUNTY HEALTH DEPARTMENT

STATESVILLE 704-878-5305 MOORESVILLE 704-664-5281

IMPROVEMENT PERMIT / AUTHORIZATION TO CONSTRUCT / OPERATION PERMIT / EXISTING SYSTEM INSPECTION

PERMIT# 080823 PIN# 4729 15 5612 DATE 8-2-99

OWNER OR CONTRACTOR IREDELL COUNTY PHONE: Business 878-3054 Home

ADDRESS P.O. BOX 788, STATESVILLE, NC 28687

LOCATION NC 115 NORTH, ~0.3 MILE ON RIGHT PAST SNOW CREEK ROAD

SUBDIVISION BLOCK / SECTION LOT LOT AREA 1.93 ACRES SITE CLASS PS DESIGN FLOW 100 L.T.A.R. 0.30 GPD/FT²

Septic Tank: 1000 Gallons; STB 1007 Date 10-15-99 | ✓ New System | Repair System Type: I (II) III IV V VI | House/Mod. Home | No. Bedrooms | Water Supply: ☐ Individual

Pump Tank: Gallons; PT Date | System Description: CONVENTIONAL GRAVITY | Mobile Home | No. Bathrooms | ✓ Public

Pump Make: Model Serial No. | Repair System Description: CONV. GRAVITY | ✓ Business | No. Employees 1 | ☐ Community


Nitrification Field: No Fields 1 Square Feet 360 Linear Feet 120 | Maintenance Agreement Required: Yes ✓ No | Other

No Lines TWO Trench Width 36" Max Trench Bottom Depth 36" Gravel Depth 12" | ✓ Slab Crawl Space Basement w/plumbing Basement wo/plumbing


Comments/Conditions: INSTALL LINES ON CONTOUR NO DEEPER THAN 36". SCALE: 1"=40'

Comments/Conditions: SEPTIC TANK WITH RISERS AND MARKER INSTALLED USING "ZABEL" FILTER.

INITIAL SITE SKETCH

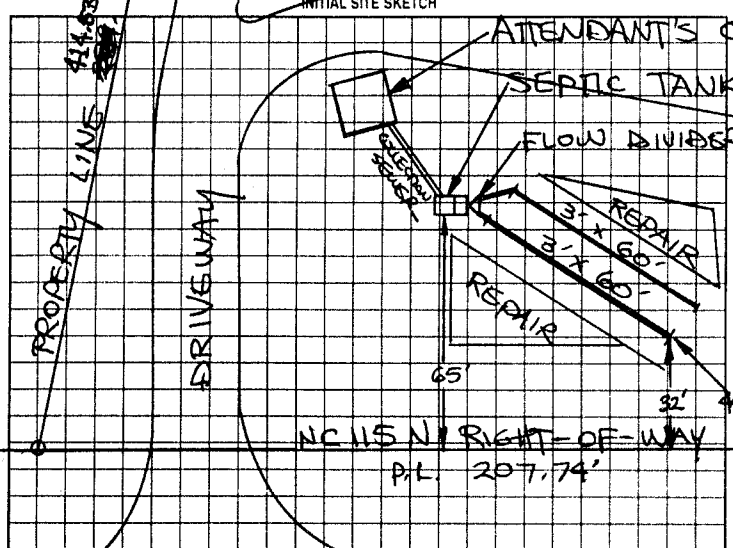

AS BUILT SKETCH

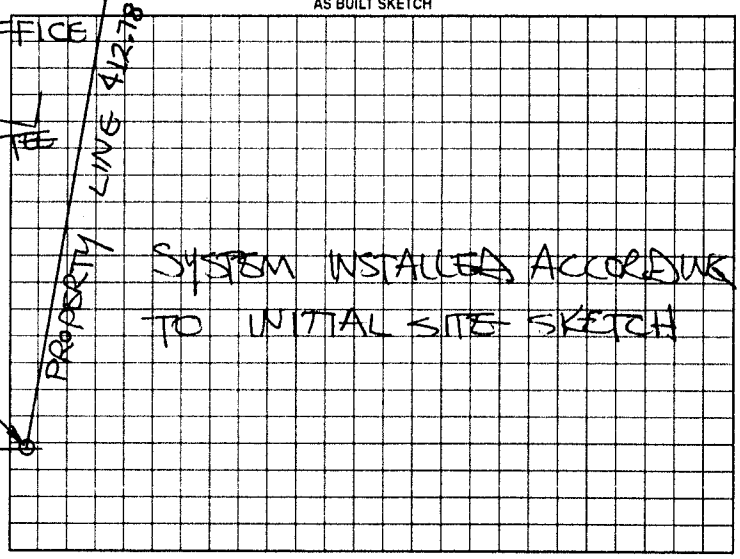

Permit can be suspended or revoked if any false information is supplied toward securing the permit/any unauthorized changes are made to the site/any unauthorized changes are made in the installation of the system. Improvement Permit with plat valid without expiration. Improvement Permit with site plan valid for sixty months. Authorization to Construct is valid for a period equal to that of Improvement Permit – not to exceed sixty months.

Signed: for Iredell Co. date 8-11-99 Installed by: JAMES HUBLER

Improvement Permit by: STEVE HEDRICK date 8-2-99 Operation Permit by: STEVE HEDRICK date 11-30-99

Authorization to Construct by: STEVE HEDRICK date 8-2-99 Existing System Inspection by: date

HEALTH DEPT COPY WHITE OWNER COPY (FINAL) YELLOW OWNER COPY (INITIAL) PINK