ICHD - ENVIRONMENTAL HEALTH DIVISION

Statesville Office (704) 878-5305 (BD) Mooresville Office (704) 660-3625 PERMIT # 2023-35725

SEPTIC: IMPROVEMENT PERMIT / AUTHORIZATION TO CONSTRUCT / OPERATION PERMIT / EXISTING SYSTEM Repair PIN # 4729 -- 15 -- 6930

APPLICANT/OWNER: Betty Tilley APPLICANT ADDRESS: 118 Old Timer Dr, Statesville

SITE ADDRESS: 118 Old Timer Dr, Statesville 28625 PHONE: 704-902-4979 ALT. PHONE -


SITE DIRECTIONS: 115 N - Old Timer SAP CONTROLLED: ☐ ~~YES~~ ☐ ~~NO~~

SUBDIVISION: - SECTION: - LOT # - LOT AREA: 3 acres DESIGN FLOW: EX L.T.A.R.: EX

Septic Tank	1000	(gal)	STB 7600	Date 8/18/23	☐ New System	☒ Repair	☐ Expansion	System Type: I (II) III IV V VI	☒ Residence	No. Bedrooms EX	Water Supply
Pump Tank		(gal)	PT	Date	System Description:	Tank Replacement			☐ Business	No. Persons EX	☒ Private
Pump Make		Model		Serial #	Repair System Description:	EXISTING			☐ Other	No. Employees	☐ Public
# Nitrification Fields	EX	# Lines	EX	Linear Ft EX	Maintenance Agreement Required:	☐ YES	☒ NO		☐ Slab	☐ Crawl Space	☐ Community
Trench Width	EX	Trench Bottom Depth(Low side)	EX	Gravel Depth EX	☒ GRAVITY	☐ PRESSURE			☒ Basement w/plumbing		☐ Basement w/o plumbing

Comments / Conditions: Pump, crush, & fill old tank. Replace distribution Box if necessary.

INITIAL SITE SKETCH

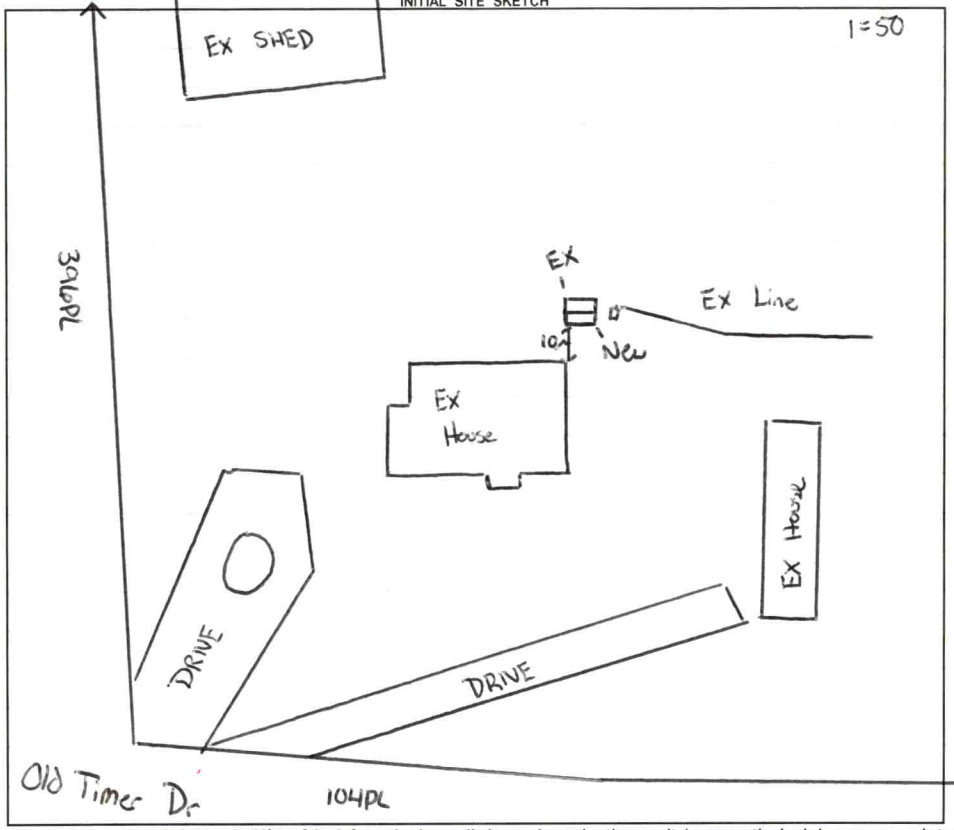

AS BUILT SKETCH

FOR SEPTIC FINAL INSPECTION CALL: 704-664-3703 between 8am-9am the day the inspection is needed. Be sure to speak with an inspector to confirm your time.

AS DRAWN

Permit can be suspended or revoked if any false information is supplied toward securing the permit / any unauthorized changes are made to the site / any unauthorized changes are made in the installation of the system. **CONTACT A LOCATOR SERVICE PRIOR TO ANY EXCAVATION**

☐ **IMPROVEMENT PERMIT** ***with plat*** *valid without expiration.* ☒ **IMPROVEMENT PERMIT** ***with site plan*** *valid for 60 mos.* ☒ **AUTHORIZATION TO CONSTRUCT** *valid for period equal to IMPROVEMENT PERMIT--not to exceed 60 mo.*

Owner / Applicant Signature: Online Signature Date: Installed by: Neil Stutts

IMPROVEMENT PERMIT by: Cory Hill Date: 9/8/23 OPERATION PERMIT by: Sarah Williams Date: 10/4/2023

AUTHORIZATION TO CONSTRUCT by: Cory Hill Date: 9/8/23 Existing System Inspected by: Date:

FOR SEPTIC FINAL INSPECTION: CALL 704-664-3703 between 8am-9am the day the inspection is needed.

Item	Date	Initials
Drain Lines Checked		
Tanks Checked		
Pressure Manifold or Valve Box Checked		
Pressure Head Set		
Electrical Checked		
Floats Set		
Alarm Checked		
Maintenance Contract Needed? Y / N		
Comments:		

Repairs Only	
	State Code
Failing System Code	
Type of Distribution	G or P
Type of Failure/Malfunction	
Primary Cause of Failure/Malfunction	
Age of System? _____	
Initial or Repair? _____	




IREDELL COUNTY, NC

MAP FOR REFERENCE ONLY
NOT A LEGAL DOCUMENT

Iredell County, North Carolina makes no claims and no warranties, expressed or implied, concerning the validity or accuracy of the GIS data presented on this map.

Geometry updated 06/05/2023
Data updated 08/29/2023

Print map scale is approximate. Critical layout or measurement activities should not be done using this resource.

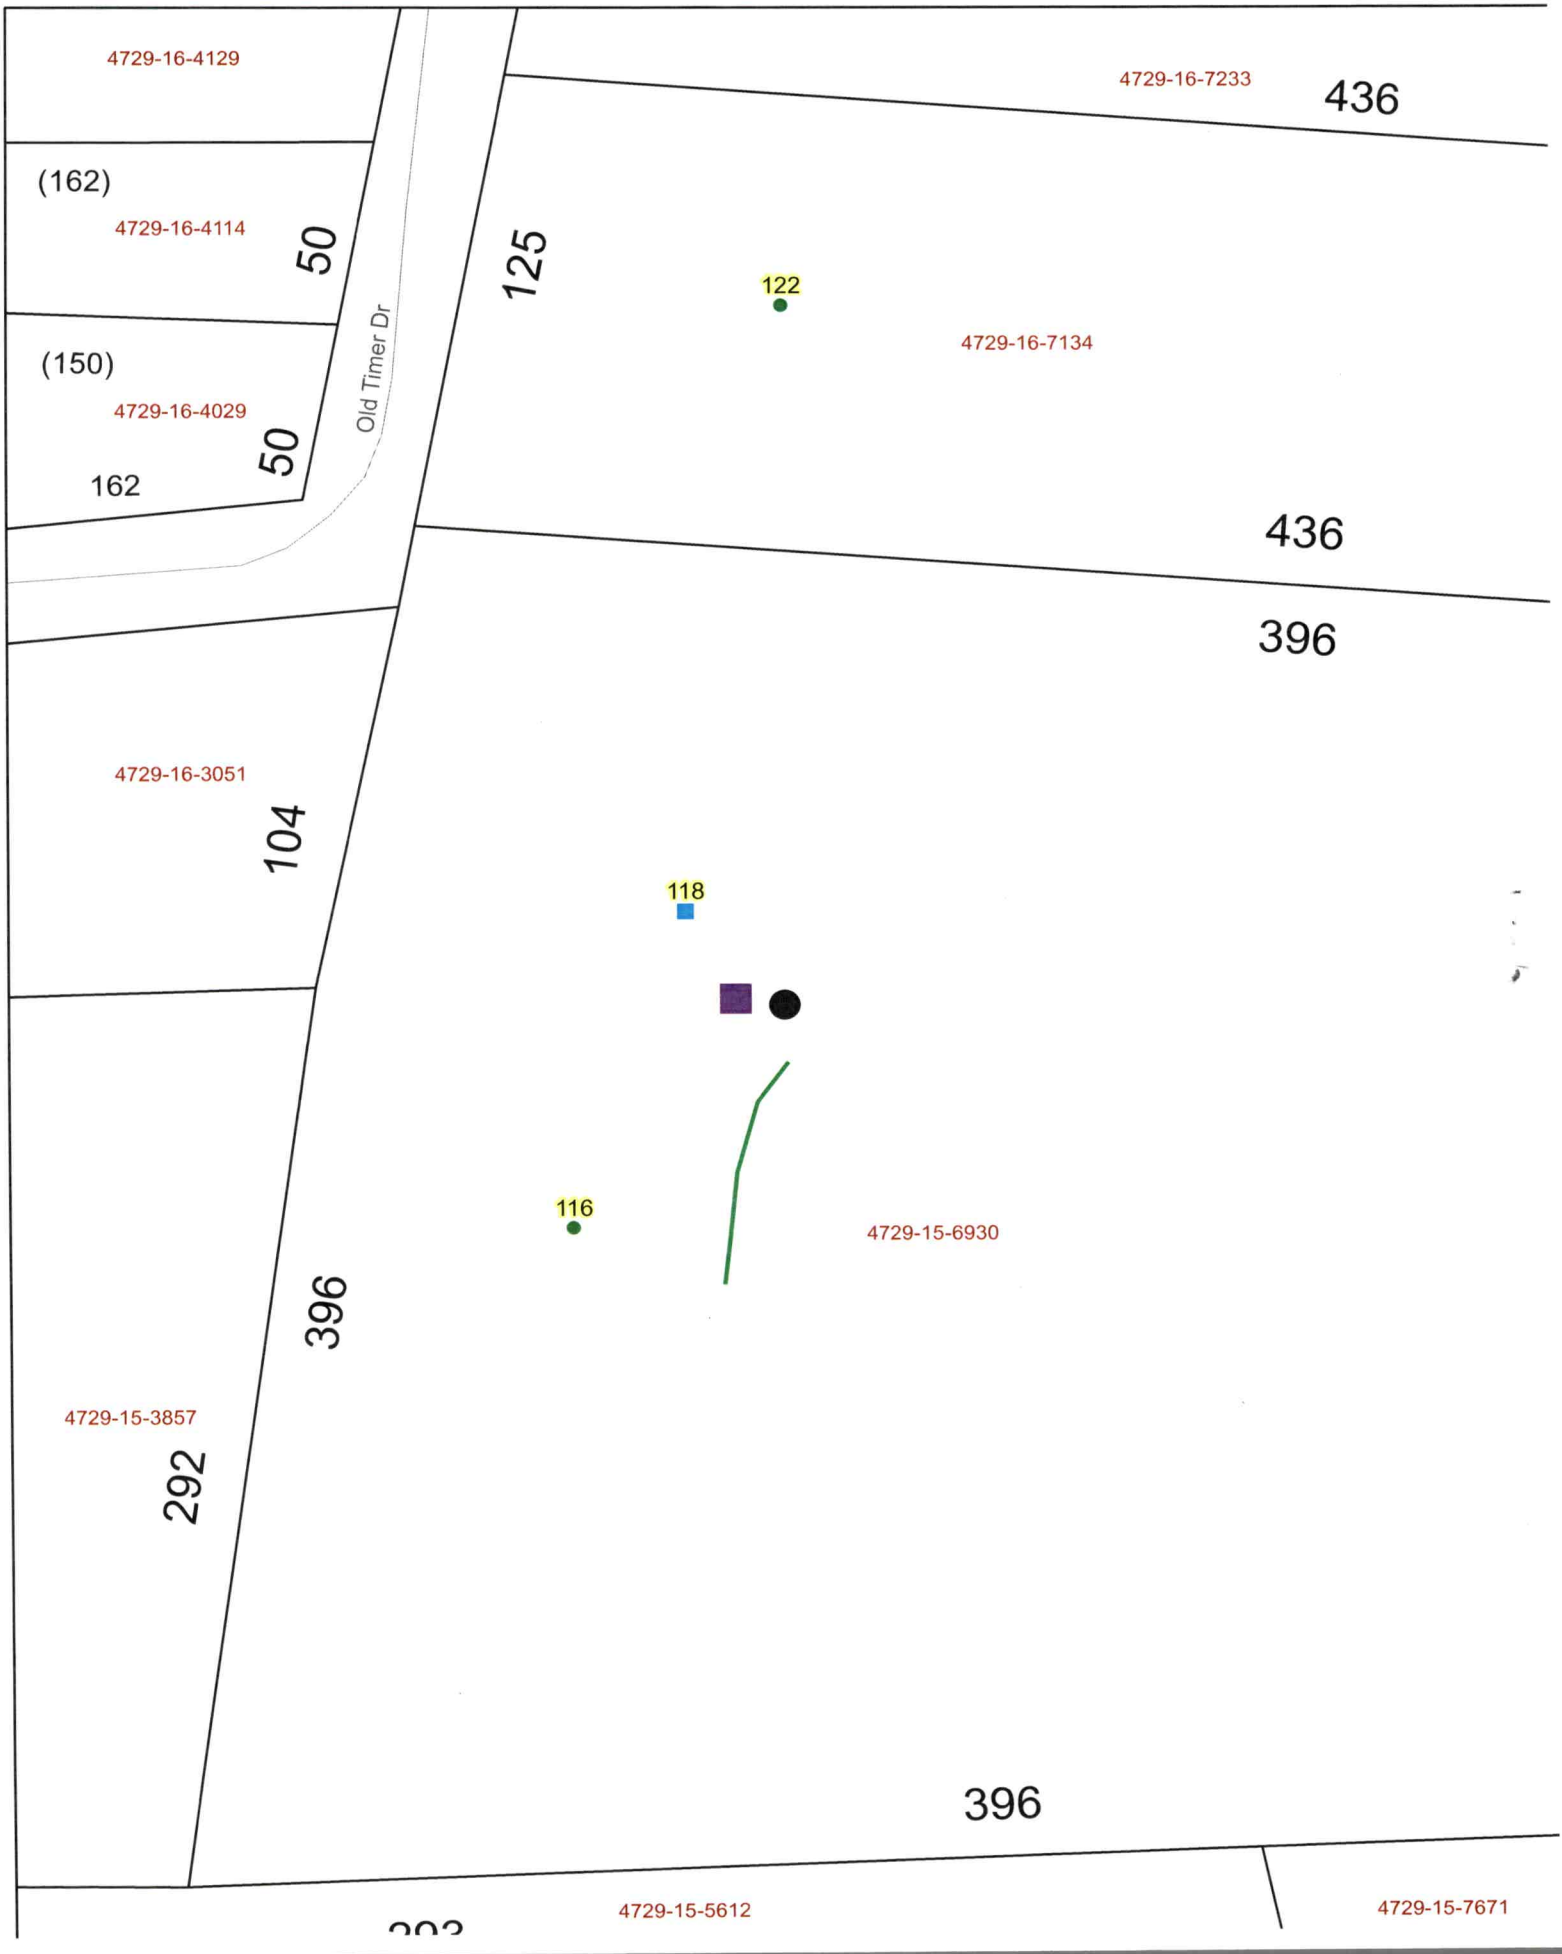
4729-16-4129
4729-16-7233
436
(162)
4729-16-4114
50
125
122
4729-16-7134
Old Timer Dr
(150)
4729-16-4029
50
162
436
396
4729-16-3051
104
118
116
4729-15-6930
396
4729-15-3857
292
396
4729-15-5612
4729-15-7671