IREDELL COUNTY HEALTH DEPARTMENT

STATESVILLE 704-878-5305 MOORESVILLE 704-664-5281

IMPROVEMENT PERMIT / AUTHORIZATION TO CONSTRUCT / OPERATION PERMIT / EXISTING SYSTEM INSPECTION

PERMIT# 113293 PIN# 4729-27-3708 DATE 6-24-03

OWNER OR CONTRACTOR JAMES F. WILSON PHONE: Business Home 704-782-4651

ADDRESS 113 SPENCER AVE N/W, CONCORD, NC 28025

LOCATION NC 115 NORTH ON RIGHT BETWEEN HAM'S GROVE ROAD & WILSON FARM ROAD

SUBDIVISION BLOCK / SECTION LOT LOT AREA 48.485 ACRES SITE CLASS. PS DESIGN FLOW 240 L.T.A.R. 0.30 GPD/FT²

Septic Tank: 1000 Gallons; STB 1012 Date 8-30-03
Pump Tank: Gallons; PT Date
Pump Make: Model Serial No.
Nitrification Field: No Fields 1 Square Feet 810 Linear Feet 270
No Lines THREE Trench Width 36" Max Trench Bottom Depth 36" Gravel Depth 12"

☑ New System ☐ Repair System Type: I, II, III, IV, V, VI
System Description: CONVENTIONAL, GRAVITY
Repair System Description: CONVENTIONAL, GRAVITY
Maintenance Agreement Required: ☐ Yes ☑ No


☐ House/Mod. Home No. Bedrooms 2
☐ Mobile Home No. Bathrooms 2
☐ Business No. Employees
☐ Other
☐ Slab ☑ Crawl Space ☐ Basement w/plumbing ☐ Basement wo/plumbing

Water Supply: ☐ Individual ☑ Public ☐ Community

Comments:/Conditions: INSTALL DRAINLINES ON CONTOUR AS FLAGGED

Comments:/Conditions: ① TUFF-TITE FILTER ② #5 STONE ③ SLIGHT ALTERATIONS MADE TO SKETCH

INITIAL SITE SKETCH

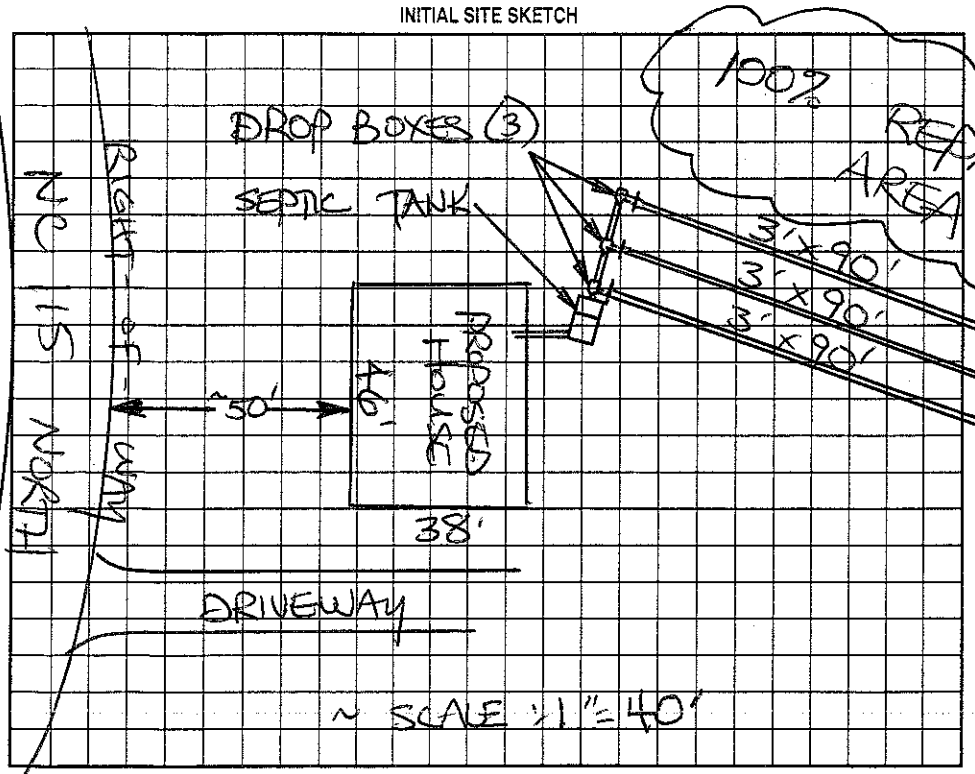

AS BUILT SKETCH

Permit can be suspended or revoked if any false information is supplied toward securing the permit/any unauthorized changes are made to the site/any unauthorized changes are made in the installation of the system. Improvement Permit with plat valid without expiration. Improvement Permit with site plan valid for sixty months. Authorization to Construct is valid for a period equal to that of Improvement Permit – not to exceed sixty months.

Signed: T.C. Lloyd Wilson date 6/24/2003 Installed by: Dale Fox Grading

Improvement Permit by: STEVE HEDRICK date 6-24-03 Operation Permit by: Christopher M. Shevill, R.S. date 2-23-04

Authorization to Construct by: STEVE HEDRICK date 6-24-03 Existing System Inspection by: date

HEALTH DEPT. COPY: WHITE OWNER COPY (FINAL): YELLOW OWNER COPY (INITIAL): PINK