047448

IREDELL COUNTY HEALTH DEPARTMENT

STATESVILLE 704-878-5305 MOORESVILLE 704-664-5281

IMPROVEMENT PERMIT / CERTIFICATE OF COMPLETION / OPERATION PERMIT / EXISTING SYSTEM INSPECTION

PROPERTY DESCRIPTION NO. 20564 DATE 3/22/95 TAX MAP NO. 14F-A-66 Watershed: ☐ Yes ☒ No

OWNER OR CONTRACTOR CLARENCE T. CLODFELTER PHONE: Business Home 876-0845 WSIV

ADDRESS 3650 WILKESBORO HWY, STATESVILLE NC 28677

LOCATION NC 115 N, LAST LOT ON RIGHT BEFORE FORD FARM ROAD

SUBDIVISION BLOCK / SECTION LOT LOT AREA 3.52 AC SITE CLASS. PS DESIGN FLOW 360 L.T.A.R. 0.30 GPD/FT²

Septic Tank: 1000 Gallons; STB 794 Date 2-28-95 ☒ New System ☐ Repair System Type: I, II, III, IV, V, VI

Pump Tank: Gallons; PT Date System Description: CONVENTIONAL GRAVITY

Pump Make: Model Serial No. Repair System Description: CONV. GRAVITY

Nitrification Field: No Fields 1 Square Feet 1600 Linear Feet 400 Maintenance Agreement Required: ☐ Yes ☒ No

No Lines 3 Trench Width 36" Max Trench Bottom Depth 28-36" Gravel Depth 12

☒ House/Mod. Home No. Bedrooms 3
☐ Mobile Home No. Bathrooms 2
☐ Business No. Employees
☐ Other


☐ Slab ☐ Crawl Space ☐ Basement w/plumbing ☒ Basement wo/plumbing

Water Supply: ☒ Individual ☐ Community ☐ Public WELL

Comments: ① KEEP SYSTEM MINIMUM 15' FROM BASEMENT DRAIN ② INSTALL LINES ON CONTOUR, NO DEEPER THAN 36", 9' MINIMUM ON CENTERS

Comments: Basement was not installed all crawl space

INITIAL SITE SKETCH

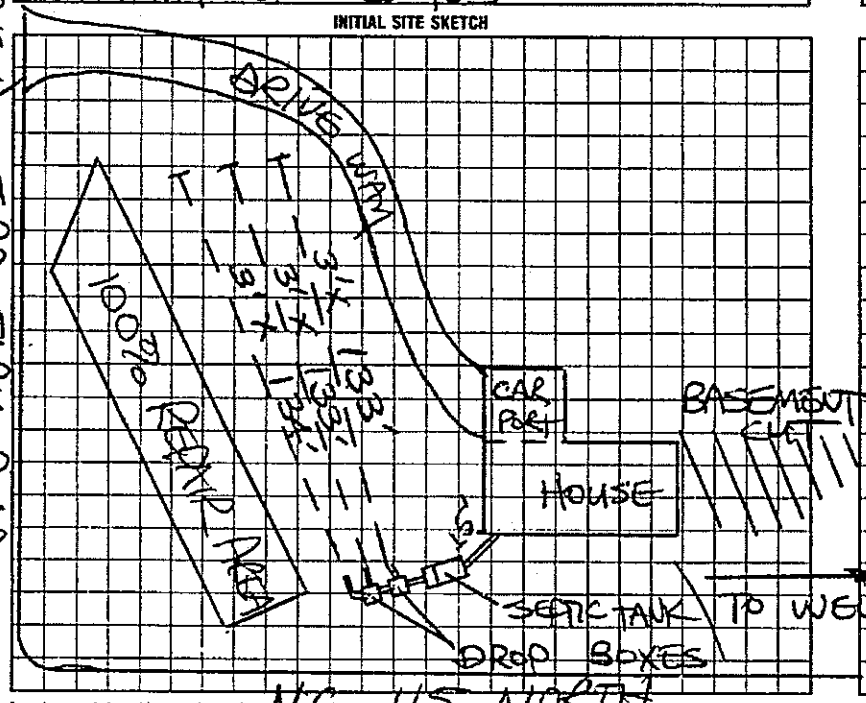

AS BUILT SKETCH

The location of the proposed metal carport addition does not appear to impact the existing septic system.

**NOTE: REHS

Date: 30 Nov 10

ICHD-Environmental Health Division

Same as initial sketch

I understand that this permit can be suspended or revoked if any false information is supplied toward securing the permit/any unauthorized changes are made to the site/any unauthorized changes are made in the installation of the system. Improvement Permit is valid for 60 months from date of issuance.

Signed: Clarence Clodfelter

Improvement Permit by: STEVE FREDRICK date 3/22/95

Existing System Inspection by: date

Installed by: wes Eaton

Certificate of Completion by: date

Operation Permit by: T. C. moore date 4-4-96

HEALTH DEPT COPY WHITE INSPECTION COPY (FINAL) GREEN OWNER COPY (FINAL) YELLOW INSPECTION COPY (INITIAL) PINK OWNER COPY (INITIAL) GOLD

256200