IREDELL COUNTY HEALTH DEPARTMENT

STATESVILLE 704-878-5305 MOORESVILLE 704-664-5281

IMPROVEMENT PERMIT / AUTHORIZATION TO CONSTRUCT / OPERATION PERMIT / EXISTING SYSTEM INSPECTION

PERMIT# 080330 PIN# 4729 25 0152 DATE 4-5-99

OWNER OR CONTRACTOR JOHNNY HARRIS PHONE: Business Home 876-4747

ADDRESS 3880 WILKESBORO HIGHWAY STATESVILLE, NC 28625-1286

LOCATION NC 115 NORTH, 1ST DRIVE ON RIGHT PAST SNOW CREEK ROAD, BACK OFF ROAD 450 FEET

SUBDIVISION J.S. KING EST BLOCK / SECTION LOT 3 LOT AREA 4.6 ACRES SITE CLASS PS DESIGN FLOW 360 L.T.A.R. 0.30 GAB/FT

Septic Tank: 1000 Gallons; STB 786 Date 9-22-99
Pump Tank: Gallons; PT Date
Pump Make: Model Serial No.
Nitrification Field: No Fields 1 Square Feet 1200 Linear Feet 400
No Lines FIVE Trench Width 36" Max Trench Bottom Depth 36" Gravel Depth 12"

☑ New System ☐ Repair System Type: I (II) III IV V VI
System Description: CONVENTIONAL GRAVITY
Repair System Description: CONV. GRAVITY/PUMP
Maintenance Agreement Required: ☐ Yes ☑ No
☐ Slab ☑ Crawl Space ☐ Basement w/plumbing ☐ Basement wo/plumbing

☐ House/Mod. Home No. Bedrooms 3
☑ Mobile Home No. Bathrooms 2
☐ Business No. Employees
☐ Other


Water Supply: ~~Individual~~ ☑ Public OR ☐ Community WELL

Comments/Conditions: KEEP SYSTEM MINIMUM 100 FEET FROM WELL


Comments/Conditions: SEPTIC TANK WITH MARKER INSTALLED USING "POLYLOK" FILTER

SCALE: 1" = 40'

INITIAL SITE SKETCH

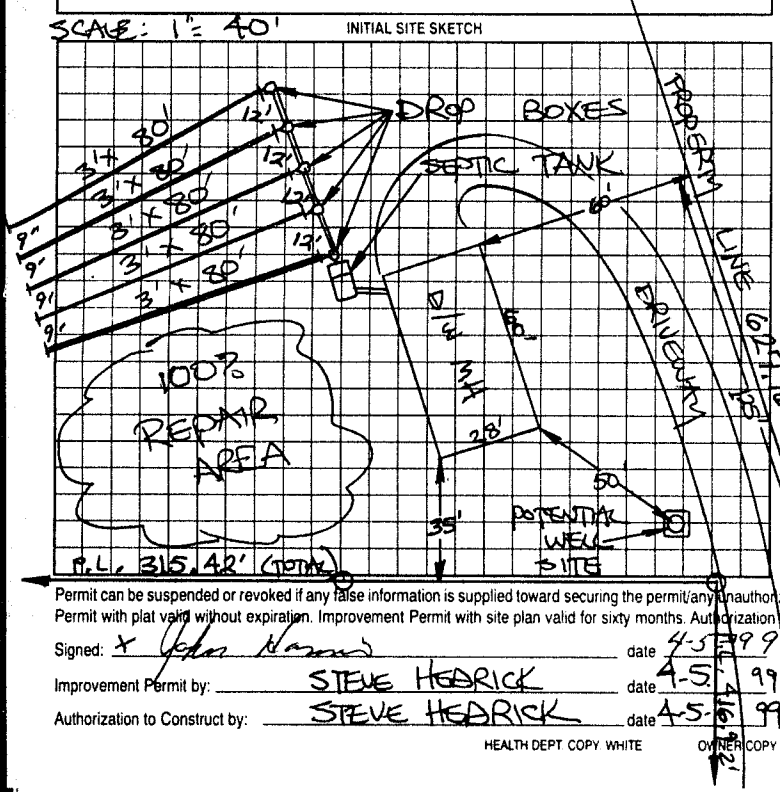

AS BUILT SKETCH

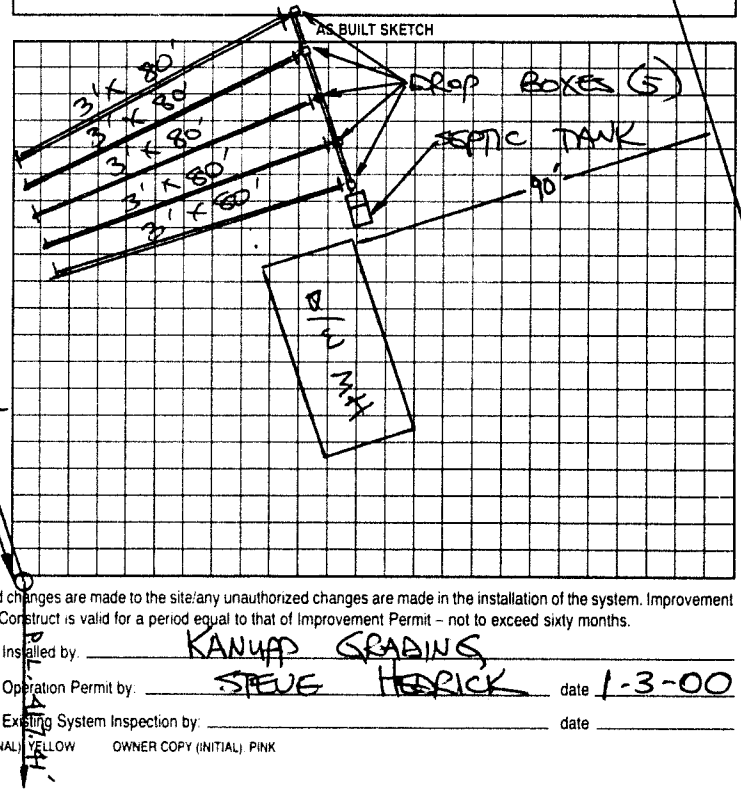

Permit can be suspended or revoked if any false information is supplied toward securing the permit/any unauthorized changes are made to the site/any unauthorized changes are made in the installation of the system. Improvement Permit with plat valid without expiration. Improvement Permit with site plan valid for sixty months. Authorization to Construct is valid for a period equal to that of Improvement Permit – not to exceed sixty months.

Signed: [signature] date 4-5-99 Installed by: KANUPP GRADING

Improvement Permit by: STEVE HEDRICK date 4-5-99 Operation Permit by: STEVE HEDRICK date 1-3-00

Authorization to Construct by: STEVE HEDRICK date 4-5-99 Existing System Inspection by: date

HEALTH DEPT COPY WHITE OWNER COPY (FINAL) YELLOW OWNER COPY (INITIAL) PINK