IREDELL COUNTY HEALTH DEPARTMENT

STATESVILLE 704-878-5305 MOORESVILLE 704-664-5281

IMPROVEMENT PERMIT / AUTHORIZATION TO CONSTRUCT / OPERATION PERMIT / EXISTING SYSTEM INSPECTION

PERMIT# 08234 PIN# 4729 46 3809 (PT) DATE 7-8-99

OWNER OR CONTRACTOR DALE FOX PHONE: Business Home 876-4657

ADDRESS 139 WESTON DAIRY ROAD, STATESVILLE, NC 28625

LOCATION NC 115 N, TR HAMS GROVE ROAD, TL WILSON FARM RD, 1ST LOT ON LEFT

SUBDIVISION BLOCK / SECTION LOT LOT AREA 3.8 ACRES SITE CLASS PS DESIGN FLOW 360 L.T.A.R. 0.40 gpd/ft²

Septic Tank: 1000 Gallons; STB 1012 Date 5-21-99
Pump Tank: Gallons; PT Date
Pump Make: Model Serial No.
Nitrification Field: No Fields 1 Square Feet 900 Linear Feet 300
No Lines THREE Trench Width 36" Max Trench Bottom Depth 36" Gravel Depth 12"

☑ New System ☐ Repair System Type: I II III IV V VI
System Description: CONVENTIONAL GRAVITY
Repair System Description: CONV. GRAVITY
Maintenance Agreement Required: ☐ Yes ☑ No
☐ Slab ☑ Crawl Space ☐ Basement w/plumbing ☐ Basement wo/plumbing


☐ House/Mod. Home No. Bedrooms 3
☑ Mobile Home No. Bathrooms 2
☐ Business No. Employees
☐ Other

Water Supply: ☐ Individual ☑ Public ☐ Community


Comments/Conditions:
SCALE: 1" = 50'

Comments/Conditions:
Note * Used Drop Boxes. Risers need to be at grade

INITIAL SITE SKETCH

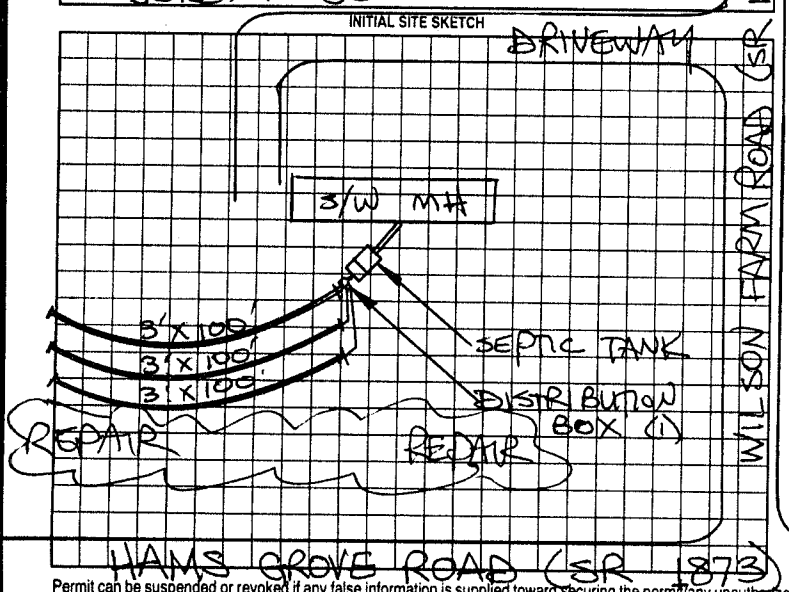

AS BUILT SKETCH

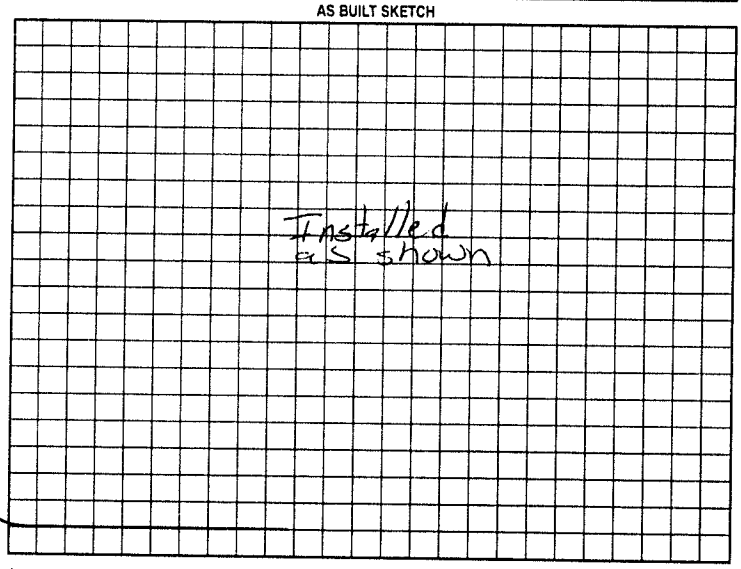

Permit can be suspended or revoked if any false information is supplied toward securing the permit/any unauthorized changes are made to the site/any unauthorized changes are made in the installation of the system. Improvement Permit with plat valid without expiration. Improvement Permit with site plan valid for sixty months. Authorization to Construct is valid for a period equal to that of Improvement Permit – not to exceed sixty months.

Signed: date 7-8-99

Improvement Permit by: STEVE HEDRICK date 7-8-99

Authorization to Construct by: STEVE HEDRICK date 7-8-99

Installed by: Dale Fox

Operation Permit by: date 7-28-99

Existing System Inspection by: date

HEALTH DEPT COPY: WHITE OWNER COPY (FINAL): YELLOW OWNER COPY (INITIAL): PINK