IREDELL COUNTY HEALTH DEPARTMENT

STATESVILLE 704-878-5305 MOORESVILLE 704-664-5281

IMPROVEMENT PERMIT / CERTIFICATE OF COMPLETION / OPERATION PERMIT / EXISTING SYSTEM INSPECTION

PROPERTY DESCRIPTION NO. 069159 DATE 9-4-97 TAX MAP NO. 4729397145 Watershed: ☐ Yes ☒ No

OWNER OR CONTRACTOR TONY R. WILSON PHONE: Business Home 876-0128

ADDRESS 293 WILSON FARM ROAD STATESVILLE, NC 28625

LOCATION NC115 N, TR WILSON FARM ROAD PAST 3RD HOUSE ON LEFT

SUBDIVISION BLOCK / SECTION LOT LOT AREA 84.19 ACRES SITE CLASS. PS DESIGN FLOW 360 L.T.A.R. 0.336 GAL/FT²

Septic Tank: 1000 Gallons; STB 1072 Date 3-16-01

Pump Tank: Gallons; PT Date

Pump Make: Model Serial No.

Nitrification Field: No Fields 1 Square Feet 1080 Linear Feet 360

No Lines THREE Trench Width 36" Max Trench Bottom Depth 36" Gravel Depth 12"

☒ New System ☐ Repair System Type: I, II, III, IV, V, VI

System Description: CONVENTIONAL GRAVITY

Repair System Description: CONV. GRAVITY

Maintenance Agreement Required: ☐ Yes ☒ No

☒ House/Mod. Home No. Bedrooms 3

☐ Mobile Home No. Bathrooms 1

☐ Business No. Employees

☐ Other


☐ Slab ☒ Crawl Space ☐ Basement w/plumbing ☐ Basement wo/plumbing

Water Supply: ☒ Individual ☐ Community ☐ Public WELL

Comments: KEEP SYSTEM MINIMUM 100' FROM WELL

Comments: - Installed Septic Tank Risers
- Septic Tank Marker Installed
- Poly Lok Filter Installed

INITIAL SITE SKETCH SCALE: 1" = 40'

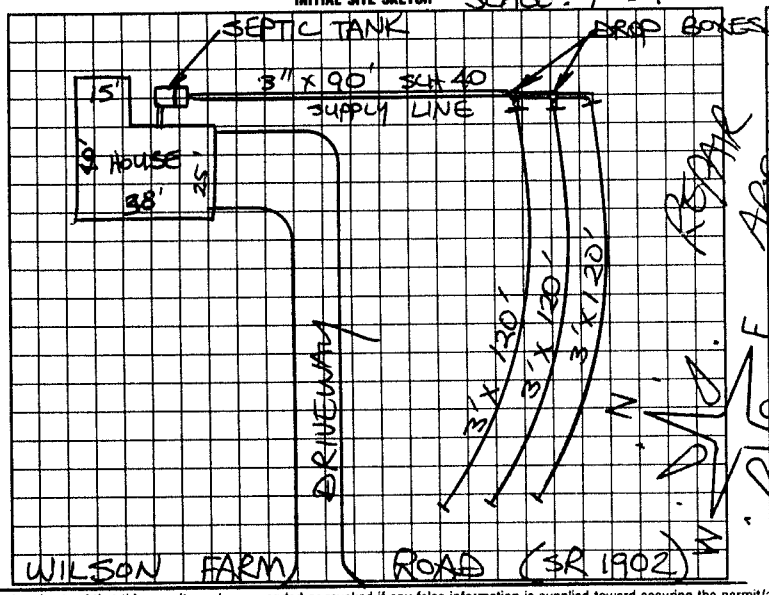

AS BUILT SKETCH

Installed as per Initial Site Sketch

I understand that this permit can be suspended or revoked if any false information is supplied toward securing the permit/any unauthorized changes are made to the site/any unauthorized changes are made in the installation of the system. Improvement Permit is valid for 60 months from date of issuance. AUTHORIZATION TO CONSTRUCT IS VAUD FOR 60 MONTHS FROM DATE OF ISSUANCE.

Signed: Tony R Wilson

Improvement Permit by: STEVE HEDRICK date 9-4-97

Authorization to Construct by: STEVE HEDRICK date 9-4-97

Installed by: Cothran Backhoe

Certificate of Completion by: William G Johnson date 2/24/01

Operation Permit by: date

HEALTH DEPT. COPY: WHITE INSPECTION COPY (FINAL): GREEN OWNER COPY (FINAL): YELLOW INSPECTION COPY (INITIAL): PINK OWNER COPY (INITIAL): GOLD