IREDELL COUNTY HEALTH DEPARTMENT

Statesville Office (704) 878-5305 Mooresville Office (704) 660-3625

PERMIT # 211248

IMPROVEMENT PERMIT / AUTHORIZATION TO CONSTRUCT / OPERATION PERMIT / EXISTING SYSTEM

PIN # 4729-42-7489

APPLICANT: Jerry Mishoe

APPLICANT ADDRESS: 1044 Snow Creek Rd, Statesville

SITE ADDRESS: 1084 Snow Creek Rd

PHONE: 704-876-4603 ALT. PHONE:

SITE DIRECTIONS: Hwy 115 N, TR on Snow Creek, Property Approx. 0.60 mi. Lt S

SUBDIVISION: SECTION: LOT # LOT AREA: 6.822 ac DESIGN FLOW: 240 L.T.A.R.: 0.15 (i) 0.075(A)

Septic Tank	1000 (gal)	STB 766-1000	Date 1-5		
Pump Tank	(gal)	PT	Date		
Pump Make		Model	Serial #		
# Nitrification Fields	1	# Lines 5	Linear Ft: 400		
Trench Width	36"	Max. Trench Bottom Depth * 15" *	Gravel Depth N/A		

☑ New System ☐ Repair ☐ Expansion System Type: I II III IV V VI

System Description: Gravity 25% Reduction

Repair System Description: TSF Drip Irrigation

Maintenance Agreement Required: ☐ YES ☑ NO

☑ GRAVITY ☐ PRESSURE

☑ Residence ☐ Business ☐ Other ☐ Slab ☐ Basement w/plumbing


No. Bedrooms 3 No. Persons 4 No. Employees

☑ Crawl Space ☐ Basement w/o plumbing

Water Supply: ☐ Private ☑ Public ☐ Community

Comments / Conditions: * INSTALL TRENCHES 15" DEEP, A MINIMUM OF 3" SUITABLE COVER TO BE BROUGHT IN TO MAINTAIN A MINIMUM OF 6" REQUIRED, 10-12" RECOMMENDED

INITIAL SITE SKETCH

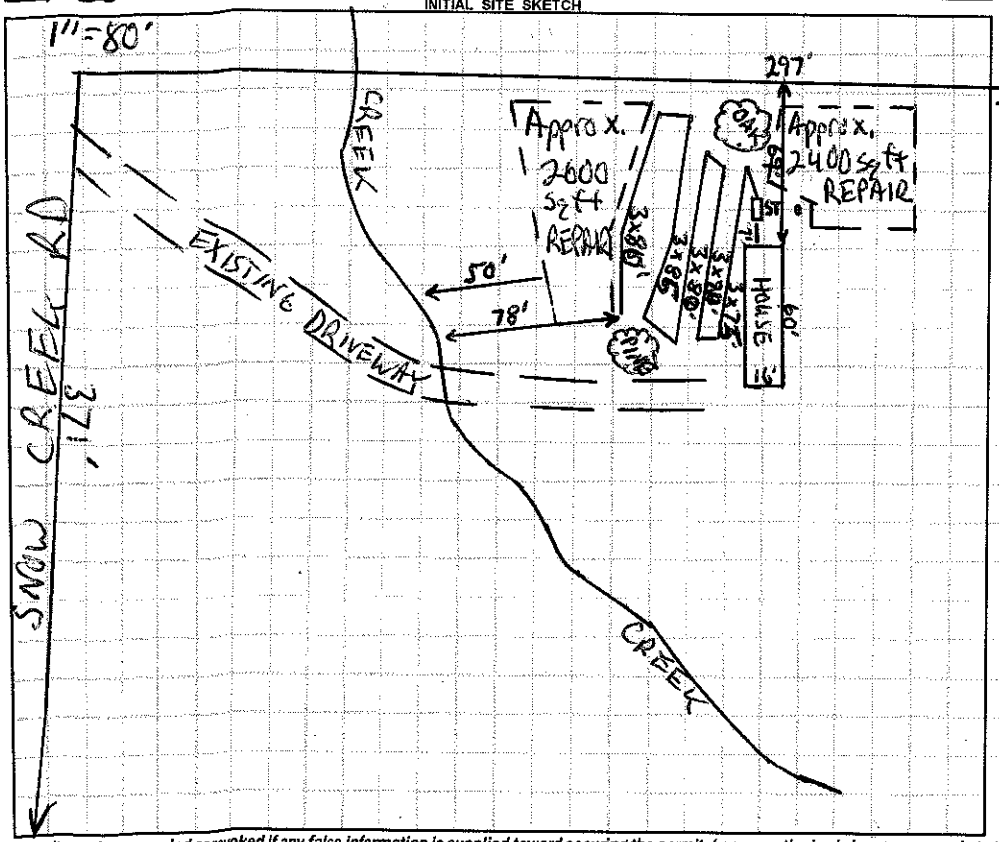

AS BUILT SKETCH

- Red Polylok filter installed
- B10A36 Chambers installed
- Installed as drawn
- ~9"-13" Cover spread evenly over entire system area

Permit can be suspended or revoked if any false information is supplied toward securing the permit / any unauthorized changes are made to the site / any unauthorized changes are made in the installation of the system. CONTACT A LOCATOR SERVICE PRIOR TO ANY EXCAVATION

☐ IMPROVEMENT PERMIT *with plat* valid without expiration. ☑ IMPROVEMENT PERMIT *with site plan* valid for 60 mos. ☑ AUTHORIZATION TO CONSTRUCT valid for period equal to IMPROVEMENT PERMIT--not to exceed 60 mo.

Owner / Applicant Signature: Jerry O Mishoe Jr Date:

Installed by: Tim Abee

IMPROVEMENT PERMIT by: Date: 10-13-15

OPERATION PERMIT by: Justin Mendelson Date: 3-31-16

AUTHORIZATION TO CONSTRUCT by: Date: 10-13-15

Existing System Inspected by: Date:

Health Dept. Copy - WHITE Applicant (Final Approval) - YELLOW Applicant (Conditional Approval) - PINK