IREDELL COUNTY HEALTH DEPARTMENT

STATESVILLE 704-878-5305 MOORESVILLE 704-664-5281

IMPROVEMENT PERMIT / CERTIFICATE OF COMPLETION / OPERATION PERMIT / EXISTING SYSTEM INSPECTION

PROPERTY DESCRIPTION NO. 25428 DATE 6-14-97 TAX MAP NO. 146A-30 Pt. Watershed: ☑ Yes ☐ No

OWNER OR CONTRACTOR Randy Bridges PHONE: Business Home 8761337 W3IV PA

ADDRESS 991 Snow Creek Rd

LOCATION 21N Th Jennings Rd Th Snow Creek 4mi left

SUBDIVISION BLOCK / SECTION LOT LOT AREA 1acre+ SITE CLASS. PS DESIGN FLOW 368 L.T.A.R. .13

Septic Tank: 1000 Gallons; STB 1012 Date 6-24-97

Pump Tank: Gallons; PT Date

Pump Make: Model Serial No.

Nitrification Field: No Fields 1 Square Feet 900 Linear Feet 300

No Lines 5 Trench Width 36" Max Trench Bottom Depth 24" Gravel Depth N/A

☑ New System ☐ Repair System Type: I, II, III, IV, V, VI

System Description: Gravity Chambers

Repair System Description: " "

Maintenance Agreement Required: ☐ Yes ☐ No

☐ Slab ☐ Crawl Space ☐ Basement w/plumbing ☐ Basement wo/plumbing

☐ House/Mod. Home No. Bedrooms 3

☑ Mobile Home No. Bathrooms 2

☐ Business No. Employees

☐ Other

Water Supply: ☑ Individual ☐ Community ☐ Public


Comments:

Replaces Permit issued 6-[illegible]


11-18-96 Home location changed

Comments:

INITIAL SITE SKETCH

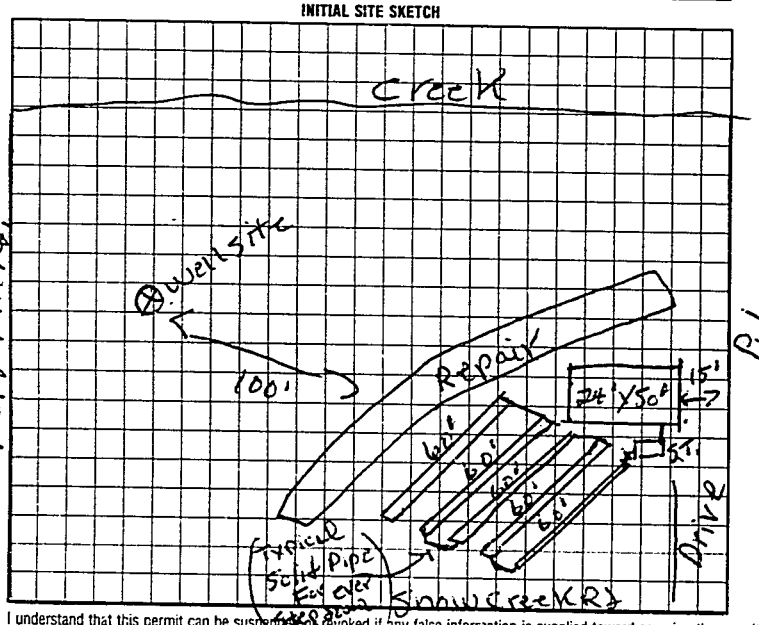

AS BUILT SKETCH

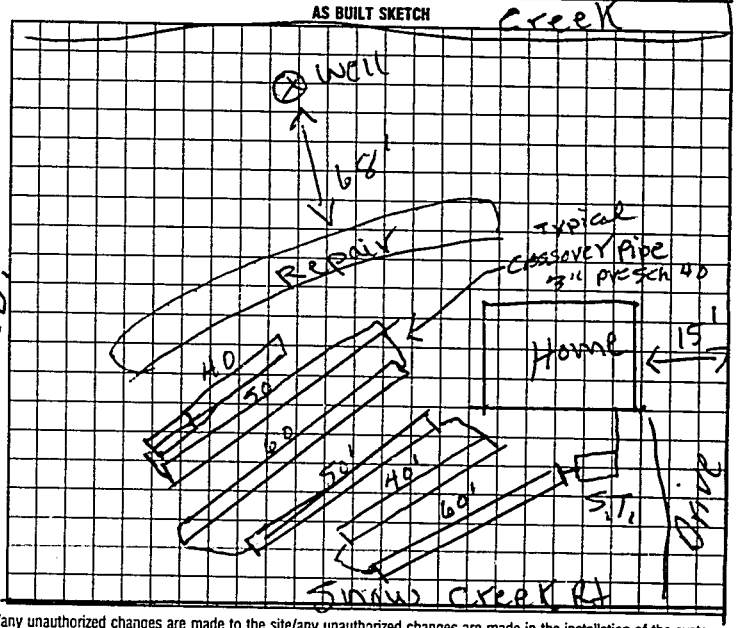

I understand that this permit can be suspended or revoked if any false information is supplied toward securing the permit/any unauthorized changes are made to the site/any unauthorized changes are made in the installation of the system. Improvement Permit is valid for 60 months from date of issuance.

Signed: Randy Bridges

Improvement Permit by: P.C. Moore date 6-14-97

Existing System Inspection by: P.C. Moore date 6-14-97

Authorization to cont.

Installed by: Kenny Madison

Certificate of Completion by: date

Operation Permit by: P.C. Moore date 8-28-97

Authorization to Count Expires 60 mos from issue

HEALTH DEPT COPY WHITE INSPECTION COPY (FINAL) GREEN OWNER COPY (FINAL) YELLOW INSPECTION COPY (INITIAL) PINK OWNER COPY (INITIAL) GOLD

0 0 3 1 8 2