IREDELL COUNTY HEALTH DEPARTMENT

STATESVILLE 704-878-5305 MOORESVILLE 704-664-5281

IMPROVEMENT PERMIT / AUTHORIZATION TO CONSTRUCT / OPERATION PERMIT / EXISTING SYSTEM INSPECTION

PERMIT # 161357 PIN # 4729-69-4856 DATE 16 June 10

OWNER or APPLICANT Leon Clem PHONE: Business (704) 876-6690 Home:

OWNER or APPLICANT ADDRESS 196 Grant Road Statesville, NC

LOCATION / DIRECTIONS 115N TR Harris Grove Rd. TL Grant Rd. in Rt.

SUBDIVISION BLOCK / SECTION LOT # LOT AREA 2 ac. DESIGN FLOW 360 gpd L.T.A.R. 0.4/FH

Exist.

Septic Tank 1000 Gallons: STB Date

Pump Tank Gallons: PT Date

Pump Make Model Serial #

Nitrification Field No Fields No Lines Linear Feet 300

Trench Width Max. Trench Bottom Depth Gravel Depth 12"

☐ New System ☐ Repair ☐ Expansion System Type I II III IV V VI

System Description: Conventional

Repair System Description:

Maintenance Agreement Required ☐ YES ☑ NO

☑ GRAVITY ☐ PRESSURE

☑ Residence No. Bedrooms 3

☐ Business No. Persons

☐ Other No. Employees

☐ Slab ☑ Crawl Space

☐ Basement w/plumbing ☐ Basement w/o plumbing


Water Supply: ☑ Private ☐ Public ☐ Community

Comments / Conditions

Comments / Conditions

INITIAL SITE SKETCH

AS BUILT SKETCH

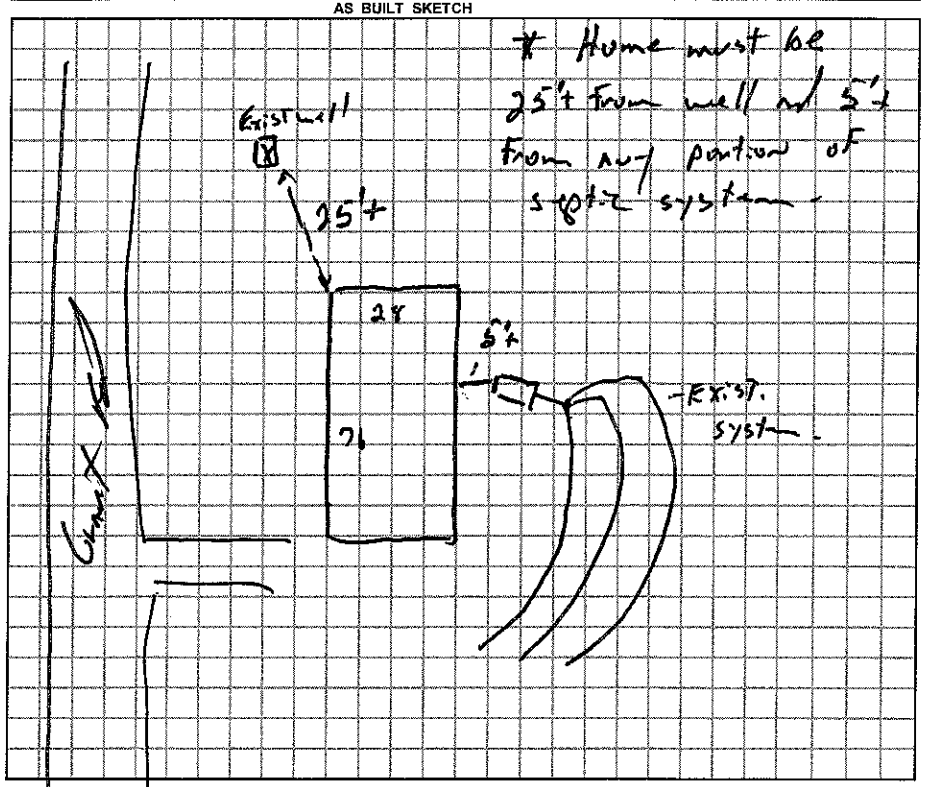

Permit can be suspended or revoked if any false information is supplied toward securing the permit / any unauthorized changes are made to the site / any unauthorized changes are made in the installation of the system.

☐ *IMPROVEMENT PERMIT w / plat valid without expiration.* ☐ *IMPROVEMENT PERMIT w / site plan valid for 60 mos.* ☐ *AUTHORIZATION TO CONSTRUCT valid for period equal to IMPROVEMENT PERMIT-not to exceed 60 mo.*

Owner / Applicant Signature: Leon J Clem Sr Date 6-16-2010

Improvement Permit by: Date

Authorzation to Construct by: Date

YOU SHOULD CONTACT A LOCATOR SERVICE PRIOR TO ANY EXCAVATION.

Installed by:

Operation Permit by: Date:

Existing System Inspected by: R.S. Date: 16 June 10

WHITE COPY Environmental Health YELLOW COPY (Final) Owner / Applicant PINK COPY (Initial) Owner / Applicant