IREDELL COUNTY HEALTH DEPARTMENT

Statesville Office (704) 878-5305 Mooresville Office (704) 660-3625 PERMIT # 21091

IMPROVEMENT PERMIT / AUTHORIZATION TO CONSTRUCT / OPERATION PERMIT / EXISTING SYSTEM

PIN # 4729-97-5169

APPLICANT: McLain Farms Inc. APPLICANT ADDRESS: 832 Snow Creek Rd. Statesville

SITE ADDRESS: 134 Edgewood School Ln. Stat. PHONE: ALT. PHONE:

SITE DIRECTIONS: 115 N, Hams Grove, TR Jehue, TR Edgewood School

SUBDIVISION: SECTION: LOT # LOT AREA: 1.871 AC DESIGN FLOW: 480 L.T.A.R.: .3

Septic Tank 1000 (gal) STB 1012 Date 3/20/16
Pump Tank (gal) PT Date
Pump Make Model Serial #
Nitrification Fields 1 # Lines 7 Linear Ft: 405'
Trench Width 36" Max. Trench Bottom Depth 32" Lowside Gravel Depth

☑ New System ☐ Repair ☐ Expansion System Type: I II (III) IV V VI
System Description: 25% Reduction
Repair System Description: Panel Block
Maintenance Agreement Required: ☐ YES ☑ NO
☑ GRAVITY ☐ PRESSURE

☑ Residence No. Bedrooms 4
☐ Business No. Persons 8
☐ Other No. Employees
☐ Slab ☑ Crawl Space
☐ Basement w/plumbing ☐ Basement w/o plumbing

Water Supply: ☑ Private ☐ Public ☐ Community

Comments / Conditions:

INITIAL SITE SKETCH

See Plan From Penninger Soil Consulting

AS BUILT SKETCH

Permit can be suspended or revoked if any false information is supplied toward securing the permit / any unauthorized changes are made to the site / any unauthorized changes are made in the installation of the system. **CONTACT A LOCATOR SERVICE PRIOR TO ANY EXCAVATION**

☐ **IMPROVEMENT PERMIT** *with plat valid without expiration.* ☑ **IMPROVEMENT PERMIT** *with site plan valid for 60 mos.* ☑ **AUTHORIZATION TO CONSTRUCT** *valid for period equal to IMPROVEMENT PERMIT--not to exceed 60 mo.*

Owner / Applicant Signature: Mike McLain Date: 8/25/16

IMPROVEMENT PERMIT by: APPROVED Date AUG 19 2016


AUTHORIZATION TO CONSTRUCT by: APPROVED Date AUG 19 2016

Installed by: Steve Jordan

OPERATION PERMIT by: W Sparks Date: 9/8/16

Existing System Inspected by: Date:

Health Dept. Copy - WHITE Applicant (Final Approval)) - YELLOW Applicant (Conditional Approval) - PINK

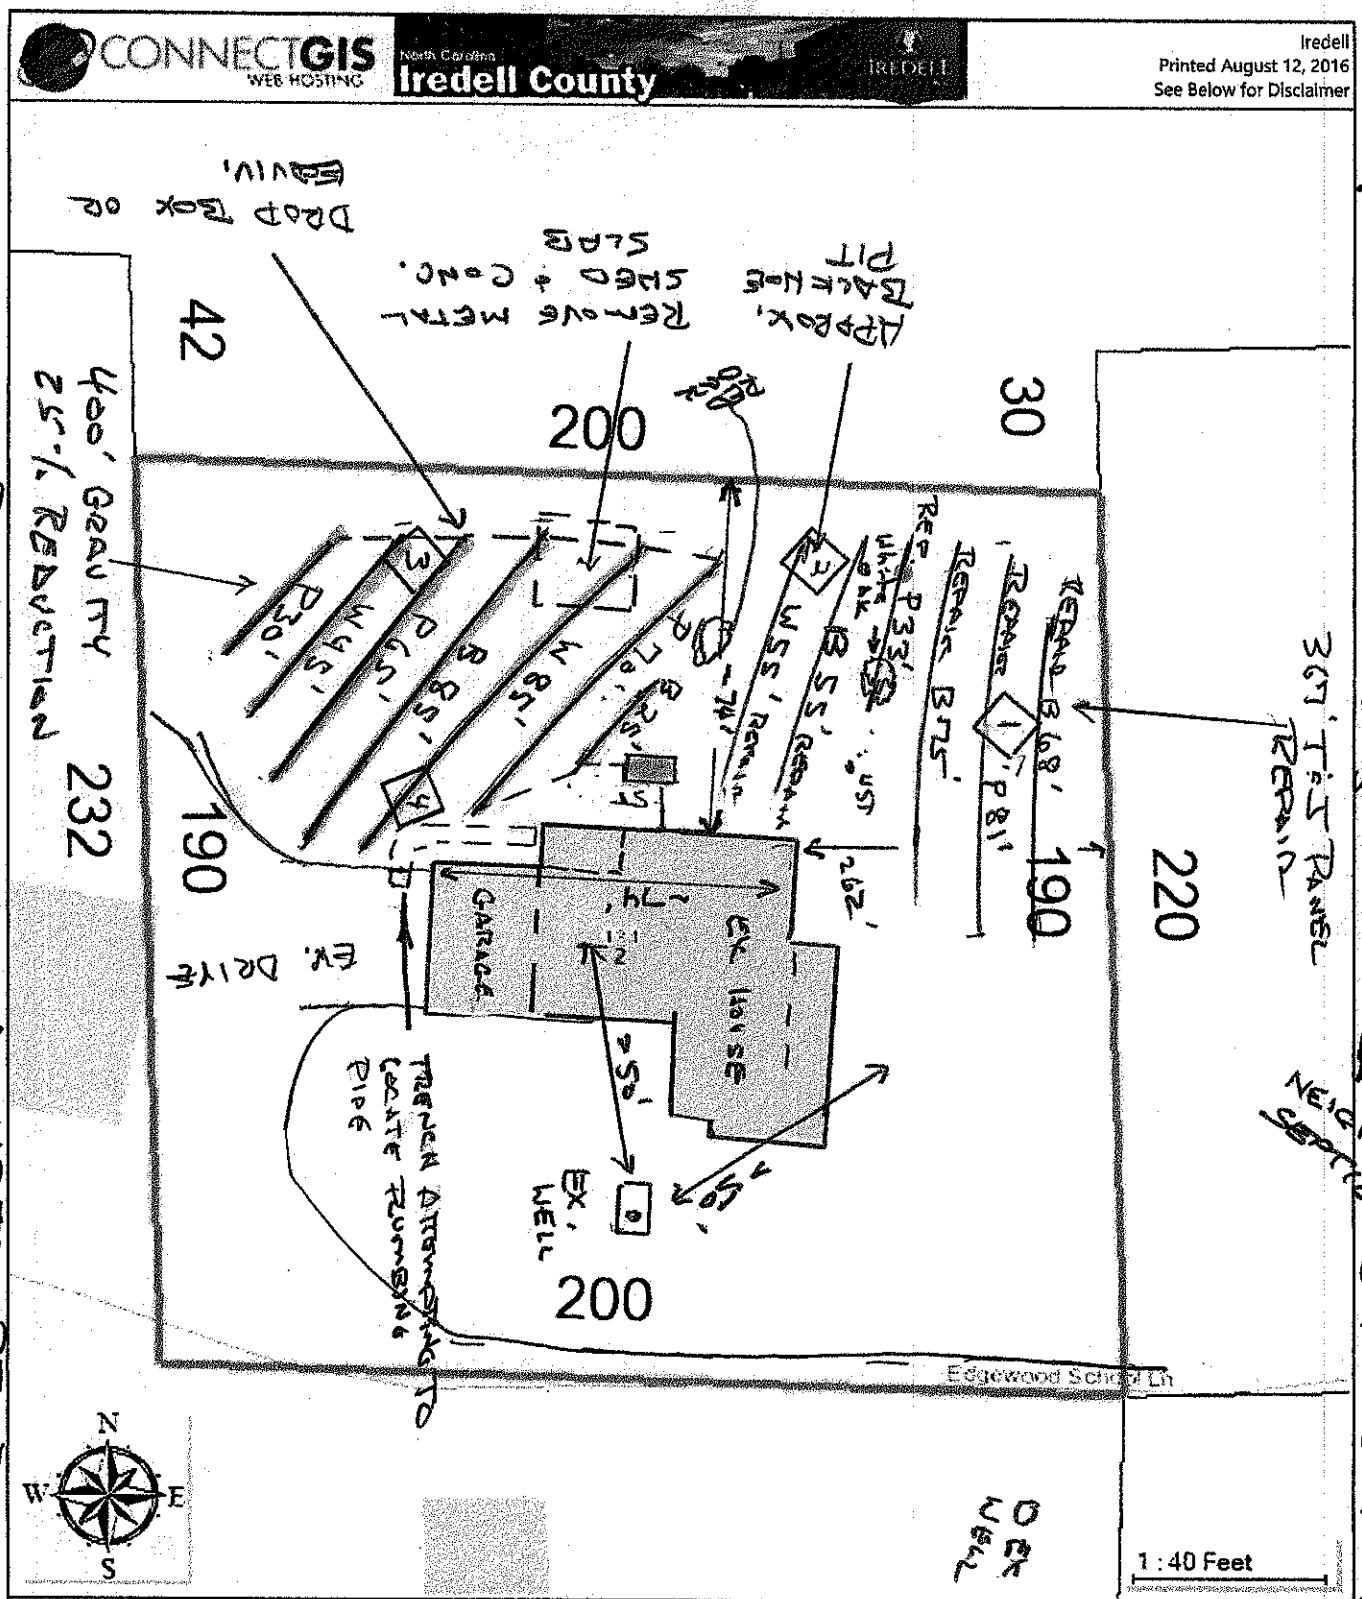

The maps prepared for this website are generated from recorded deeds, plats, and other public records. Users of these maps are hereby notified that the information provided herein should be verified. Iredell County assumes no legal responsibilities for any of the information contained on this site. Users are advised that the use of any of this information is at their own risk. All maps on this site were prepared using a 1000â€™ Grid based upon the North Carolina State Plane Coordinate System from the 1983 North American Datum. The delinquent real property tax overlay is updated monthly. The information presented is not intended to be used or relied upon as official notice of tax liens. For additional information regarding delinquent taxes, contact the Iredell County Tax Collector's Office.

APPROVED AUG 19 2016

McLain Farm - Edgewood Sch. Rd. Ln. Septic Site Plan

8-15-16