3:30

IREDELL COUNTY HEALTH DEPARTMENT - *ENVIRONMENTAL HEALTH* ☑ STATESVILLE OFFICE 704-878-5305 ☐ MOORESVILLE OFFICE 704-664-5281

IMPROVEMENT PERMIT / AUTHORIZATION TO CONSTRUCT / OPERATION PERMIT / EXISTING SYSTEM INSPECTION

PERMIT # Repair PIN # 4729-97-7155 DATE 20 December 2011

OWNER McLain Farms Inc. APPLICANT: mike McLain PHONE: Home/Cell # (704) 838-3734 Business #

SITE ADDRESS 118 Edgewood School Ln. Stat. OWNER / APPLICANT ADDRESS

SITE DIRECTIONS 115 N TR Harris Grove Ch. Rd. TR Jetton Rd. TR Edgewood school Ln on Rt.

SUBDIVISION BLOCK / SECTION LOT # LOT AREA 0.93ac. DESIGN FLOW 360gpd L.T.A.R. 0.3/1.8

Septic Tank Exist. Gallons: STB Date

Pump Tank Gallons: PT Date

Pump Make Model Serial #

No. Nitrification Fields: 1 No. Lines 3 Linear Feet 200

Trench Width 36" Max. Trench Bottom Depth 36"

☐ New System ☑ Repair ☐ Expansion System Type I II (III) IV V VI

System Description: Conventional

Repair System Description: 25% Reduction System.

Maintenance Agreement Required ☐ YES ☑ NO

Gravel Depth NA ☑ GRAVITY ☐ PRESSURE

☑ Residence No. Bedrooms 3

☐ Business No. Persons

☐ Other No. Employees


☐ Slab ☑ Crawl Space

☐ Basement w/plumbing ☐ Basement w/o plumbing


Water Supply: ☑ Private ☐ Public ☐ Community

Comments / Conditions * Keep 10' from waterline.

INITIAL SITE SKETCH

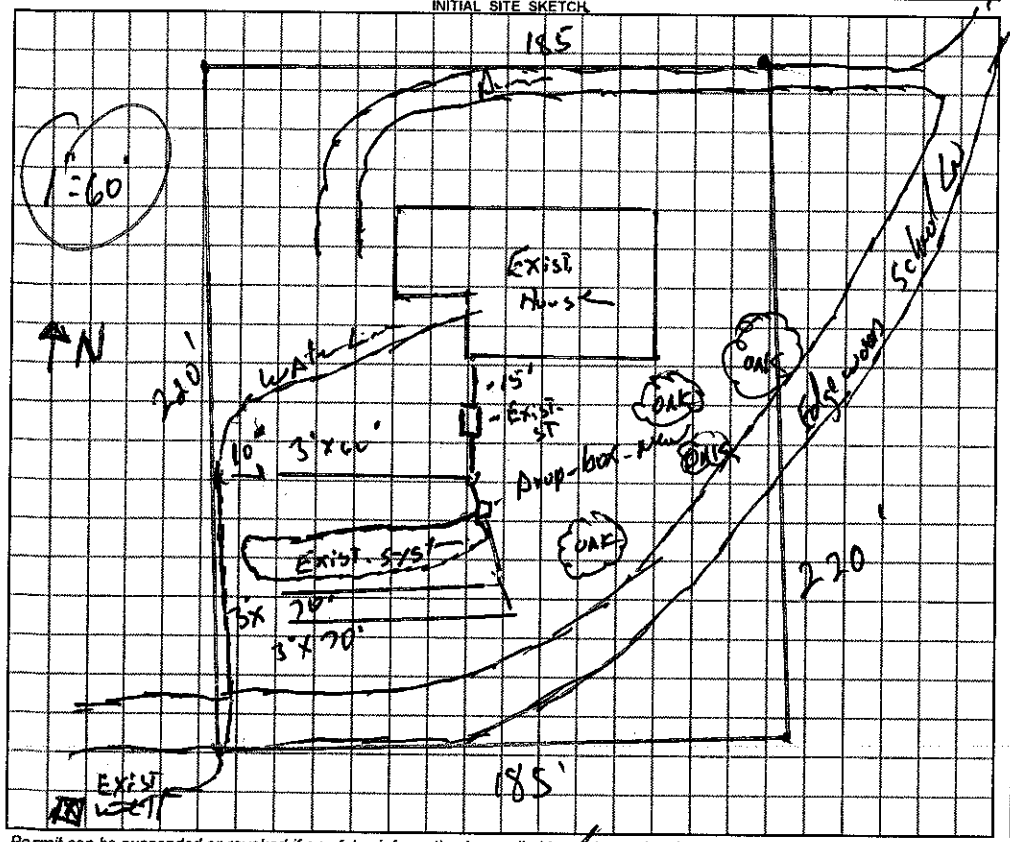

AS BUILT SKETCH

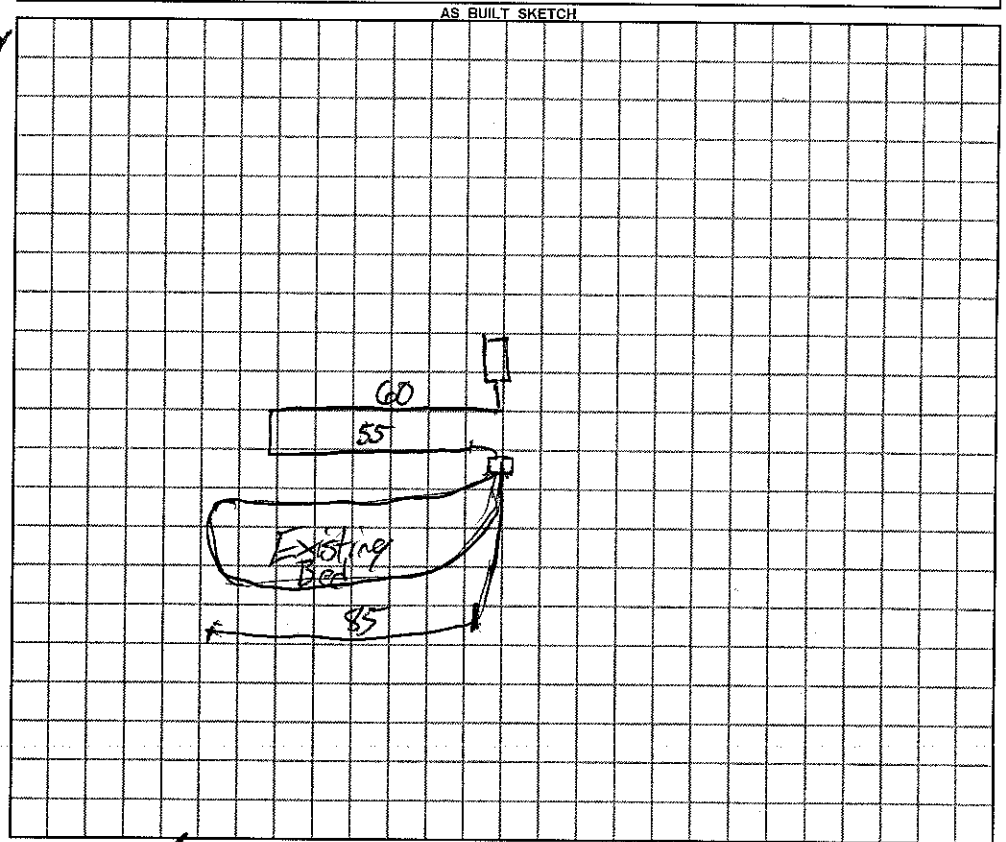

Permit can be suspended or revoked if any false information is supplied toward securing the permit / any unauthorized changes are made to the site / any unauthorized changes are made in the installation of the system.

☐ ***IMPROVEMENT PERMIT*** *with plat valid without expiration.* ☑ ***IMPROVEMENT PERMIT*** *with ~~plat~~ site plan valid without expiration. site plan valid 60 mo.* ☐ ***AUTHORIZATION TO CONSTRUCT*** valid for period equal to IMPROVEMENT PERMIT--not to exceed 60 mo.

Owner / Applicant Signature: Date

IMPROVEMENT PERMIT by: REHS Date 12-2011

AUTHORIZATION TO CONSTRUCT by: REHS Date 12-20-11

YOU SHOULD CONTACT A LOCATOR SERVICE PRIOR TO ANY EXCAVATION

Installed by: A-1 Backhoe Lentz Septic

OPERATION PERMIT by: REHS Date 1-5-12

Existing System Inspected by: REHS Date

White Copy -- Environmental Health YELLOW COPY (Final) Owner / Applicant PINK COPY (Initial) Owner / Applicant