IREDELL COUNTY HEALTH DEPARTMENT

Statesville Office (704) 878-5305 Mooresville Office (704) 660-3625 PERMIT # 209417

IMPROVEMENT PERMIT / AUTHORIZATION TO CONSTRUCT / OPERATION PERMIT / EXISTING SYSTEM

PIN # 4730030434

APPLICANT: Erika Martin APPLICANT ADDRESS: 510 State Park Rd.

SITE ADDRESS: 510 State Park Rd. - Iron 28166 PHONE: 704-928-7410 ALT. PHONE: N/A

SITE DIRECTIONS: Hwy 21 S TR Perth Rd TR State Park Rd. Last House

SUBDIVISION: N/A SECTION: N/A LOT # N/A LOT AREA: 1.57 acres DESIGN FLOW: Existing L.T.A.R.: Existing

Septic Tank	Existing	(gal)	STB		Date		☐ New System	☐ Repair	☐ Expansion	System Type:	I	II	III	IV	V VI
Pump Tank		(gal)	PT		Date		System Description:	Existing							
Pump Make			Model		Serial #		Repair System Description:								
# Nitrification Fields	Ex	# Lines	Ex	Linear Ft:	Ex		Maintenance Agreement Required:	☐ YES	☑ NO						
Trench Width	Ex	Max. Trench Bottom Depth	Ex	Gravel Depth	Ex			☐ GRAVITY	☐ PRESSURE						


☑ Residence	No. Bedrooms	Ex	Water Supply		
☐ Business	No. Persons		☑ Private		
☐ Other	No. Employees		☐ Public		
☐ Slab	☑ Crawl Space		☐ Community		
☐ Basement w/plumbing			☐ Basement w/o plumbing		

Comments / Conditions:


* - Maintain a minimum of 5' between all building foundations & all components of septic tank system. *

INITIAL SITE SKETCH

Scale 1" = 50'

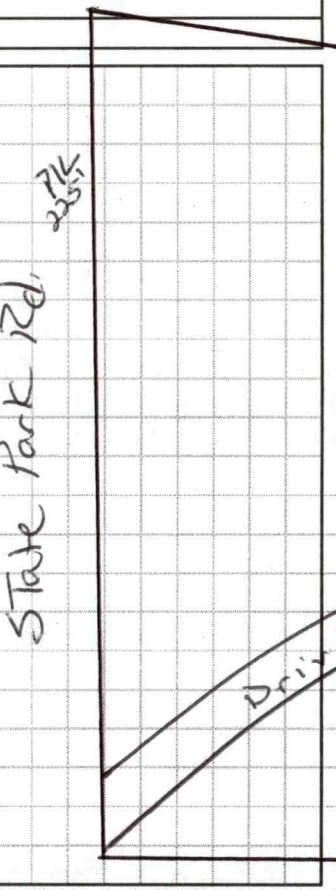

AS BUILT SKETCH

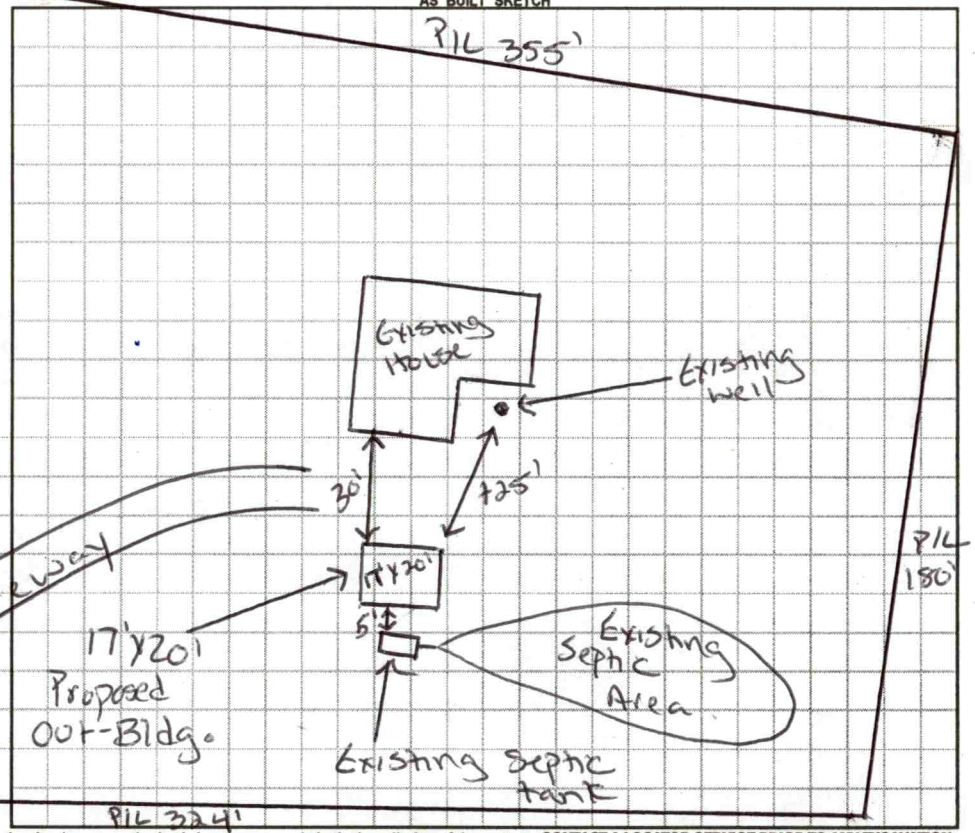

Permit can be suspended or revoked if any false information is supplied toward securing the permit / any unauthorized changes are made to the site / any unauthorized changes are made in the installation of the system. **CONTACT A LOCATOR SERVICE PRIOR TO ANY EXCAVATION**


☐ **IMPROVEMENT PERMIT** *with plat valid without expiration.* ☐ **IMPROVEMENT PERMIT** *with site plan valid for 60 mos.* ☐ **AUTHORIZATION TO CONSTRUCT** *valid for period equal to IMPROVEMENT PERMIT--not to exceed 60 mo.*

Owner / Applicant Signature: _____ Date: _____ Installed by: _____

IMPROVEMENT PERMIT by: _____ Date: _____ OPERATION PERMIT by: _____ Date: _____

AUTHORIZATION TO CONSTRUCT by: _____ Date: _____ Existing System Inspected by: Justin Henderson Date: 4-17-15

Health Dept. Copy - WHITE Applicant (Final Approval) - YELLOW Applicant (Conditional Approval) - PINK

 

IREDELL COUNTY

PO Box 788
349 North Center St.
Statesville, NC 28677

APPLICATION NUMBER
209417
Issue Date: 03/31/2015

ZONING PERMIT

Residential

Parcel Number	Street Address	Jurisdiction
4730030434.000	510 STATE PARK ROAD, TROUTMAN, NC 28166	TROUTMAN

Owner Information	Applicant Information
Owner: MARTIN ERICA G+JASON	Applicant: MARTIN, ERICA
Address: 510 STATE PARK RD TROUTMAN, NC 28166	Address: 510 STATE PARK ROAD TROUTMAN, NC 28166
Phone:	Phone: 704-928-7410

Use Requested	Zone Code
12*20 ACC BLDG	RA

Lot Acreage	F Setback	B Setback	L Setback	R Setback	Watershed	Flood Zone
1.570		10.00	10.00	10.00	CACL	X

Remarks:

Accessory Buildings and Structures Zoning Permit: Shall not be erected in front building line of the principal structure. Shall not be erected within 25 ft of any side street or corner lot. Shall not be erected within 10 ft of any line not a street line or within 10ft of any other building on the same lot. Shall not be erected within the 50ft buffer zone on lake front properties. Shall not exceed the height limitation of the principal structure. Exceptions to the front building line location: if the lot equals 1 acre or greater, and is double frontage lake lot or the location of the building/structure is 150 feet or greater than from the frontage street right of way line than the structure can be located in front of home. Any accessory building or structure over 1200 sq/ft shall be setback a minimum of fifty (50) feet from any property line.

The applicant certifies that there are no deed restrictions, contractual agreements or governmental regulations of any kind that interfere with or prohibit the use of the property or the use for which this permit is requested. The applicant further acknowledges that enforcement of deed restrictions, plat conditions and other contractual agreements will not be undertaken by Iredell County and is the sole responsibility of the affected parties.

Applicant: _____ Date: _____

Permit Number	34821	TOTAL FEES:	$ 77.25

Please call before you go.

IREDELL COUNTY HEALTH DEPARTMENT

ENVIRONMENTAL HEALTH DIVISION

PAGE 1: *APPLICATION FORM*

Application For:
( ) New Well Permit ( ) Well Repair Permit ( ) Well Abandonment
(X) Septic Improvement Permit ( ) Authorization to Construct ( ) Existing System Inspection ( ) Septic System Repair

THE ABOVE PERMIT DOCUMENTS WILL BECOME INVALID IF INFORMATION PROVIDED ON THIS APPLICATION IS FALSIFIED OR CHANGED, OR IF THE SITE IS ALTERED. THE IMPROVEMENT PERMIT IS VALID FOR EITHER 60 MONTHS OR WITHOUT EXPIRATION DEPENDING UPON DOCUMENTATION SUBMITTED APPLICATION WITH SITE PLAN 60 MONTHS, APPLICATION WITH COMPLETE, SCALED PLAT WITHOUT EXPIRATION. SEE 15A NCAC 18A .1937(f) FOR DETAILS.

Page 2: *Site Plan Worksheet* form MUST accompany this application

The following optional attachments may also be submitted: ( ) Survey Plat, scaled no more than 1 inch = 60 feet
Place an (X) beside whichever is submitted if applicable ( ) Custom Site Plan, scaled no more than 1 inch = 60 feet

Applicant Information:

Applicant Name: Erika Martin **Address:** 510 State Park Rd **Phone:** 704-928-2410

Owner Name: " " **Address:** " " **Phone:** "

Property Information:

Street Address: 510 State Park Rd, Troutman

Subdivision Name: — **Section/Phase:** _____ **Lot Number:** _____

Driving Directions: Last house on right prior to Lake Norman State Park

Site Development Information: *(check or complete ALL that apply)*

( ) New Single Family Residence
( ) New Multi-Family Residence
(X) Accessory Building 12x20
( ) Bedroom(s) Addition

Maximum Number of Bedrooms: 3
Maximum Number of Occupants: _____
( ) Swimming Pool
( ) Other Addition/Structure: _____

( ) Crawl Space Foundation
( ) Concrete Slab Foundation
( ) Basement with Plumbing
( ) Basement without Plumbing

Non-Residential Site Development:
Type of Business: _____
Square Footage of Building: _____
Maximum Number of Employee: _____
Maximum Number of Seats/Beds/Other: _____

Water Supply:

( ) New Well (X) Existing Well ( ) Community Well ( ) City Water ( ) Other Public Water

Desired Septic System Type: *(you may rank in order of preference)* **Year existing system installed:** _____

( ) No Preference ( ) Alternative ( ) Conventional ( ) Innovative ( ) Modified Conventional ( ) Other: _____

Please answer the following to the best of your ability:

( ) Yes ( ) No Does the site contain any jurisdictional wetlands?
( ) Yes ( ) No Is any non-domestic sewage (i.e. industrial) to be generated?
( ) Yes ( ) No Is the site subject to approval by any other public agency?

I have read this application and certify that the information provided herein is true, complete, and correct. Authorized county and state officials are granted right of entry to conduct necessary inspections to determine compliance with applicable laws and rules. I understand that I am solely responsible for the proper identification and labeling of all property lines and corners and making the site accessible so that a complete site evaluation can be performed.


Signature: _____ **DATE** 3-31-15
Property owner or owner's legal representative signature (SIGNATURE REQUIRED)

IREDELL COUNTY HEALTH DEPARTMENT

ENVIRONMENTAL HEALTH DIVISION

PAGE 2: *SITE PLAN WORKSHEET*

SEE THE "SAMPLE SITE PLAN" BELOW. *INCOMPLETE SITE PLANS WILL BE RETURNED TO YOU FOR COMPLETION AND MAY RESULT IN A DELAY IN THE ISSUANCE OF YOUR SEPTIC SYSTEM PERMIT!!!*

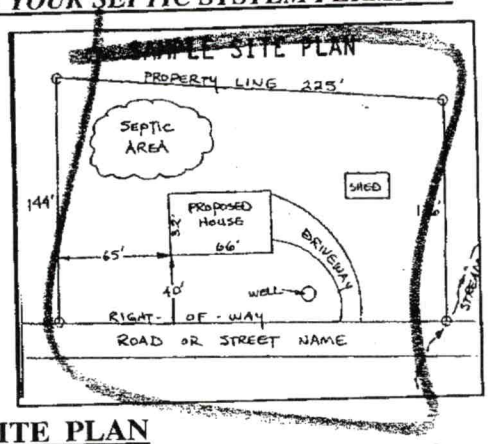

Place an (X) beside each item as you complete the site plan:


- (✓) Property Line measurements are clearly identified
- (✓) All proposed structures are indicated
- (✓) Front and side setbacks from property line
- (✓) Preferred driveway location and well location
- (✓) Area you prefer your septic system to be placed
- (✓) North arrow, or other sufficient indicator of direction

Circle N/A on the following if appropriate:

Location of septic systems and wells within 100' of your property	N/A
Location of easements and rights of ways on your property	N/A
Location of any designated wetlands on the property	N/A

USE THIS SPACE TO DRAW YOUR SITE PLAN

Show: proposed house or business footprint, wells, water lines, patios, pools and decks, and any other item that will occupy space on the site

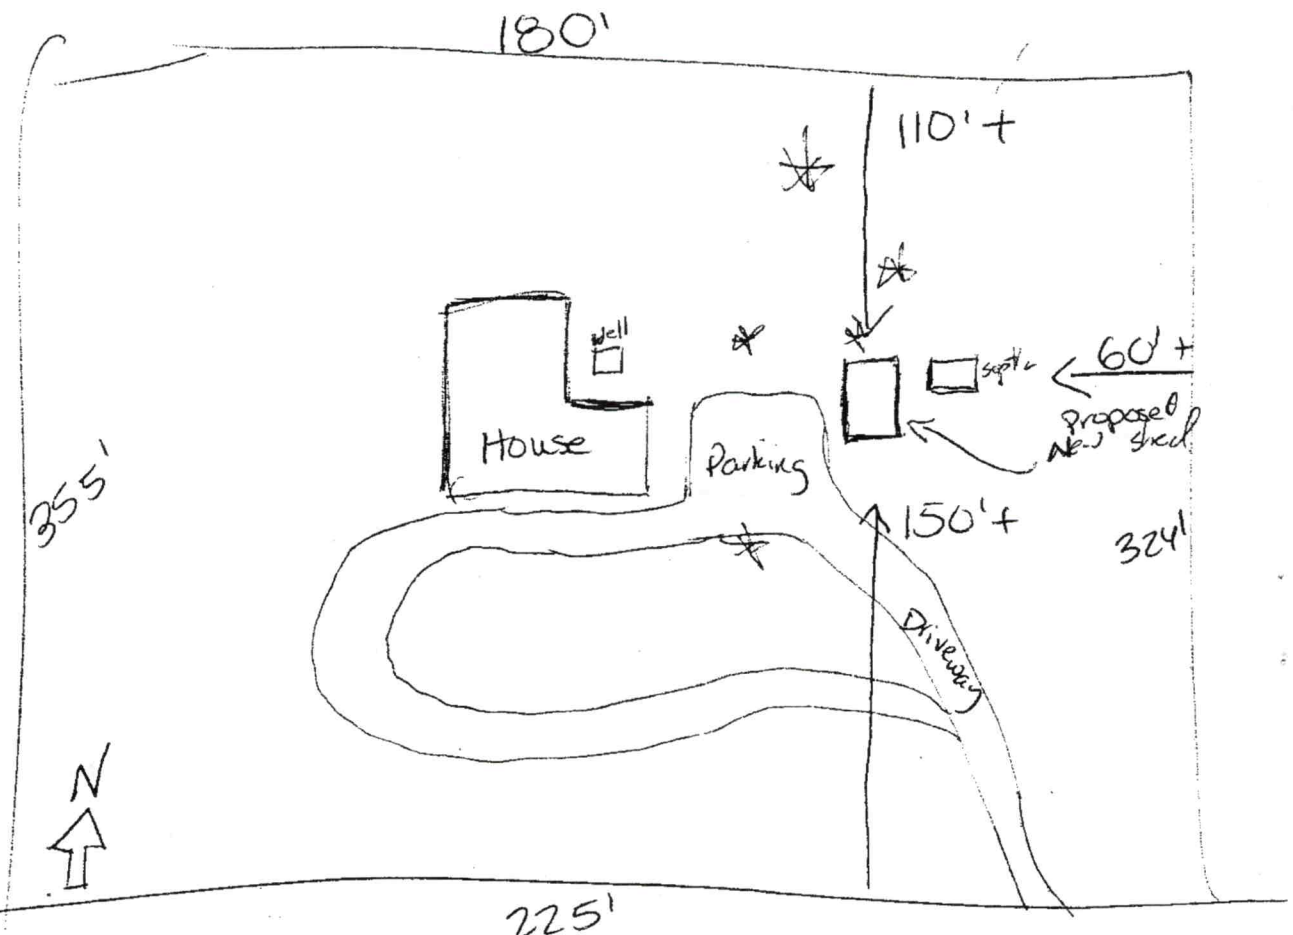

Signature: _____ 3-31-15

Property owner or owner's legal representative signature (SIGNATURE REQUIRED) — DATE