#18143 Peter + Sandra Balise 4730 03 1738

IREDELL COUNTY HEALTH DEPARTMENT

STATESVILLE 704-878-5305 MOORESVILLE 704-664-5281

IMPROVEMENT PERMIT / AUTHORIZATION TO CONSTRUCT / OPERATION PERMIT / EXISTING SYSTEM INSPECTION

PERMIT# 129057 PIN# ~~4730031874~~ 4730031738 DATE 8-9-05

OWNER OR CONTRACTOR Tracy + Sonya McElwee PHONE: Business Home 704-528-9745

ADDRESS 220 Dunwoody Rd.

LOCATION State Park Rd., 3rd house before St. Park boundary, on right, 494 St. Park Rd.

SUBDIVISION BLOCK / SECTION LOT LOT AREA 10.11 Ac SITE CLASS. PS DESIGN FLOW 480 L.T.A.R. .3

Septic Tank: 1000 Gallons; STB 1012 Date 9-2-05
Pump Tank: Gallons; PT Date
Pump Make: Model Serial No.
Nitrification Field: No Fields 1 Square Feet 11000 Linear Feet 400
No Lines 4 @ 100 Trench Width 36" Max Trench Bottom Depth 36"

☒ New System ☐ Repair System Type: I, II, III, IV, V, VI
System Description: 2590 sqft., gravity
Repair System Description: 2590 sqft. gravity
Maintenance Agreement Required: ☐ Yes ☒ No
Gravel Depth NA

☒ House/Mod. Home No. Bedrooms 4
☐ Mobile Home No. Bathrooms
☐ Business No. Employees
☐ Other


☐ Slab ☒ Crawl Space ☐ Basement w/plumbing ☐ Basement wo/plumbing

Water Supply: ☒ Individual ☐ Public ☐ Community


Comments/Conditions:
well to be placed a minimum of 100 ft from septic system

Comments/Conditions:
Yellow tuf-tite tee Line 1 95'
tank w/ marker, sch. 40 PVC 3" supply 2 105'
Installed Quick 4 Std. chamber 3 95'
4 110'

INITIAL SITE SKETCH 597'

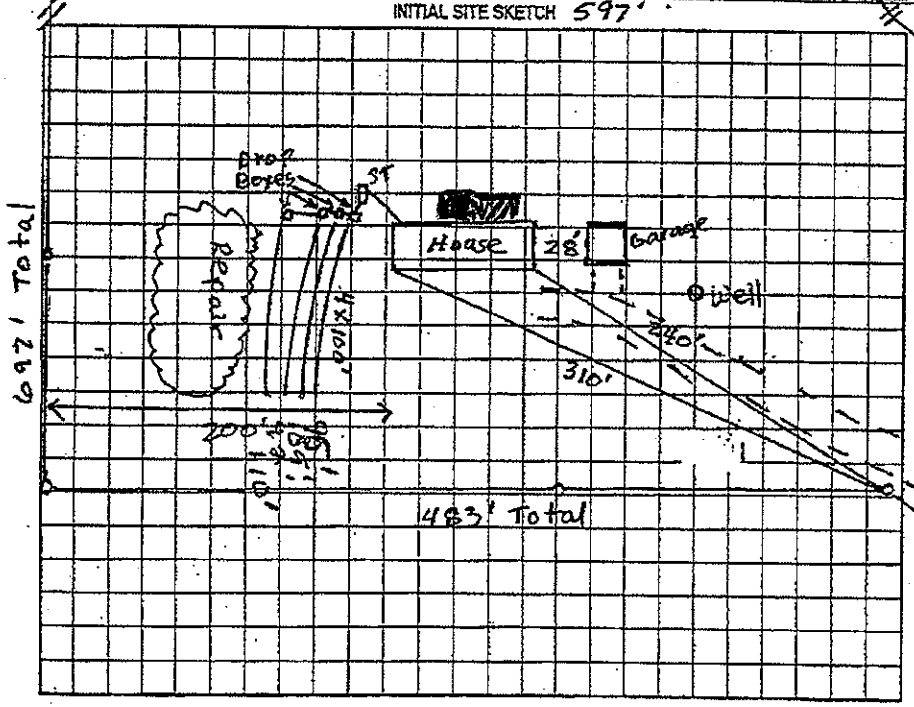

AS BUILT SKETCH

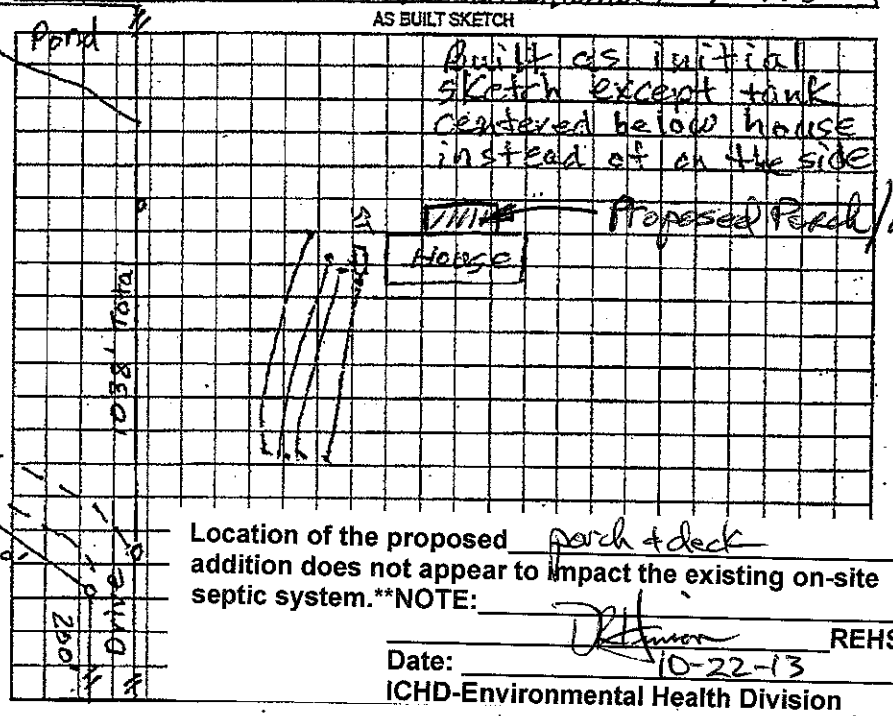

Location of the proposed porch + deck addition does not appear to impact the existing on-site septic system.**NOTE:

REHS

Date: 10-22-13

ICHD-Environmental Health Division

Permit can be suspended or revoked if any false information is supplied toward securing the permit/any unauthorized changes are made to the site/any unauthorized changes are made in the installation of the system. Improvement Permit with plan valid without expiration. Improvement Permit with site plan valid for sixty months. Authorization to Construct is valid for a period equal to that of Improvement Permit – not to exceed sixty months.

Signed: Sonya McElwee date 8-9-05

Improvement Permit by: Judy Melville date 8-9-05

Authorization to Construct by: Judy Melville date 8-9-05

Installed by: A-1 Backhoe Service

Operation Permit by: Judy Melville date 8-12-05

Existing System Inspection by: date

HEALTH DEPT. COPY: WHITE OWNER COPY (FINAL): YELLOW OWNER COPY (INITIAL): PINK