Picked up yellow + gold copy on 10/29/96 (KS)

IREDELL COUNTY HEALTH DEPARTMENT

STATESVILLE 704-878-5305 MOORESVILLE 704-664-5281

IMPROVEMENT PERMIT / CERTIFICATE OF COMPLETION / OPERATION PERMIT / EXISTING SYSTEM INSPECTION

PROPERTY DESCRIPTION NO. 25328 DATE 10-22-96 TAX MAP NO. 3EB 27D (Pt) + 11 3E-B-56 Watershed: [X] Yes [ ] No

OWNER OR CONTRACTOR Patrick Altham PHONE: Business _____ Home 528-6157 WSIV-PA

ADDRESS 1328 Perth Rd Troutman NC 28166

LOCATION Troutman - Perth Rd TR State Park Rd Property on Right 1 3ac

SUBDIVISION _____ BLOCK / SECTION _____ LOT _____ LOT AREA 1 3ac. SITE CLASS. _____ DESIGN FLOW _____ L.T.A.R. _____

Septic Tank: 1000 Gallons; STB _____ Date _____

Pump Tank: _____ Gallons; PT _____ Date _____

Pump Make: _____ Model _____ Serial No. _____

Nitrification Field: No Fields 1 Square Feet 750 Linear Feet 250

No Lines 2 Trench Width _____ Max Trench Bottom Depth _____ Gravel Depth 10,11

[ ] New System [ ] Repair System Type: I (II) III, IV, V, VI

System Description: Conventional / Gravity

Repair System Description: _____

Maintenance Agreement Required: [ ] Yes [X] No

[ ] Slab [X] Crawl Space [ ] Basement w/plumbing [ ] Basement wo/plumbing

[ ] House/Mod. Home No. Bedrooms 2

[X] Mobile Home No. Bathrooms _____

[ ] Business No. Employees _____


[ ] Other _____

Water Supply: [X] Individual [ ] Community [ ] Public


Comments: House Not on site time of inspection

Comments:

INITIAL SITE SKETCH

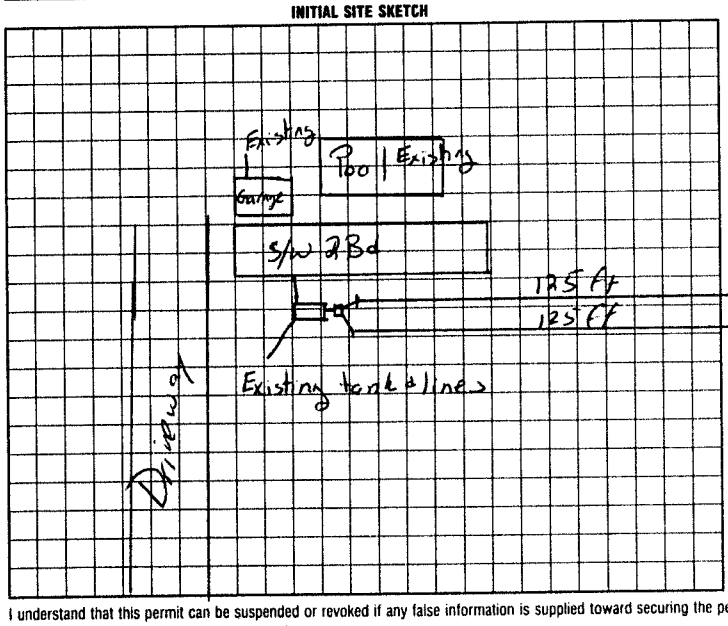

AS BUILT SKETCH

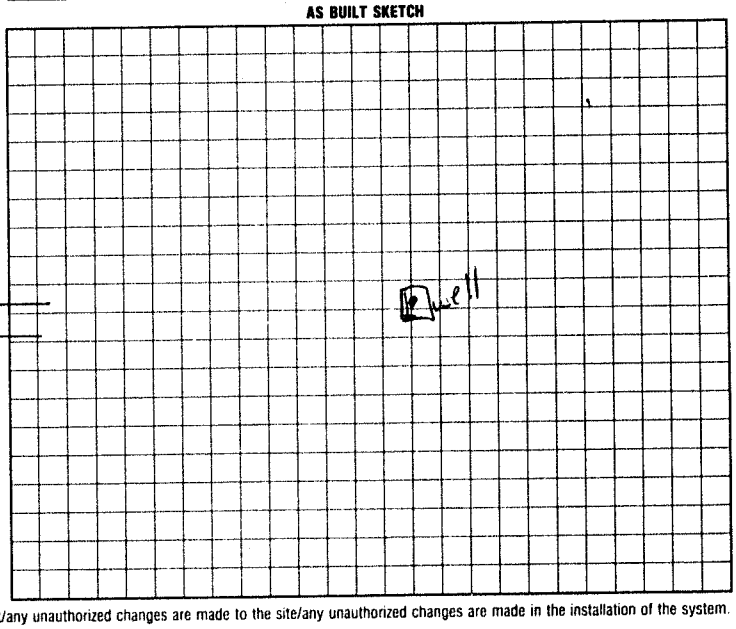

I understand that this permit can be suspended or revoked if any false information is supplied toward securing the permit/any unauthorized changes are made to the site/any unauthorized changes are made in the installation of the system.

Signed: Sandy Altham

Improvement Permit by: _____ date _____

Existing System Inspection by: Mary C Daf date 10-22-96

Installed by: _____

Certificate of Completion by: _____ date _____

Operation Permit by: _____ date _____

HEALTH DEPT. COPY: WHITE (INSPECTION COPY (FINAL): GREEN) OWNER COPY (FINAL): YELLOW INSPECTION COPY (INITIAL): PINK OWNER COPY (INITIAL): GOLD