IREDELL COUNTY HEALTH DEPARTMENT

STATESVILLE 704-878-5305 MOORESVILLE 704-664-5281

@ THIS PERMIT REPLACES PREVIOUS ISSUED ~~12-19-2008~~ CH

IMPROVEMENT PERMIT / AUTHORIZATION TO CONSTRUCT / OPERATION PERMIT @ / EXISTING SYSTEM INSPECTION

PERMIT # 151525 PIN # 4730037615 DATE 9-17-09

OWNER or APPLICANT Rick + Dena Jaggers PHONE: Business 336-466-4948 Home:

OWNER or APPLICANT ADDRESS PO BOX 244 ELKIN NC 28621

LOCATION / DIRECTIONS 21 South (R) Perth (R) State Park (R) Parkstone 2ND LOT ON LEFT

SUBDIVISION Parkstone BLOCK / SECTION N/A LOT # 2 LOT AREA 1.426 DESIGN FLOW 480 L.T.A.R. .275

Septic Tank 1000 Gallons: STB 1012 Date 9-21-10

Pump Tank 1000 Gallons: PT 17-1000 Date 3-11-10

Pump Make Model Serial #

Nitrification Field No Fields 1 No Lines 3 Linear Feet 450'

Trench Width 36" min. Max. Trench Bottom Depth 18" Gravel Depth N/A

☒ New System ☐ Repair ☐ Expansion System Type I II (III) IV V VI

System Description: Pump 25% Reduction

Repair System Description: Low Pressure Drip Irrigation

Maintenance Agreement Required ☐ YES ☒ NO

☒ GRAVITY ☒ PRESSURE

☒ Residence No. Bedrooms 4 ☐ Business No. Persons ☐ Other No. Employees ☐ Slab ☐ Crawl Space ☒ Basement w/plumbing ☐ Basement w/o plumbing

Water Supply: ☒ Private ☐ Public ☐ Community

Comments / Conditions ① Note minimum trench bottom depth is 18" ② Entire System & offsite & house is flagged. ③ Maintain Setbacks ④ System Specs not determined Until lot is cleared and basement is dug. CALL then

INITIAL SITE SKETCH

SEE ATTACHED SYSTEM DESIGNED BY LORNE COOK, R.S. AND ROLLINS SOIL & ENVIRONMENTAL Project # 01-1246 THIS IS A REPAIR Permit From County TO PUMP & HOUSE DIMENSIONS IS THE ONLY CHANGES.

Comments / Conditions for system specs: ⑨ Proposed Well Area May NOT Be where well will be placed. A WELL Permit will be required to determine this location. ⑤ PLANNED ON 3 BEDROOM HOUSE. System Sized for 4 BEDROOMS.

AS BUILT SKETCH

⑥ 18" minimum trench bottom on the low side of ditch and 24" on high side of ditch

Installed AS Drawn

Permit can be suspended or revoked if any false information is supplied toward securing the permit / any unauthorized changes are made to the site / any unauthorized changes are made in the installation of the system.

☐ *IMPROVEMENT PERMIT w /plat valid without expiration.* ☒ *IMPROVEMENT PERMIT w / site plan valid for 60 mos.* ☒ *AUTHORIZATION TO CONSTRUCT valid for period equal to IMPROVEMENT PERMIT-not to exceed 60 mo.*

Owner / Applicant Signature: Date 9/21/09

Improvement Permit by: Date 9-17-09

Authorization to Construct by: Date 9-17-09

YOU SHOULD CONTACT A LOCATOR SERVICE PRIOR TO ANY EXCAVATION.

Installed by: Steve Brown


Operation Permit by: R.S. Date: 15/14/2011

Existing System Inspected by: Date:

WHITE COPY Environmental Health YELLOW COPY (Final) Owner / Applicant PINK COPY (Initial) Owner / Applicant

Permit 151525
D.n 4730037615
"~~NOT~~ TO SCALE"
ATTACHMENT 1

* Site sketch replaces one issued 9-17-09 TCH

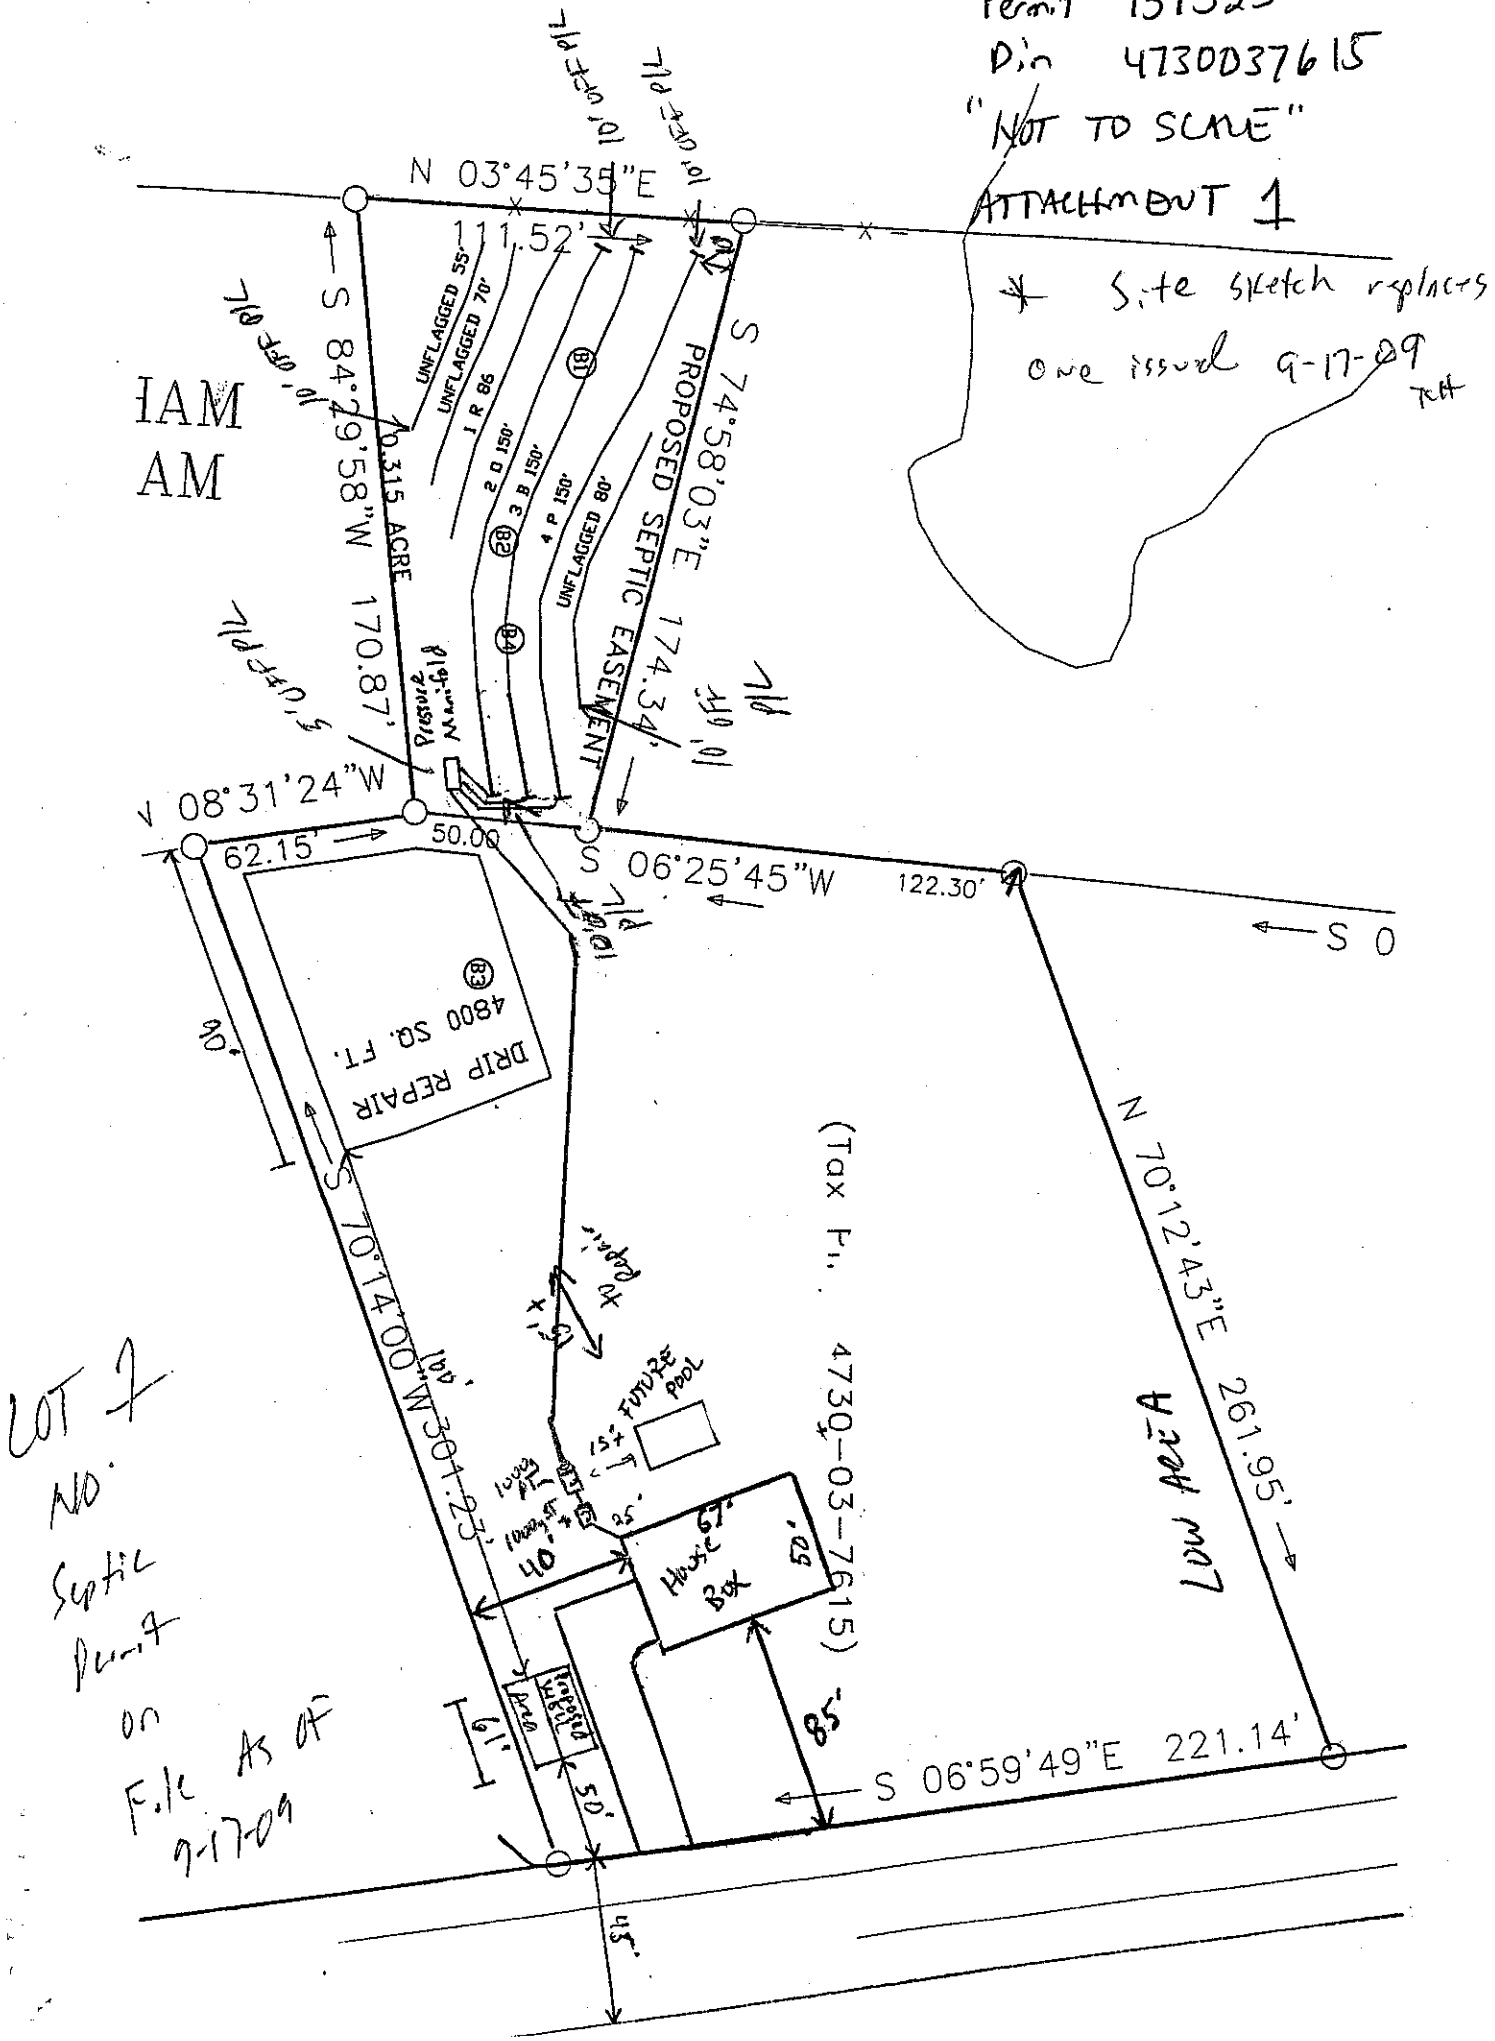

LOT 7
NO
Septic
Permit
on
File As of
9-17-09