IREDELL COUNTY HEALTH DEPARTMENT

Statesville Office (704) 878-5305 Mooresville Office (704) 660-3625 PERMIT # 211160

IMPROVEMENT PERMIT / AUTHORIZATION TO CONSTRUCT / OPERATION PERMIT / EXISTING SYSTEM

PIN # 4730-03-7904

APPLICANT: DIANA ROBINSON APPLICANT ADDRESS: 127 PARKSTONE TROUTMAN

SITE ADDRESS: SAME PHONE: 704-450-4385 ALT. PHONE: N/A

SITE DIRECTIONS: STATE PARK RD, TR PARKSTONE, C END ON L

SUBDIVISION: PARKSTONE SECTION: N/A LOT # 3 LOT AREA: 1.142 AC DESIGN FLOW: Existing L.T.A.R.: Existing

Septic Tank ____ (gal) STB ____ Date ____
Pump Tank ____ (gal) PT ____ Date ____
Pump Make EXISTING Model ____ Serial # ____
Nitrification Fields ____ # Lines ____ Linear Ft: ____
Trench Width ____ Max. Trench Bottom Depth ____ Gravel Depth ____


☐ New System ☐ Repair ☐ Expansion System Type: I (II) III IV V VI
System Description: GRAVEL
Repair System Description:
Maintenance Agreement Required: ☐ YES ☒ NO
☒ GRAVITY ☐ PRESSURE

☐ Residence No. Bedrooms EX
☐ Business No. Persons EX
☒ Other No. Employees
☐ Slab ☐ Crawl Space
☐ Basement w/plumbing ☐ Basement w/o plumbing


Water Supply: ☒ Private ☐ Public ☐ Community

Comments / Conditions: SYSTEM SEEMED TO BE FUNCTIONING PROPERLY @ TIME OF INSPECTION

INITIAL SITE SKETCH

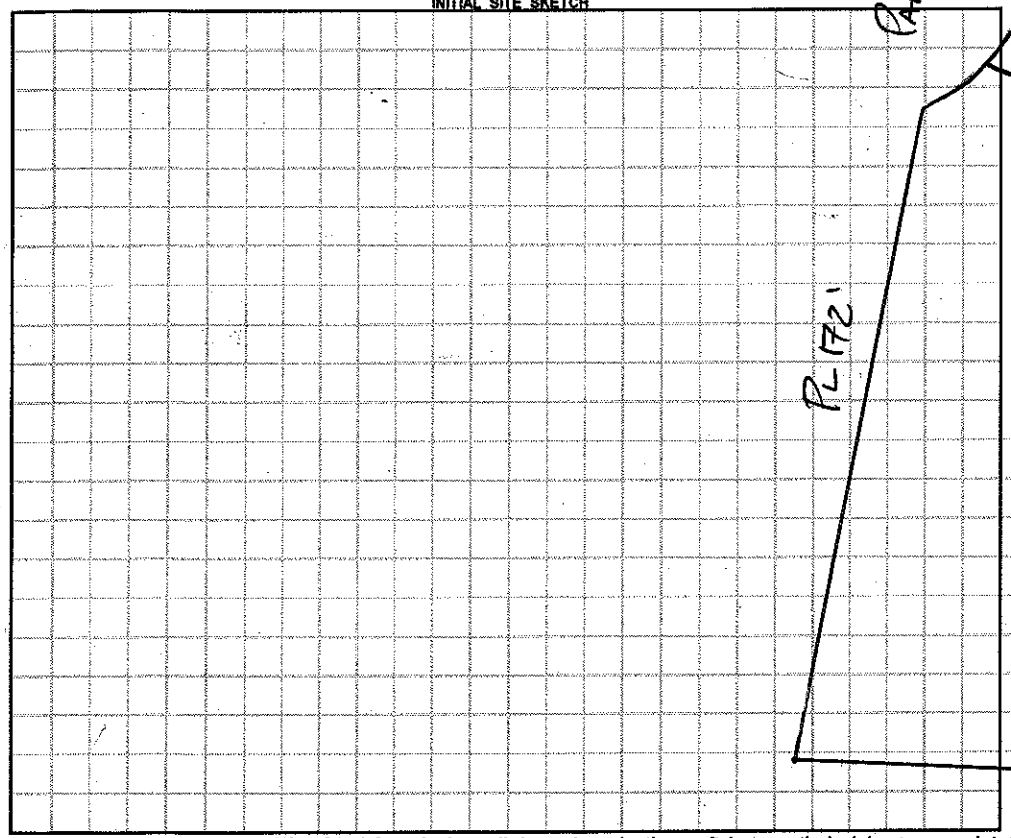

AS BUILT SKETCH

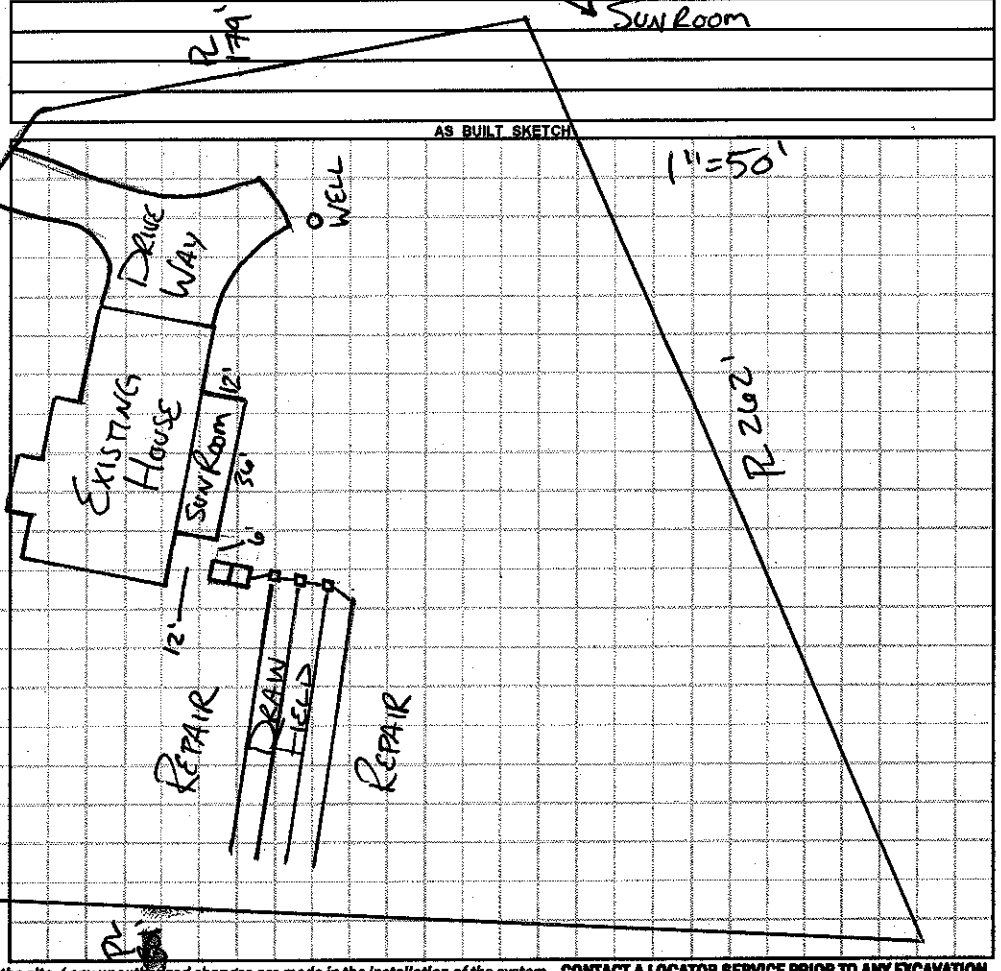

Permit can be suspended or revoked if any false information is supplied toward securing the permit / any unauthorized changes are made to the site / any unauthorized changes are made in the installation of the system. **CONTACT A LOCATOR SERVICE PRIOR TO ANY EXCAVATION**

☐ **IMPROVEMENT PERMIT** *with plat valid without expiration.* ☐ **IMPROVEMENT PERMIT** *with site plan valid for 60 mos.* ☐ **AUTHORIZATION TO CONSTRUCT** *valid for period equal to IMPROVEMENT PERMIT--not to exceed 60 mo.*

Owner / Applicant Signature: Diana Robinson Date: 7-2-15 Installed by:

IMPROVEMENT PERMIT by: Date: OPERATION PERMIT by: Date:

AUTHORIZATION TO CONSTRUCT by: Date: Existing System Inspected by: RA Date: APPROVED JUN 29 2015

Health Dept. Copy - WHITE Applicant (Final Approval) - YELLOW Applicant (Conditional Approval) - PINK