100/104/25/15/10 plc 6x5.48 32.88

IREDELL COUNTY HEALTH DEPARTMENT

STATESVILLE 704-878-5305 MOORESVILLE 704-664-5281

IMPROVEMENT PERMIT / AUTHORIZATION TO CONSTRUCT / OPERATION PERMIT / EXISTING SYSTEM INSPECTION

PERMIT# 144108 PIN# 4730849046 DATE 9/23/07

OWNER OR APPLICANT RONALD R. BURFORD PHONE: Business 704-361-0978 Home

ADDRESS P.O. BOX 217 Mt. MORRIS NC 28123

LOCATION PERTH RD (E) Stake PARK (E) PARKSTONE AT END OU RT

SUBDIVISION PARKSTONE BLOCK / SECTION LOT 67 LOT AREA 1.091 SITE CLASS PS DESIGN FLOW 480 L.T.A.R. .13

Septic Tank: 1000 Gallons: STB 317 Date 9-13-07

Pump Tank: 1000 Gallons: PT 303 Date 9-4-07

Pump Make: GOULDS Model PES1M Serial No.

Nitrification Field: No Fields 1 Square Feet EQ=1600 Linear Feet 270'

No Lines 6x45' Trench Width 24" Max Trench Bottom Depth 36" Gravel Depth N/A ☐ Gravity ☒ Pressure ☐ Slab ☒ Crawl Space ☐ Basement w/plumbing ☐ Basement wo/plumbing

☒ New System ☐ Repair ☐ Expansion System Type: I II (III) IV V VI

System Description: PUMP 50'1 REDUCT

Repair System Description: LP 50'1 REDUCT

Maintenance Agreement Required: ☐ Yes ☒ No

☒ House/Mod. Home ☐ Mobile Home ☐ Business ☐ Other

No. Bedrooms 4 No. Persons 8 No. Employees

Water Supply: ☒ Individual ☐ Public ☐ Community

Comments/Conditions: (1) DISCUSSED ALL SETBACKS WITH BUILDER (2) Install Lines on Contours & MAINTAIN SETBACKS

Comments/Conditions: MET BUILDER ON 10-8-07. Approved Partial BASEMENT PLAN drawn IN on Permit with plumbing: POLYLOK FILTER & RISERS

INITIAL SITE SKETCH

SEE ATTACHED SYSTEM DESIGN BY LORNE COOK, R.S.I.

AS BUILT SKETCH

BUILDER OK'D TANK CHANGES

Jon Burford

- Drain lines Are 104' to well on site & 100' to well at neighbors
- Drain lines Are 25' off storm water diversion / positive drainage & 15' OFF TOP OF 2' CUT
- Drain lines are 10' OFF PL that is marked


Permit can be suspended or revoked if any false information is supplied toward securing the permit/any unauthorized changes are made to the site/any unauthorized changes are made in the installation of the system. Improvement Permit with plat valid without expiration ☐ Improvement Permit with site plan valid for sixty months ☒ Authorization to Construct is valid for a period equal to that of Improvement Permit – not to exceed sixty months.

Signed: Jon Burford date 9/25/07 Installed by: RICHARD ABERNATHY

Improvement Permit by: date 9/23/07 Operation Permit by: date 1-7-09

Authorization to Construct by: date 9/23/07 Existing System Inspection by: date

HEALTH DEPT. COPY: WHITE OWNER COPY (FINAL): YELLOW OWNER COPY (INITIAL): PINK

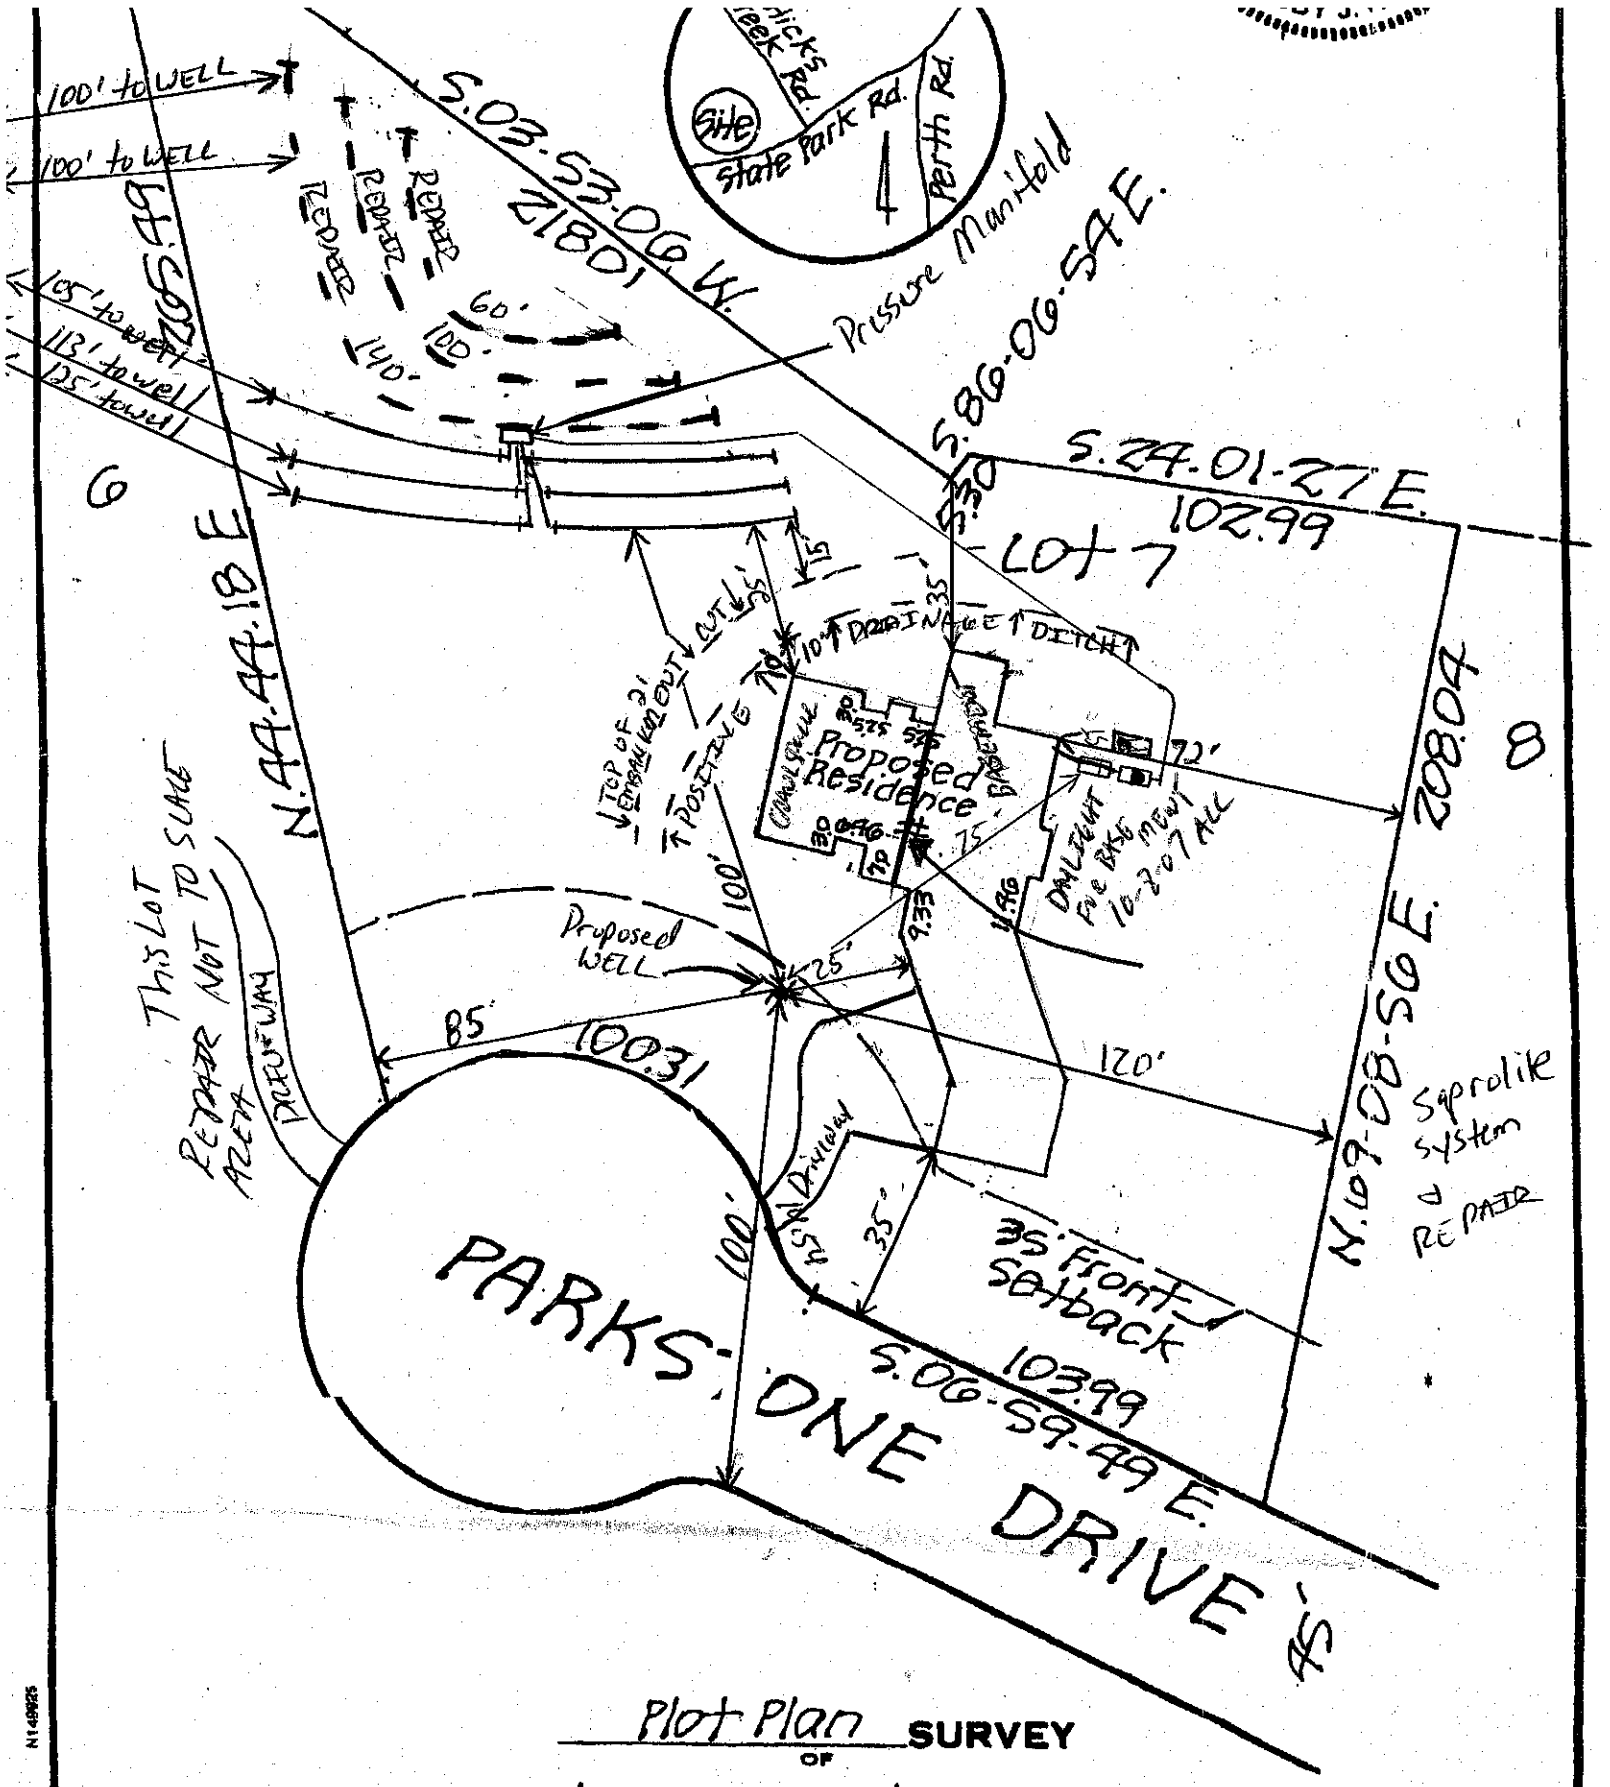

Plot Plan SURVEY
OF

Lot 7 Parkstone

SCALE 1"=40' Fallstown Township, Iredell Co., N.C.

THE PROPERTY OF Finesse Custom Contracting

MAP RECORDED IN BOOK AT PAGE DEED RECORDED IN BOOK PAGE

DUNCAN-PARNELL, INC. N1149925