12.29.11 Permit # 170020 attached for building addition on site / 130.00 Paid

IREDELL COUNTY HEALTH DEPARTMENT

STATESVILLE 704-878-5305 MOORESVILLE 704-664-5281

IMPROVEMENT PERMIT / AUTHORIZATION TO CONSTRUCT / OPERATION PERMIT / EXISTING SYSTEM INSPECTION

PERMIT# 114684 PIN# 4730-05-7028-8 9109 DATE Nov. 16, 04

OWNER OR CONTRACTOR Russ Graham // Touchstone Dev PHONE: Business Home

ADDRESS 105 Wildwood Cove Dr. Mooresville, N.C. 28117

LOCATION Perth Rd N. TL State Park Rd TR Hicks Creek Rd. TL Leah Lane on left NEAR end

SUBDIVISION Sarahs Creek BLOCK / SECTION LOT 8 LOT AREA .70 Ac SITE CLASS PS DESIGN FLOW 360 gpd L.T.A.R. .25

Septic Tank: 1000 Gallons; STB 825 Date 3-31-00

Pump Tank: Gallons; PT Date

Pump Make: Model Serial No.

Nitrification Field: No Fields 1 Square Feet 1080 Linear Feet 360

No Lines 3 Trench Width 36" Max Trench Bottom Depth 36"

☐ New System ☐ Repair System Type: I, II, III, IV, V, VI

System Description: Gravity 25% Reduction

Repair System Description: LPP PBPS

Maintenance Agreement Required: ☐ Yes ☒ No

Gravel Depth NA

☒ House/Mod. Home No. Bedrooms 3

☐ Mobile Home No. Bathrooms

☐ Business No. Employees

☐ Other


☐ Slab ☒ Crawl Space ☐ Basement w/plumbing ☐ Basement wo/plumbing

Water Supply: ☒ Individual ☐ Public ☐ Community


Comments:/Conditions: Install on contour — Maintain 100 feet from well to Septic system

Comments:/Conditions: Blue Poly Tech Septic tank Mfg

1" = 50' INITIAL SITE SKETCH

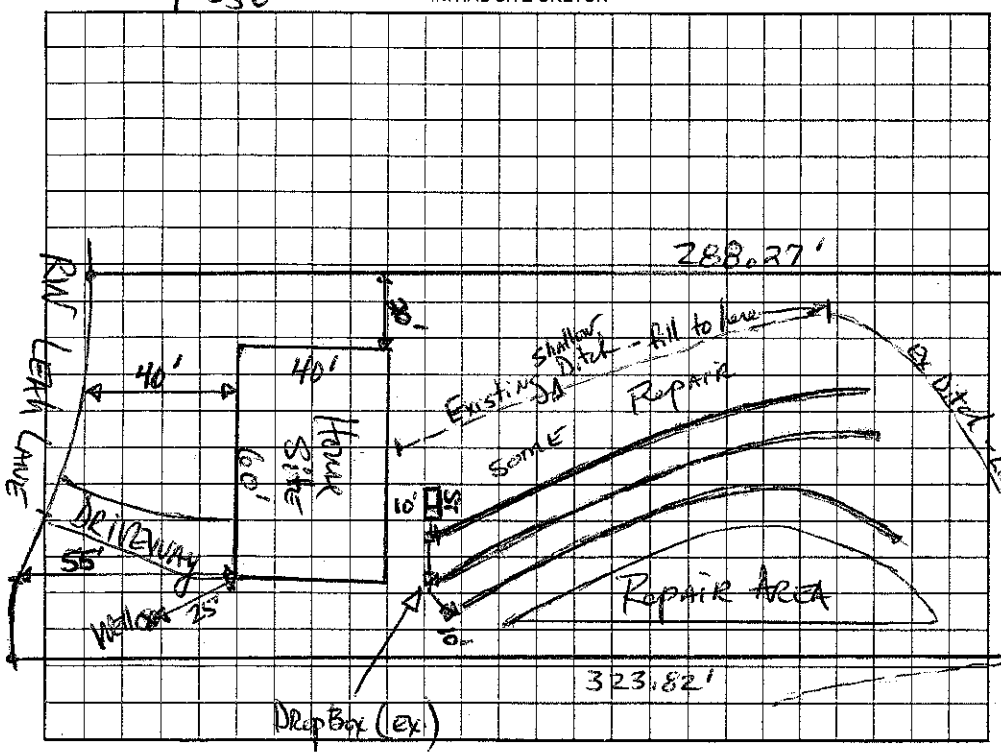

AS BUILT SKETCH

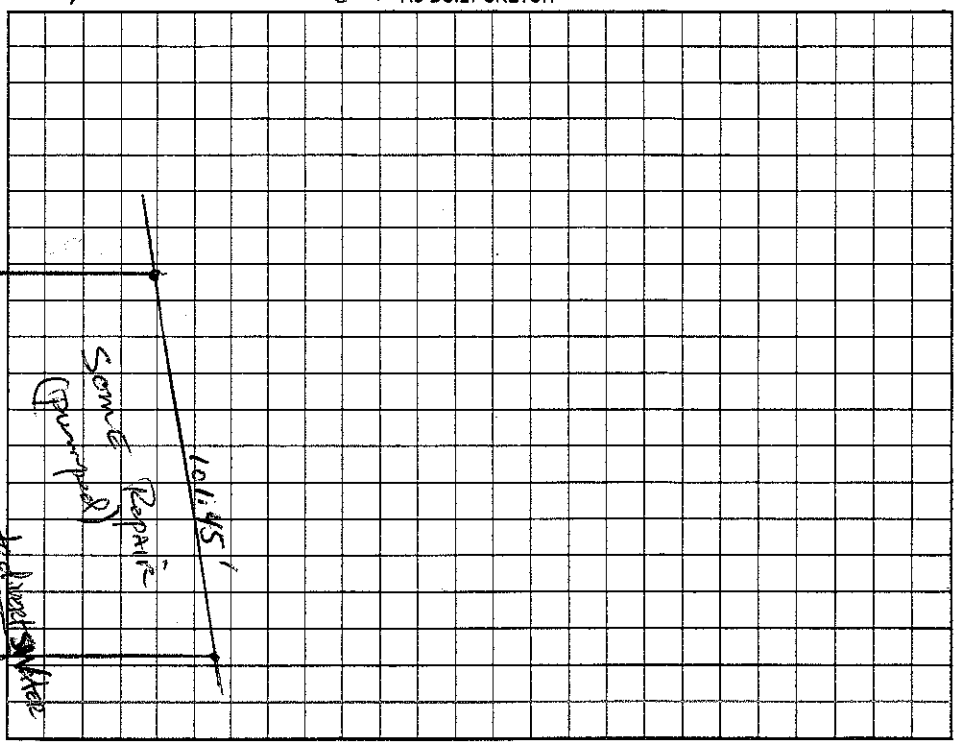

Permit can be suspended or revoked if any false information is supplied toward securing the permit/any unauthorized changes are made to the site/any unauthorized changes are made in the installation of the system. Improvement Permit with plat valid without expiration. Improvement Permit with site plan valid for sixty months. Authorization to Construct is valid for a period equal to that of Improvement Permit – not to exceed sixty months.

Signed: date 12/22/04 Installed by: Rowan Septic

Improvement Permit by: date 11-16-04 Operation Permit by: date 5-11-06

Authorization to Construct by: date 7-29-05 Existing System Inspection by: date

HEALTH DEPT. COPY: WHITE OWNER COPY (FINAL): YELLOW OWNER COPY (INITIAL): PINK