IREDELL COUNTY HEALTH DEPARTMENT - *ENVIRONMENTAL HEALTH* ☑ STATESVILLE OFFICE 704-878-5305 ☐ MOORESVILLE OFFICE 704-664-5281

IMPROVEMENT PERMIT / AUTHORIZATION TO CONSTRUCT / OPERATION PERMIT / EXISTING SYSTEM INSPECTION

PERMIT # 170495 PIN # 4730-05-9963 DATE MARCH 19, 2012

OWNER RONALD BROOME APPLICANT: SAME PHONE: Home/Cell # 704-902-2057 Business # 704-528-6837

SITE ADDRESS HICKS CREEK ROAD OWNER / APPLICANT ADDRESS P.O. BOX 248, TROUTMAN NC 28166

SITE DIRECTIONS STATE PARK ROAD TO HICKS CREEK ROAD, ON RIGHT ACROSS FROM LEATH LANE

SUBDIVISION N/A BLOCK / SECTION N/A LOT # N/A LOT AREA 4 ACRES DESIGN FLOW 480 L.T.A.R. 0.30 GPD/FT

Septic Tank 1000 Gallons: STB 1012 Date 11-15-11

Pump Tank ____ Gallons: P T ____ Date ____

Pump Make ____ Model ____ Serial # ____

No. Nitrification Fields: 1 No. Lines 5 Linear Feet 400

Trench Width 36" Max. Trench Bottom Depth 36" Gravel Depth N/A

☑ New System ☐ Repair ☐ Expansion System Type I II (III) IV V VI

System Description: 25% REDUCTION GRAVITY

Repair System Description: 25% REDUCTION, PUMP

Maintenance Agreement Required ☐ YES ☑ NO

☑ GRAVITY ☐ PRESSURE

☑ Residence No. Bedrooms 4

☐ Business No. Persons ____

☐ Other No. Employees ____


☐ Slab ☐ Crawl Space

☐ Basement w/plumbing ☐ Basement w/o plumbing


Water Supply: ☑ Private WELL ☐ Public ☐ Community

Comments / Conditions INSTALL 25% REDUCTION SYSTEM ON CONTOUR USING ~~SERIAL~~ DISTRIBUTION

INITIAL SITE SKETCH

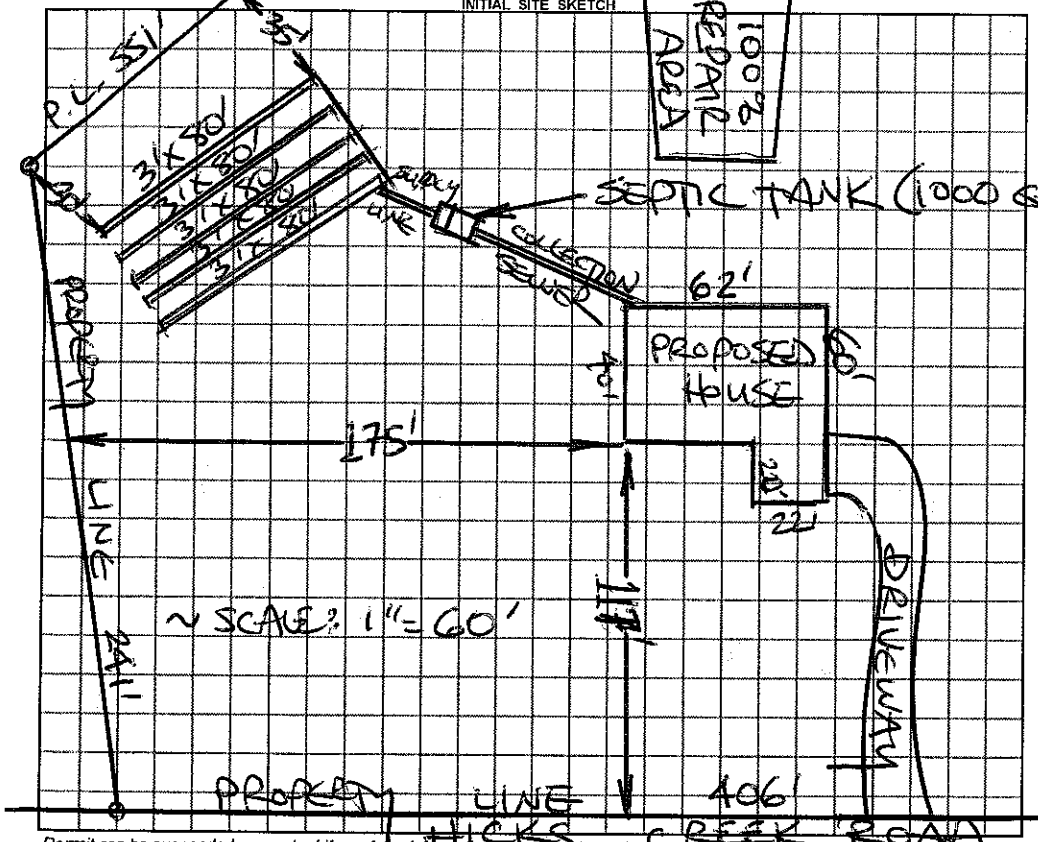

AS BUILT SKETCH

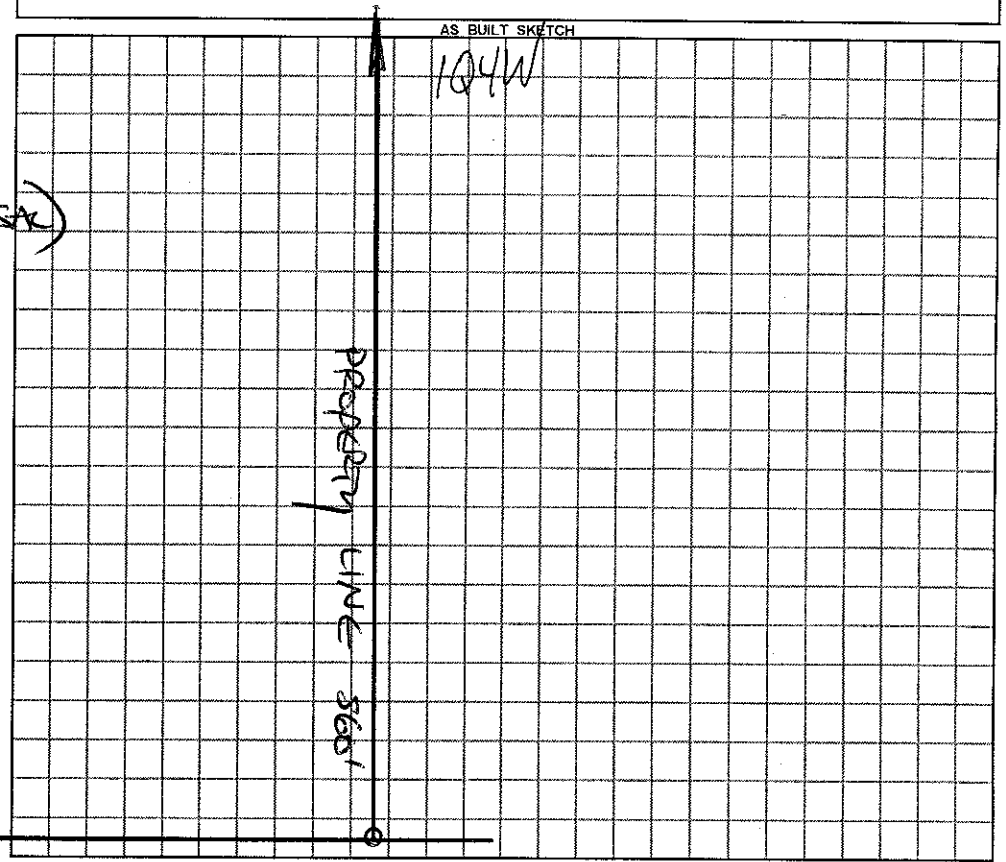

Permit can be suspended or revoked if any false information is supplied toward securing the permit / any unauthorized changes are made to the site / any unauthorized changes are made in the installation of the system.

☐ ***IMPROVEMENT PERMIT*** with plat valid without expiration. ☑ ***IMPROVEMENT PERMIT*** with plat ~~valid without expiration~~ site plan valid 60 mo. ☑ ***AUTHORIZATION TO CONSTRUCT*** valid for period equal to IMPROVEMENT PERMIT--not to exceed 60 mo.

Owner / Applicant Signature: Ronnie Broome Date 3/20/12 Installed by: Tommy Frye

IMPROVEMENT PERMIT by: R. STEVE HEDRICK REHS Date 3-19-12 OPERATION PERMIT by: ____ REHS Date 8-9-12

AUTHORIZATION TO CONSTRUCT by: R. STEVE HEDRICK REHS Date 3-19-12 Existing System Inspected by: ____ REHS Date ____

YOU SHOULD CONTACT A LOCATOR SERVICE PRIOR TO ANY EXCAVATION

White Copy – Environmental Health YELLOW COPY (Final) Owner / Applicant PINK COPY (Initial) Owner / Applicant