Permit #157290 attached for accessory Bldg addition in 2009 902-0086 HSE PLANS

IREDELL COUNTY HEALTH DEPARTMENT

STATESVILLE 704-878-5305 MOORESVILLE 704-664-5281

IMPROVEMENT PERMIT / AUTHORIZATION TO CONSTRUCT / OPERATION PERMIT / EXISTING SYSTEM INSPECTION

PERMIT# 134315 PIN# 4730061221 DATE 4-3-06

OWNER OR APPLICANT CHARLES SIDES PHONE: Business 704-579-8630 Home 704-663-3310

ADDRESS 725 EMERSON DR MOORESVILLE NC 28115

LOCATION PERTH RD SOUTH ② HICKS CREEK ③ CORNER OF HICKS CREEK & OLD SPRUCE WAY

SUBDIVISION CEDAR WOOD BLOCK / SECTION ____ LOT 1 LOT AREA 1.294 AC SITE CLASS. PS DESIGN FLOW 360 L.T.A.R. .3

Septic Tank: 1000 Gallons; STB 794 Date 3-26-07
Pump Tank: ____ Gallons; PT ____ Date ____
Pump Make: ____ Model ____ Serial No. ____
Nitrification Field: No Fields 1 Square Feet EQ=1200' Linear Feet 300'
No Lines 4@75' Trench Width 36" Max Trench Bottom Depth 36"

☒ New System ☐ Repair ☐ Expansion System Type: I II III IV V VI
System Description: 60% 25% REDUCTION
Repair System Description: LP 50% REDUCT
Maintenance Agreement Required: ☐ Yes ☒ No

☒ House/Mod. Home ☐ Mobile Home ☐ Business ☐ Other
No. Bedrooms 3 No. Persons 6 No. Employees ____


Water Supply: ☒ Individual ☐ Public ☐ Community

Gravel Depth NA ☒ Gravity ☐ Pressure ☐ Slab ☐ Crawl Space ☒ Basement w/plumbing ☐ Basement wo/plumbing

Comments/Conditions: ① SL + BASEMENT LOT AT NATURAL GRADE AND DEG INTO HILL ② MAINTAIN SETBACKS. ③ REED SYSTEM 10' BELOW & 15' TO THE SIDE OF TRENCH PATH


INITIAL SITE SKETCH

1"=50'

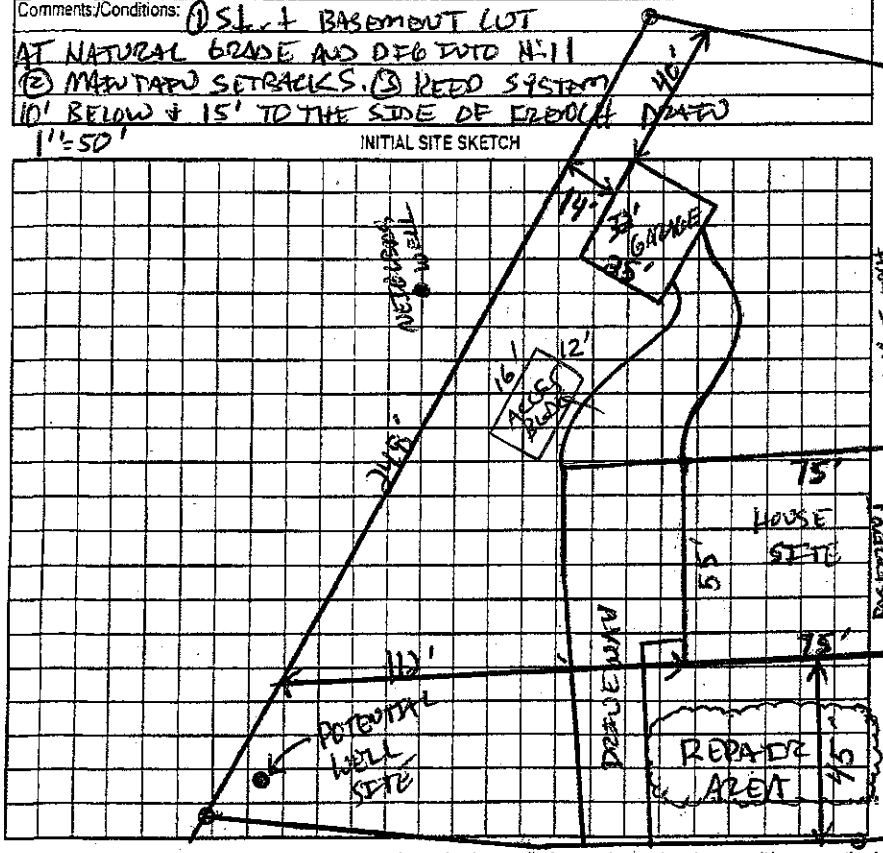

Comments/Conditions: POLYLOK F. Her ✓ LINES & TANK NEEDS FRENCH DRAIN INSTALLER WILL MARK END OF LINES

AS BUILT SKETCH & Instl'd FD 5' OFF HOUSE

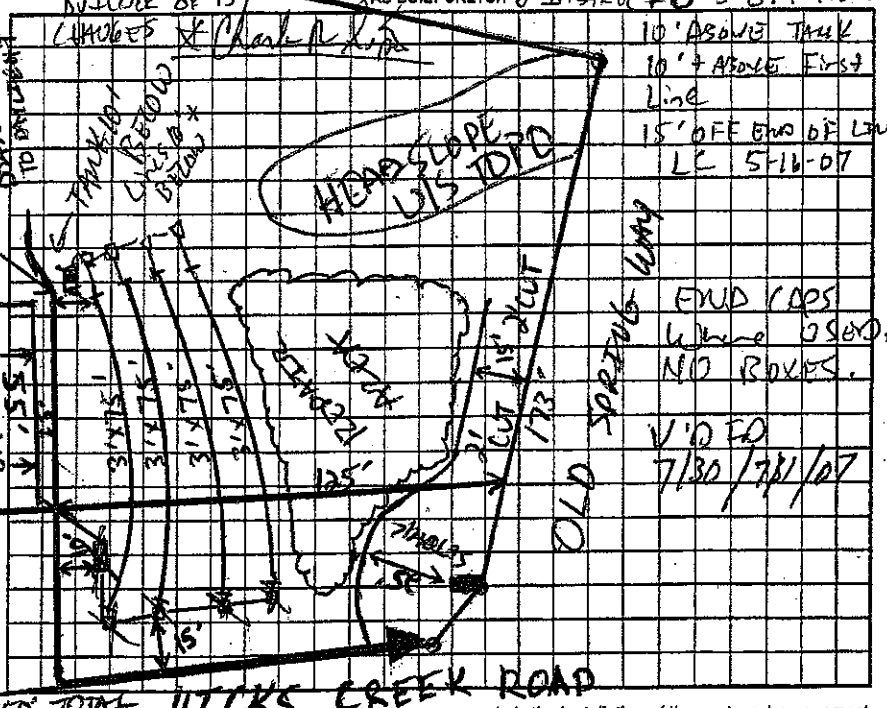

Permit can be suspended or revoked if any false information is supplied toward securing the permit/any unauthorized changes are made to the site/any unauthorized changes are made in the installation of the system. Improvement Permit with plat valid without expiration. ☐ Improvement Permit with site plan valid for sixty months ☒ Authorization to Construct is valid for a period equal to that of Improvement Permit – not to exceed sixty months.

Signed: ____ date ____

Improvement Permit by: [signature] date 4-3-06

Authorization to Construct by: [signature] date 4-3-06

HEALTH DEPT. COPY: WHITE OWNER COPY (F

Location of the proposed 12' x 16' ACCESS. BLDG addition does not appear to impact the existing on-site septic system.** NOTE: 5/1-07

R. STEVE HEDRICK REHS

Date: NOV. 28, 2012

ICHD-Environmental Health Division