This Permits replaces previous Permit # 141635 issued on 6-19-07 + permit #141087

IREDELL COUNTY HEALTH DEPARTMENT

STATESVILLE 704-878-5305 — MOORESVILLE 704-664-5281 144 Timber Lake Drive

IMPROVEMENT PERMIT / AUTHORIZATION TO CONSTRUCT / OPERATION PERMIT / EXISTING SYSTEM INSPECTION

PERMIT # 141635 PIN # 4730108347 DATE 12-7-12

OWNER or APPLICANT Falls Cove Dev. LLC PHONE: Business 704-400-8932 Home: N/A

OWNER or APPLICANT ADDRESS 2215 Brawley School Rd.

LOCATION / DIRECTIONS Morrison Farm Rd South TL Gmeral Creek TR Timber lake Dr.

SUBDIVISION Parkwood @ Falls Cove BLOCK / SECTION Ph 6 LOT # 637-638 LOT AREA 4.27 acres DESIGN FLOW 480 gpd L.T.A.R. 0.03

Septic Tank 1500 Gallons: STB 338 Date 9-8-13
Pump Tank 1500 Gallons: PT 4477 Date 9-13-08
Pump Make Goulds Model WE1012HU Serial # 2HP
Nitrification Field No Fields 1 No Lines 3 Linear Feet 400'
Trench Width 36" Max. Trench Bottom Depth 36" Gravel Depth N/A

☑ New System ☐ Repair ☐ Expansion System Type I II (III) IV V VI
System Description: 25% Reduction PM
Repair System Description: LPD Pressure PPBPS
Maintenance Agreement Required ☐ YES ☑ NO
☐ GRAVITY ☑ PRESSURE


☑ Residence No. Bedrooms 4
☐ Business No. Persons
☐ Other No. Employees
☐ Slab ☐ Crawl Space
☑ Basement w/plumbing ☐ Basement w/o plumbing

Water Supply: ☐ Private ☑ Public ☐ Community


Comments / Conditions: Refer to STMC & system design Plan for Lot #638A; Improvement ONLY! Need easements prior to issuance of CA.

Comments / Conditions

INITIAL SITE SKETCH

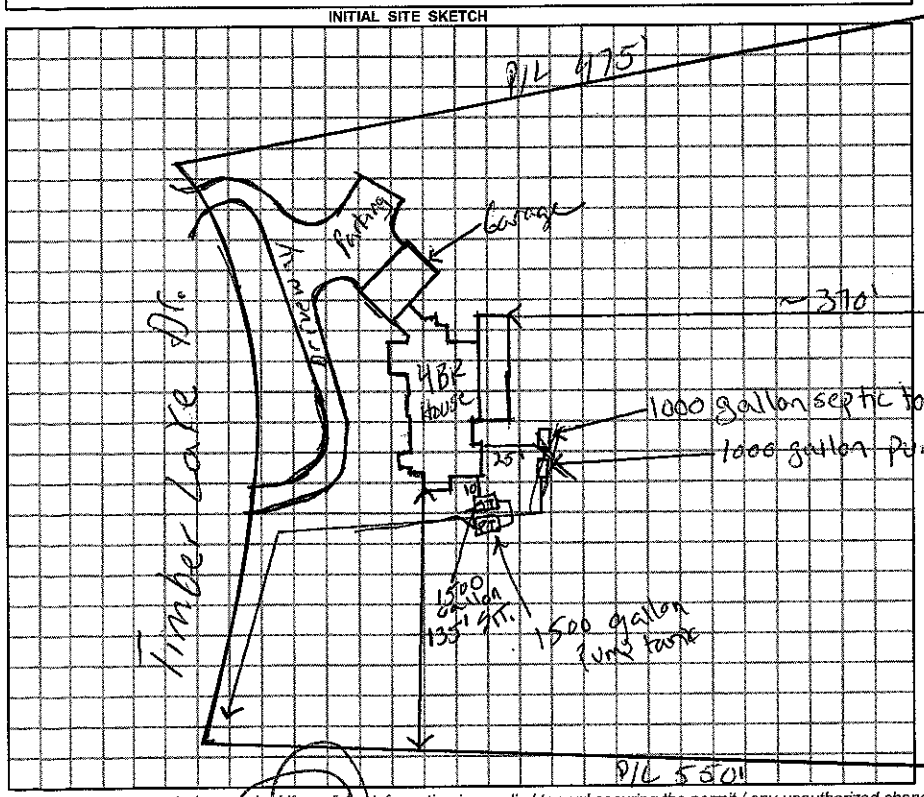

AS BUILT SKETCH

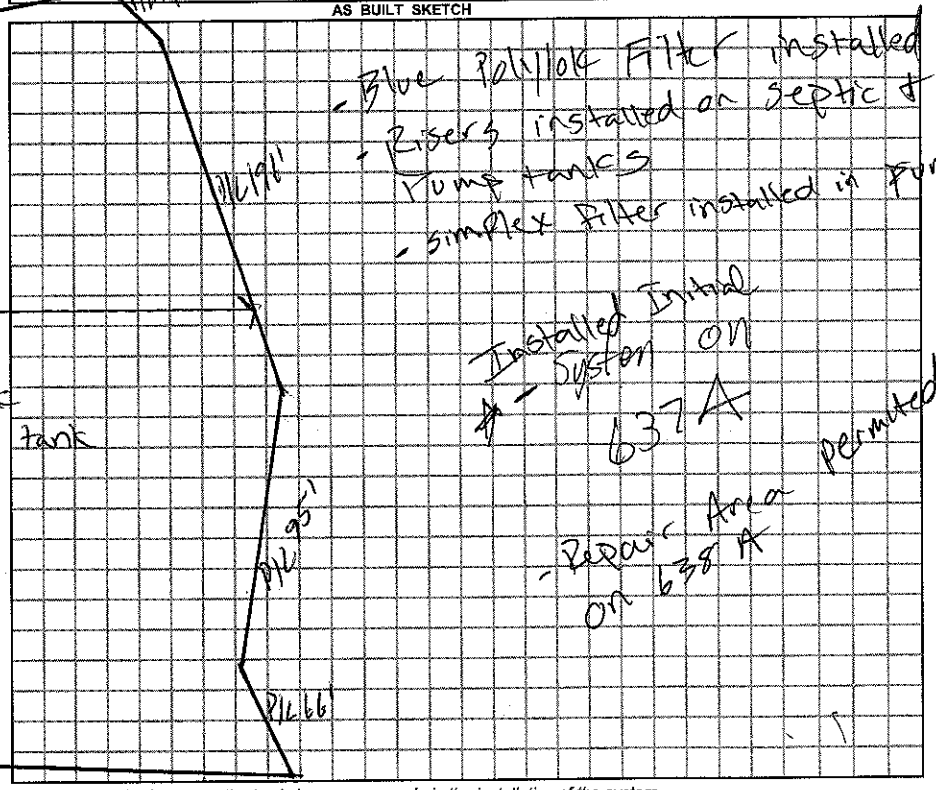

Permit can be suspended or revoked if any false information is supplied toward securing the permit / any unauthorized changes are made to the site / any unauthorized changes are made in the installation of the system.

☐ IMPROVEMENT PERMIT w / plat valid without expiration ☑ IMPROVEMENT PERMIT w / site plan valid for 60 mos. ☑ AUTHORIZATION TO CONSTRUCT valid for period equal to IMPROVEMENT PERMIT-not to exceed 60 mo.

Owner / Applicant Signature: [signature] Date 2-19-13

Improvement Permit by: Justin Henderson Date 12-7-12

Authorization to Construct by: Justin Henderson Date 2-5-13

Installed by: L & B Builders

Operation Permit by: Justin Henderson Date: 1-23-14

Existing System Inspected by: Date:

YOU SHOULD CONTACT A LOCATOR SERVICE PRIOR TO ANY EXCAVATION.

WHITE COPY Environmental Health YELLOW COPY (Final) Owner / Applicant PINK COPY (Initial) Owner / Applicant