1.00

THIS PERMIT VOIDS PREVIOUS PERMITS #141047 & 141052

IREDELL COUNTY HEALTH DEPARTMENT - *ENVIRONMENTAL HEALTH* ☑ STATESVILLE OFFICE 704-878-5305 ☐ MOORESVILLE OFFICE 704-664-5281

IMPROVEMENT PERMIT / AUTHORIZATION TO CONSTRUCT / OPERATION PERMIT / EXISTING SYSTEM INSPECTION

PERMIT # 168588 PIN # 4730-11-3988 DATE SEPTEMBER 22, 2011

OWNER MICHAEL P. KOEPEL APPLICANT: PINNACLE BUILDING PHONE: Home/Cell # 704-799-8641 Business #

SITE ADDRESS 115 EMERALD CREEK DRIVE OWNER / APPLICANT ADDRESS

SITE DIRECTIONS STATE PARK RD, TO MORRISON FARM RD, TL EMERALD CREEK DR, 1ST LOT ON LEFT

SUBDIVISION PARKWOOD @ FALLS COVE BLOCK / SECTION 6 LOT # 655 LOT AREA 2.63 ACRES DESIGN FLOW 480 L.T.A.R. 0.30 GPD/FT²

Septic Tank 1000 Gallons: STB 1012 Date 9-11-11

Pump Tank ____ Gallons: P T ____ Date ____

Pump Make ____ Model ____ Serial # ____

No. Nitrification Fields: 1 No. Lines 4 Linear Feet 400

Trench Width 36" Max. Trench Bottom Depth 36" Gravel Depth N/A

☑ New System ☐ Repair ☐ Expansion System Type I II (III) IV V VI

System Description: 25% REDUCTION, GRAVITY

Repair System Description: 25% REDUCTION, GRAVITY

Maintenance Agreement Required ☐ YES ☑ NO

☑ GRAVITY ☐ PRESSURE

☑ Residence No. Bedrooms 4

☐ Business No. Persons ____

☐ Other No. Employees ____


☐ Slab ☑ Crawl Space

☐ Basement w/plumbing ☐ Basement w/o plumbing


Water Supply: ☐ Private ☑ Public ☐ Community

Comments / Conditions: INSTALL 25% REDUCTION SYSTEM ON CONTOUR AS SHOWN, NO DEEPER THAN 36 INCHES.

INITIAL SITE SKETCH

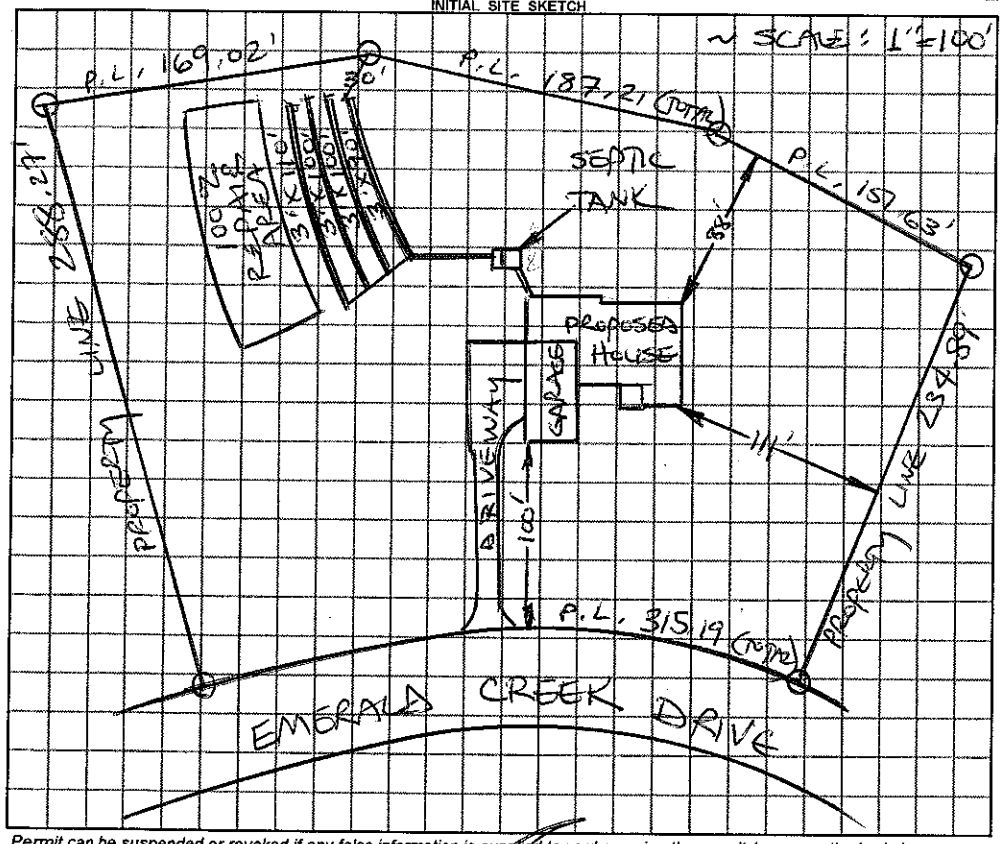

AS BUILT SKETCH

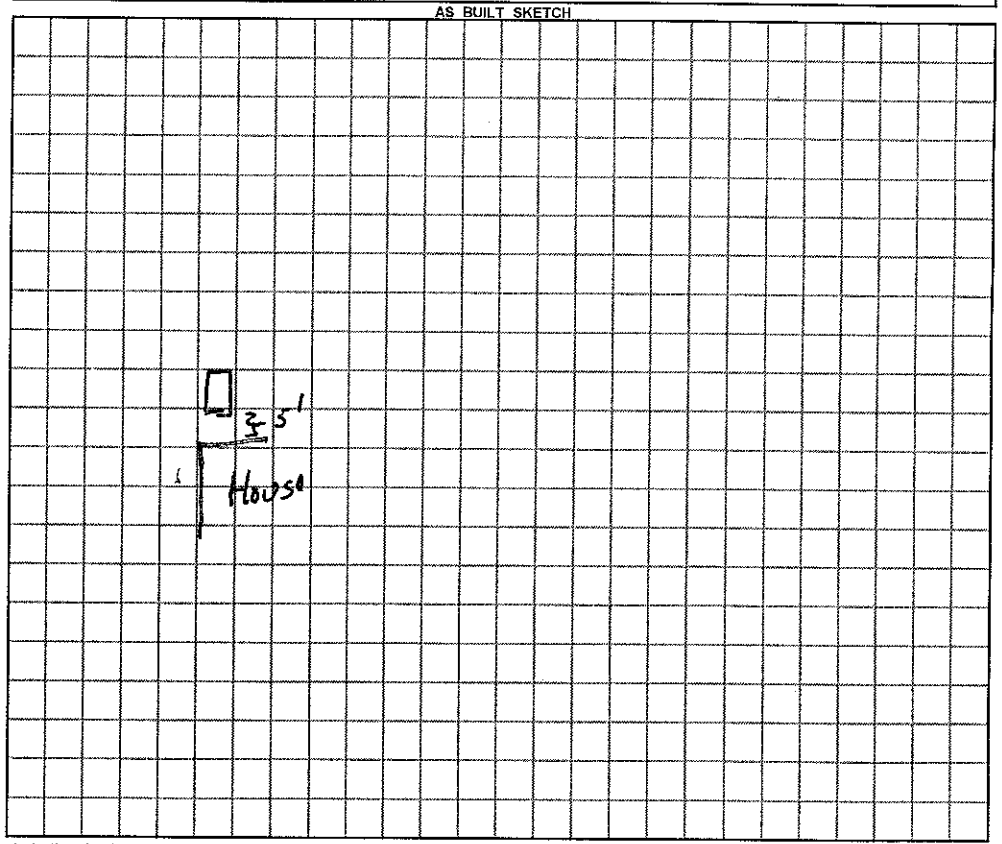

Permit can be suspended or revoked if any false information is supplied toward securing the permit / any unauthorized changes are made to the site / any unauthorized changes are made in the installation of the system.

☐ ***IMPROVEMENT PERMIT*** with plat valid without expiration ☐ ***IMPROVEMENT PERMIT*** with ~~plat valid without expiration~~ site plan valid 60 mo. ☐ ***AUTHORIZATION TO CONSTRUCT*** valid for period equal to IMPROVEMENT PERMIT--not to exceed 60 mo.

Owner / Applicant Signature: _____ Date 9/26/11

IMPROVEMENT PERMIT by: R. STEVE HEDRICK REHS Date 9-22-2011

AUTHORIZATION TO CONSTRUCT by: _____ REHS Date 9-26-11

YOU SHOULD CONTACT A LOCATOR SERVICE PRIOR TO ANY EXCAVATION

Installed by: Steve Jordan

OPERATION PERMIT by: _____ REHS Date 4-24-12

Existing System Inspected by: _____ REHS Date _____

White Copy – Environmental Health YELLOW COPY (Final) Owner / Applicant PINK COPY (Initial) Owner / Applicant