IREDELL COUNTY HEALTH DEPARTMENT *ENVIRONMENTAL HEALTH DIVISION*

(THE ABOVE PERMIT DOCUMENTS WILL BECOME INVALID IF INFORMATION PROVIDED ON THIS APPLICATION IS FALSIFIED OR CHANGED, OR IF THE SITE IS ALTERED. THE IMPROVEMENT PERMIT IS VALID FOR EITHER 60 MONTHS OR WITHOUT EXPIRATION DEPENDING UPON DOCUMENTATION SUBMITTED - APPLICATION WITH SITE PLAN 60 MONTHS, APPLICATION WITH COMPLETE, SCALED PLAT WITHOUT EXPIRATION. SEE 15A NCAC 18A .1937(f) FOR DETAILS)

1. APPLICATION FOR: X Improvement Permit X Authorization To Construct ___ Existing System Inspection

2. Page 2: *Site Plan Worksheet* Form MUST Accompany This Application
The following optional attachments may also be submitted: ___Survey Plat, Scaled no more than 1 Inch = 60 Feet
Place check ( ) beside whichever is submitted if applicable ___Custom Site Plan, Scaled no more than 1 Inch = 60 Feet

3. **Applicant Information:**

Applicant Name	Mailing Address	Home Phone #	Alternate Phone #
MARK & LISA MICHEL	719 GEORGIE ST TROUTMAN NC 28166	7045283377	7047468640
Owner Name	**Mailing Address**	**Home Phone #**	**Alternate Phone #**
SAME AS ABOVE		WCS	704-902-4339

4. **Property Information:**

Street Address	Subdivision Name	Section/Phase and Lot Number
128 SILVER FALLS DRIVE TROUTMAN NC 28166	FALLS COVE	PARKWOOD LOT 648

Driving Directions: FROM PERTH ROAD TURN ONTO STATE PARK ROAD, LEFT ONTO MORRISON FARM ROAD, LEFT ONTO SILVER FALLS DRIVE 2ND LOT ON RIGHT

5. **RESIDENTIAL Site Development Information:** *(Check or Complete ALL that apply)*

(✓) New, Single Family Residence	Maximum Number of Bedrooms 4	(✓) Crawl Space Foundation?
( ) New, Multi-Family Residence	Maximum Number of Occupants 4	( ) Concrete Slab Foundation?
( ) Expansion of Existing Septic System	If Expansion, Current Number of Bedrooms ___	( ) Basement w/Plumbing?
( ) Repair To Failing Septic System due to ___		( ) Basement w/out Plumbing?
( ) Other ___		

IF Non- Residential Site Development: Type of Business ___
Square Footage of Building ___
Maximum Number of Employees ___
Maximum Number of Seats ___

6. **Proposed Water Supply:**

( ) New Well ( ) Existing Well ( ) Community Well (✓) City Water ( ) Other Public Water

7. **Desired Septic System Type:** *(You may rank in order of preference, if any)* ( ) EXISTING SYSTEM installed ___ *Year*

( ) Alternative ( ) Conventional ( ) Innovative ( ) Modified Conventional ( ) Other___

8. **Please Answer The Following** ( ) Yes (✓) No Does the site contain any jurisdictional wetlands?
To The Best of Your Ability: ( ) Yes (✓) No Is any non-domestic sewage (i.e. industry) to be generated?
( ) Yes (✓) No Is the site subject to approval by any other public agency?


I have read this application and certify that the information provided herein is true, complete, and correct. Authorized county and state officials are granted right of entry to conduct necessary inspections to determine compliance with applicable laws and rules. I understand that I am solely responsible for the proper identification and labeling of all property lines and corners and making the site accessible so that a complete site evaluation can be performed.

9. **Signature:** [signature] BY [signature] 03 18 10
Property owner or owner's legal representative signature (SIGNATURE REQUIRED) DATE

Justin Henderson

From: Landmark Landscape Services <mark@landmarklandscapeservices.com>
Sent: Wednesday, April 27, 2016 10:40 PM
To: Justin Henderson
Subject: Re: Appeal Rights form
Attachments: IMG_8073.jpeg

Please see attached. Please confirm it came through fine.
Mark

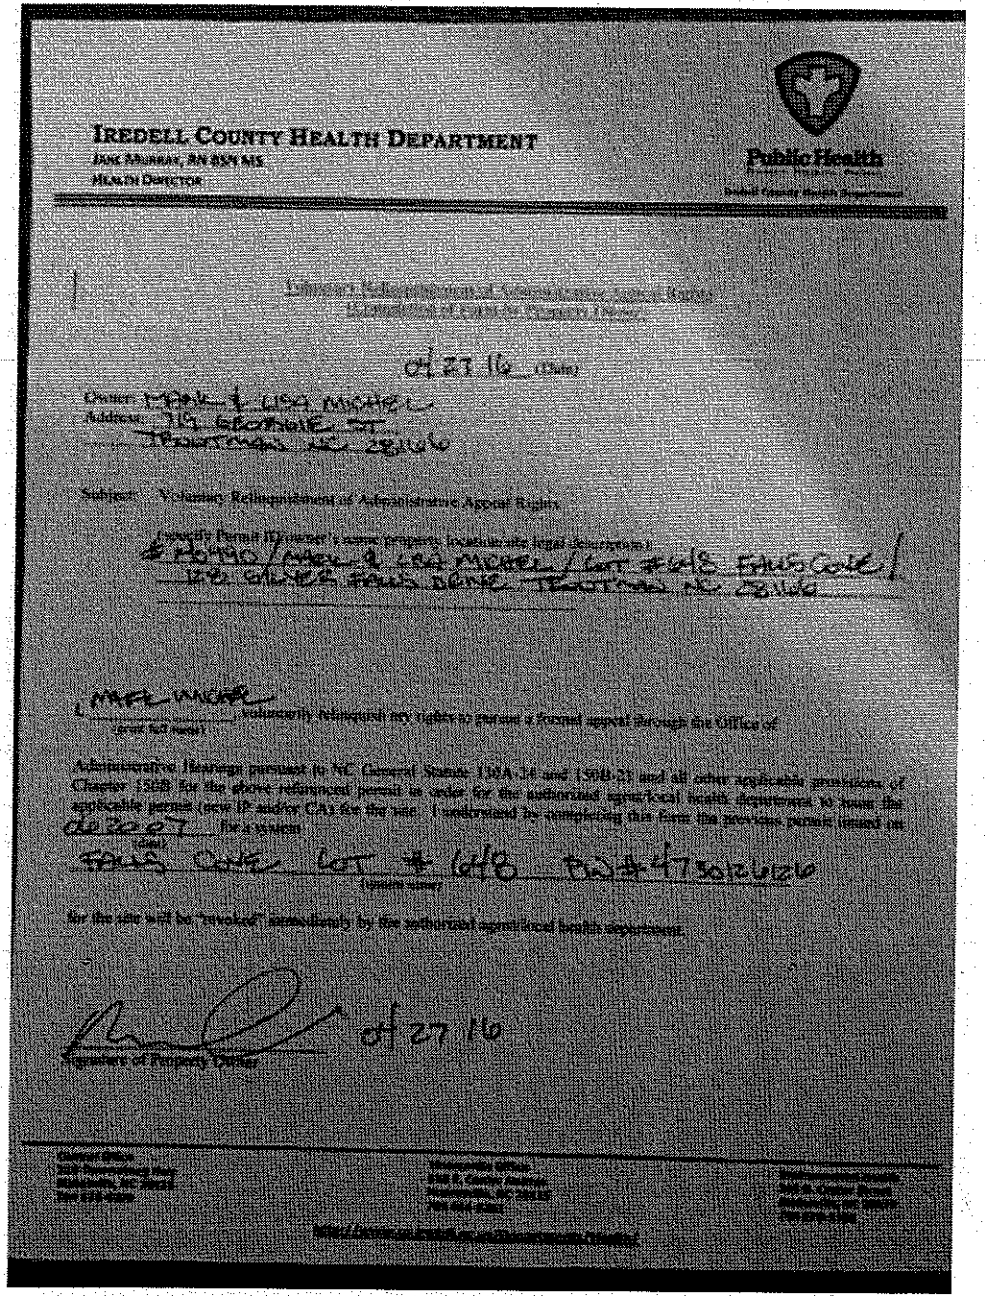

IREDELL COUNTY HEALTH DEPARTMENT

Public Health

04 27 16 (Date)

Subject: Voluntary Relinquishment of Administrative Appeal Rights

(specify Permit #/owner's name/property location/site legal description)


I understand by completing this form the previous permit issued on 04 20 07 (date) for a system

FALLS COVE LOT # 648 PIN #: 4750126126 (system owner)

for the site will be "revoked" immediately by the authorized agent/local health department.

Signature of Property Owner 04 27 16

IREDELL COUNTY HEALTH DEPARTMENT

JANE MURRAY, RN BSN MS
HEALTH DIRECTOR

Public Health
Prevent. Promote. Protect.
Iredell County Health Department

Notice of Intent to SUSPEND/REVOKE Improvement Permit/Construction Authorization

4/26/16 (Date)

Owner: Mark Michel
Address: 719 Georgie St.
Troutman, NC 28166

Subject: Notice of Intent to Revoke/Suspend Falls Cove Dev./Permit # 140990 (**specify name/location**) Improvement Permit/Construction Authorization

Dear Mark Michel:
(Owner's Name)

The Iredell County Health Department (ICHD) inspected the site for the on-site wastewater system located at 128 Silver Falls Dr. (physical address) for compliance with the Laws (Article 11 of Chapter 130A of the North Carolina General Statutes), Rules (15A NCAC 18A .1900 et seq.), and Improvement Permit/Construction Authorization 25% Reduction, Permit # 140990 (specify type and number) conditions. As a result of this inspection, the Department has determined the following violations:

Violation	Law or Rule Citation
Proposed Building Envelope moved from previously permitted building area	

[Example #1 - 18 inches of soil removed from site in violation of NCGS 130A-335(f), Rule .1937(g), Rule .1943, Rule .1947(c), and IP Condition No. 2.]
[Example #2 - Nitrification trenches installed at a depth of 30 inches in violation of Rule .1955 (m) and CA Condition No. 2.]

This is to notify you that based on these violations, the Department intends to suspend/revoke (specify) your Improvement Permit/Construction Authorization (specify) 30 days from the date of this notice.

If the ICHD determines that all of the violations have been corrected before thirty (30) days expire, the suspension/revocation (specify) will not go into effect. *[Insert for suspension]* If the permit is suspended, the health department must determine that the violations have been corrected before the suspension will be lifted. *[Insert for revocation]* If the permit is revoked, you must apply for a new Improvement Permit/Construction Authorization and meet the requirements of the current laws and rules necessary to obtain a new IP/CA.

You have a right to an informal review of this decision. You may request an informal review by the environmental health supervisor at the local health department. You may also request an informal review by the NC Department of Health and Human Services Regional Soil Scientist. A request for informal review must be made in writing to the local health department.

You also have a right to a formal appeal of this decision. To pursue a formal appeal, you must file a petition for a contested case hearing with the Office of Administrative Hearings, 6714 Mail Service Center, Raleigh, NC 27699-6714. You may write the Office of Administrative Hearings, call the office at (919) 431-3000 or get a copy of the petition form from the OAH web site at http://www.ncoah.com/forms.html . The petition for a contested case hearing must be filed in accordance with the provision of North Carolina General Statutes 130A-24 and 150B-23 and all other applicable provisions of Chapter 150B. North Carolina General Statute 130A-335 (g) provides that your hearing would be held in the county where your property is located.

If you wish to pursue a formal appeal, you must file the petition form with the Office of Administrative Hearings **WITHIN 30 DAYS OF THE DATE OF THIS LETTER.** The date of this letter is April 26th, 2016. Meeting the 30 day deadline is critical to your formal appeal.

If you file a petition for a contested case hearing with the Office of Administrative Hearings, you are required by law (NC General Statute 150B-23) to serve a copy of your petition on the Office of General Counsel, NC Department of Health and Human Services, 2001 Mail Service Center, Raleigh, NC 27699-2001.

Do not serve the petition on your local health department. Sending a copy of your petition to the local health department will not satisfy the legal requirement in NC General Statute 150B-23 that you send a copy to the Office of General Counsel, 2001 Mail Service Center, NC Department of Health and Human Services.

You may contact our office at 704-878-5305 x3456 or by fax at 704-871-3483.

Sincerely,

Justin Henderson

Signature of DHHS Authorized Agent

IREDELL COUNTY HEALTH DEPARTMENT

STATESVILLE 704-878-5305 MOORESVILLE 704-664-5281

IMPROVEMENT PERMIT / AUTHORIZATION TO CONSTRUCT / OPERATION PERMIT / EXISTING SYSTEM INSPECTION

PERMIT# 140990 PIN# 473010 9262.648 DATE 6-20-07

OWNER OR APPLICANT Falls Cove Dev. LLC PHONE: Business Home

ADDRESS 2215 Brawley School Rd Mooresville NC 28115

LOCATION State Park Rd TL Morrison Farm TR Emerald Creek TR Timberlake TL Silver Falls on right

SUBDIVISION Parkwood @ Falls Cove BLOCK / SECTION 6 LOT 648 LOT AREA 60660 ft² SITE CLASS. PS DESIGN FLOW 480gpd L.T.A.R. .25 gpd/ft²

Septic Tank: 1500 # Gallons: STB Date

Pump Tank: Gallons: PT Date

Pump Make: Model Serial No.

Nitrification Field: No Fields 1 Square Feet 1920 Linear Feet 480

No. Lines 4@120' Trench Width 36" Max Trench Bottom Depth 36" Gravel Depth NA ☒ Gravity ☐ Pressure

☒ New System ☐ Repair ☐ Expansion System Type: I (II) III IV V VI

System Description: 25% reduction gravity

Repair System Description: 25% reduction gravity

Maintenance Agreement Required: ☐ Yes ☒ No

☒ House/Mod. Home ☐ Mobile Home ☐ Business ☐ Other

No. Bedrooms 4 No. Persons 8 No. Employees

Water Supply: ☐ Individual ☒ Public ☐ Community

☐ Slab ☒ Crawl Space ☐ Basement w/plumbing ☐ Basement wo/plumbing

Comments:/Conditions: # per plan specs
Install at 36" Trench bottom

Comments:/Conditions:

INITIAL SITE SKETCH

See plan from S&ME

AS BUILT SKETCH

Revoked

Permit can be suspended or revoked if any false information is supplied toward securing the permit/any unauthorized changes are made to the site/any unauthorized changes are made in the installation of the system. Improvement Permit with plat valid without expiration ☐ Improvement Permit with site plan valid for sixty months ☒ Authorization to Construct is valid for a period equal to that of Improvement Permit – not to exceed sixty months.

Signed: date 06/26/07

Improvement Permit by: Judy Melville date 6-20-07


Authorization to Construct by: date

Installed by:

Operation Permit by: date

Existing System Inspection by: date

HEALTH DEPT. COPY: WHITE OWNER COPY (FINAL): YELLOW OWNER COPY (INITIAL): PINK

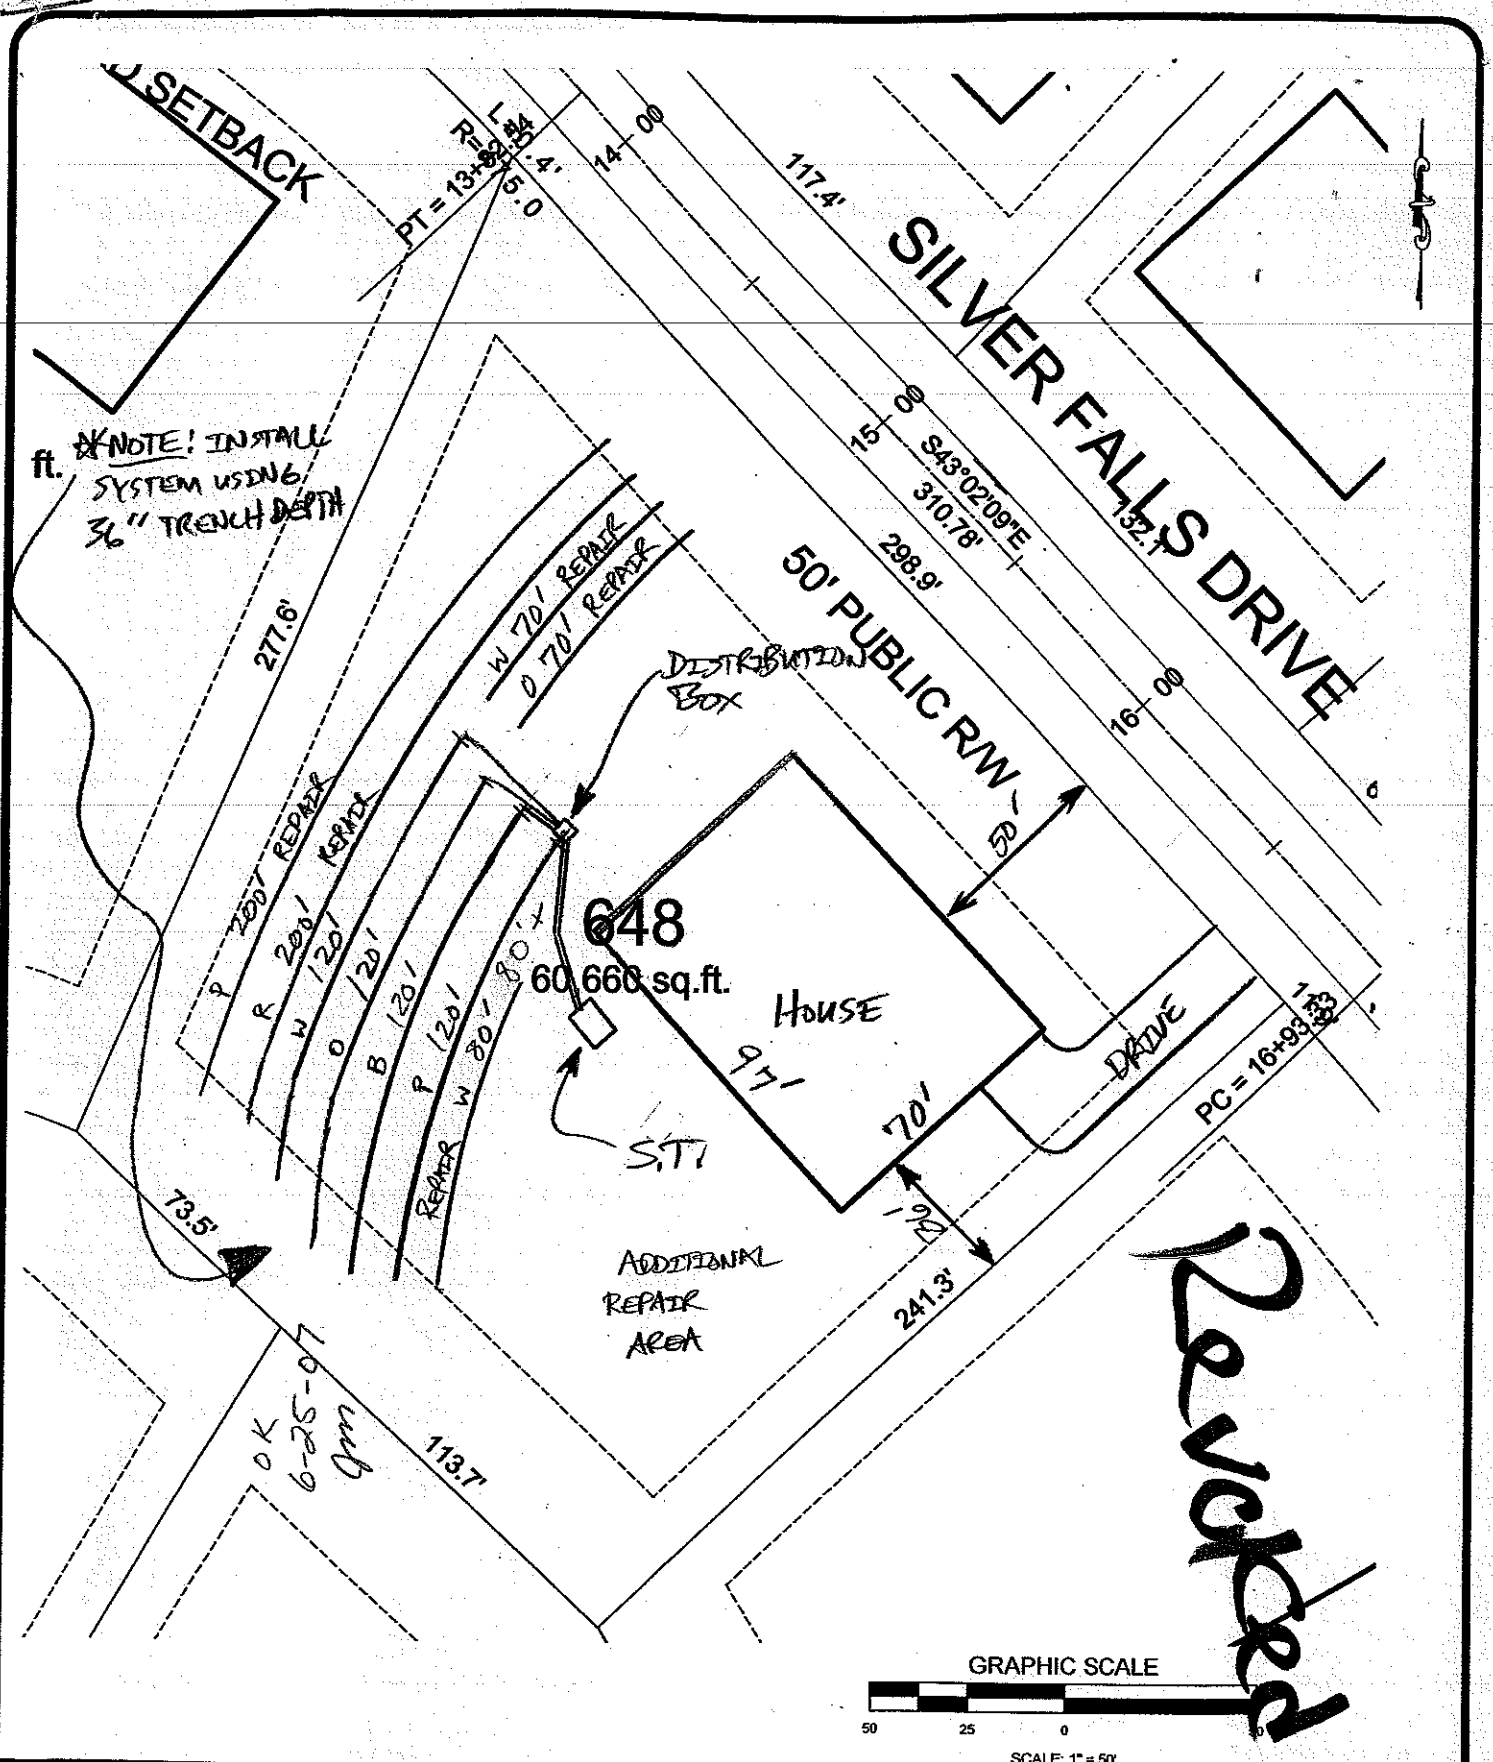

SCALE:	AS SHOWN
DATE:	MAY 2007
DRAWN BY:	RDM
PROJECT NO:	1588-06-091

S&ME
WWW.SMEINC.COM

LOT #648
CRESCENT PARKWOOD - PHASE 6
IREDELL COUNTY, NORTH CAROLINA

FIGURE NO.