CI

* FAX TO RON *

IREDELL COUNTY HEALTH DEPARTMENT

STATESVILLE 704-878-5305 MOORESVILLE 704-664-5281

IMPROVEMENT PERMIT / AUTHORIZATION TO CONSTRUCT / OPERATION PERMIT / EXISTING SYSTEM INSPECTION

PERMIT# 144183 PIN# 4730130805 DATE 9/23/07

OWNER OR APPLICANT RONALD R. BURFORD PHONE: Business 704361-0978 Home FAX= 704-895-4057

ADDRESS P.O. BOX 217 MT. MOURNE NC 28123

LOCATION PERTH RD (R) STATE PARK (F) PARKSTONE 2ND LOT ON RT

SUBDIVISION PARKSTONE BLOCK / SECTION ____ LOT 8 LOT AREA 1.044 SITE CLASS. PS DESIGN FLOW 480 L.T.A.R. .3

Septic Tank: 1000 Gallons: STB 3IL Date 12-24-07

Pump Tank: ____ Gallons: PT ____ Date ____

Pump Make: ____ Model ____ Serial No. ____

Nitrification Field: No Fields 1 Square Feet EQ=1600 Linear Feet 270'

No Lines 6x45 Trench Width 24" Max Trench Bottom Depth 36"

[X] New System [ ] Repair [ ] Expansion System Type: I II (III) IV V VI

System Description: 6NAUIFY SD1, REDUCTION

Repair System Description: LP SD1, REDUCTION

Maintenance Agreement Required: [ ] Yes [X] No

[X] House/Mod. Home [ ] Mobile Home [ ] Business [ ] Other

No. Bedrooms 4 No. Persons 8 No. Employees ____

Water Supply: [X] Individual [ ] Public [ ] Community

Gravel Depth N/A [X] Gravity [ ] Pressure [ ] Slab [X] Crawl Space [ ] Basement w/plumbing [ ] Basement wo/plumbing

Comments/Conditions: (1) Discussed ALL SETBACKS WITH BUILDER (2) Install Lines on Contours & MAINTAIN SETBACKS (3) INSTALL 6 LINES 45' LONG, USING 1 FLOW DIVIDER TEE &

INITIAL SITE SKETCH

SEE ATTACHED SYSTEM DESIGN BY LORNE COOK, P.S.

Comments/Conditions: 2 Distribution Boxes with speed levelers, (4) DUE TO SAPROLITE, 100' WELL SETBACK MUST BE MAINTAINED (5) SYSTEM SIZED FOR A 4 BEDROOM HOME, ONLY PLANNING A 3 BEDROOM HOME

AS BUILT SKETCH ON IT. -

10-8-07, MET BUILDER & MARK CLOSEST TO SEPTIC LINES will have (6) foundation drains, Lines, by measurements done on lot, will still be 15' from drain & sippys will be 10' from drain. If this cannot be maintained Pump System maybe required, Drain, per builder, will have to go through Right wing wall foundation

WELL IS 136' From TANK POLY LOK Filter & RISERS

Permit can be suspended or revoked if any false information is supplied toward securing the permit/any unauthorized changes are made to the site/any unauthorized changes are made in the installation of the system. Improvement Permit with plat valid without expiration [ ] Improvement Permit with site plan valid for sixty months [X] Authorization to Construct is valid for a period equal to that of Improvement Permit – not to exceed sixty months.

Signed: [signature] date 9/23/07 Installed by: Richard ABERNATHY GRADING & Septic TANKS

Improvement Permit by: [signature] date 9/23/07 Operation Permit by: [signature] date 4-16-08

Authorization to Construct by: [signature] date 9/23/07 Existing System Inspection by: ____ date ____


HEALTH DEPT. COPY: WHITE OWNER COPY (FINAL): YELLOW OWNER COPY (INITIAL): PINK


THIS IS TO CERTIFY THAT ON THE 11th DAY OF Sept. 2007, I, MAPPED THE PROPERTY SHOWN ON THIS PLAT. AND THAT THE TITLE LINES AND THE WALLS OF THE BUILDINGS IF ANY ARE SHOWN HEREON.

Bobby J. Raye, Surveyor
627 Eastway Drive
Charlotte, NC 28205

SIGNED Bobby J Raye
REGISTERED SURVEYOR

NORTH CAROLINA PROFESSIONAL SEAL L1108 LAND SURVEYOR BOBBY J. RAYE

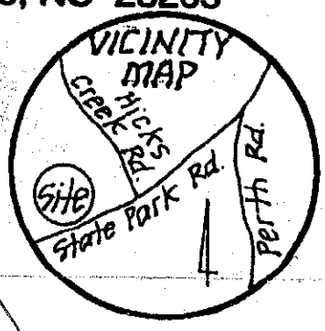

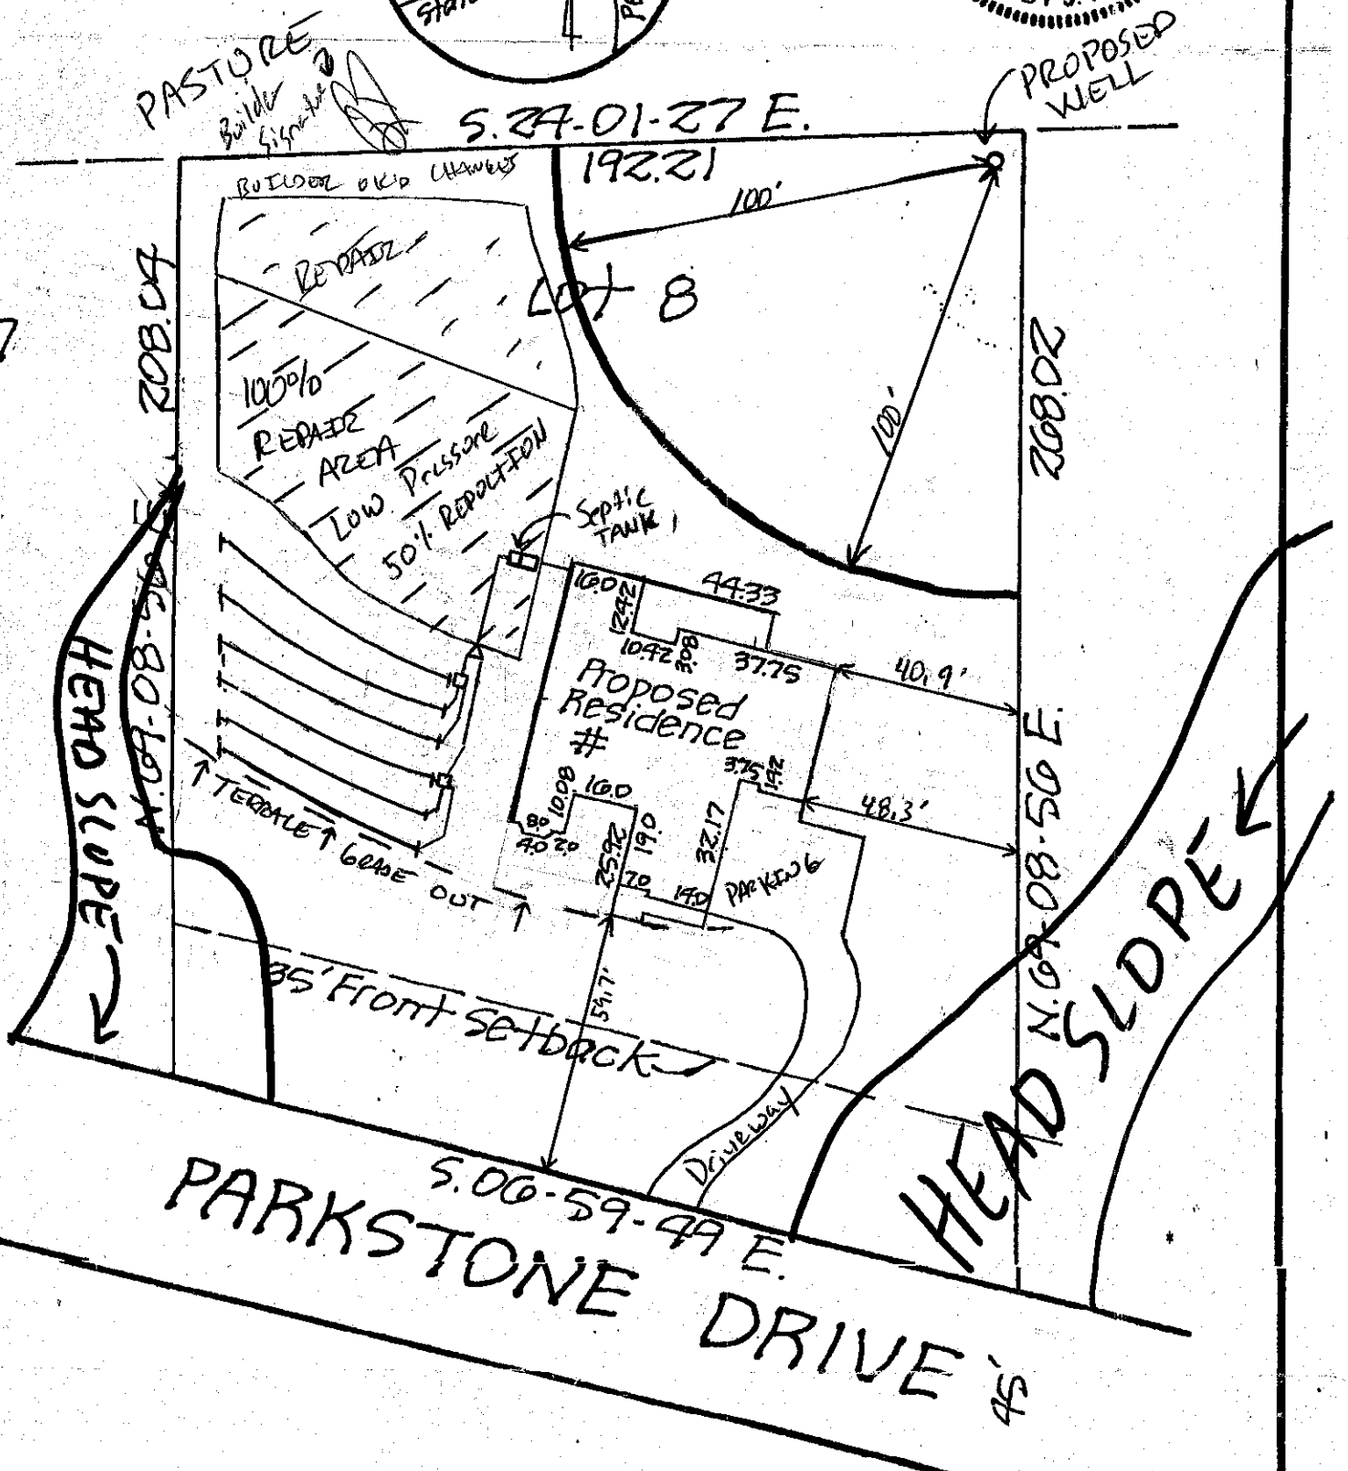

Plot Plan SURVEY OF

Permit # 144183
PIN # 4730130805

Lot 8 Parkstone
Fallstown Township, Iredell Co., N.C.

SCALE 1" = 40'

THE PROPERTY OF Finesse Custom Contracting

MAP RECORDED IN BOOK AT PAGE DEED RECORDED IN BOOK PAGE