2:30 This permit replaces the drawing issued on 7-2-04

IREDELL COUNTY HEALTH DEPARTMENT

STATESVILLE 704-878-5305 CJ MOORESVILLE 704-664-5281

IMPROVEMENT PERMIT / AUTHORIZATION TO CONSTRUCT / OPERATION PERMIT / EXISTING SYSTEM INSPECTION

PERMIT# 12065 PIN# 4730-15-7178 DATE 3-22-06

OWNER OR APPLICANT Mike Wahl PHONE: Business 704 996 4542 Home 704 663 2252

ADDRESS 555 Hicks Creek Rd

LOCATION Perth Rd 5 miles (R) State Park Rd. (R) Hicks Creek Rd, lot is on the L

SUBDIVISION Brenda Hills BLOCK / SECTION LOT 5 LOT AREA .93 Acres SITE CLASS. PS DESIGN FLOW 360 L.T.A.R. .25

Septic Tank: 1000 Gallons; STB 1007 Date 4-17-06
Pump Tank: Gallons; PT Date
Pump Make: Model Serial No.
Nitrification Field: No Fields 1 Square Feet 1440 Linear Feet 360
No Lines 4 Trench Width 36" Max Trench Bottom Depth 36"

☒ New System ☐ Repair ☐ Expansion System Type: I (II) III IV V VI
System Description: 25% Reduction
Repair System Description: 25% Reduction
Maintenance Agreement Required: ☐ Yes ☒ No

☒ House/Mod. Home No. Bedrooms 3
☐ Mobile Home No. Persons
☐ Business No. Employees
☐ Other


Water Supply: ☒ Individual ☐ Public ☐ Community

Gravel Depth n/a ☒ Gravity ☐ Pressure ☐ Slab ☒ Crawl Space ☐ Basement w/plumbing ☐ Basement wo/plumbing

Comments:/Conditions:

(1) Keep system 100' from neighbors well and well for this lot (2) Install lines on contour (3) maintain setbacks

INITIAL SITE SKETCH

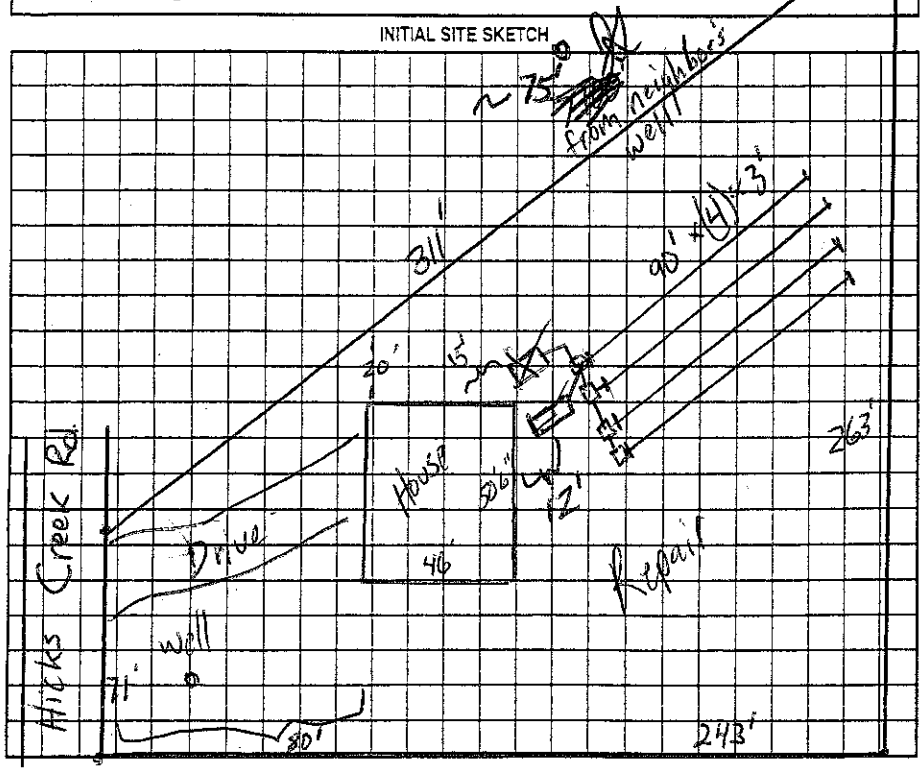

Comments:/Conditions:

Brown filter

AS BUILT SKETCH

Permit can be suspended or revoked if any false information is supplied toward securing the permit/any unauthorized changes are made to the site/any unauthorized changes are made in the installation of the system. Improvement Permit with plat valid without expiration ☐ Improvement Permit with site plan valid for sixty months ☐ Authorization to Construct is valid for a period equal to that of Improvement Permit – not to exceed sixty months.

Signed: Michael Wahl date 3/23/06 Installed by: Brad's Grading

Improvement Permit by: James Allen date 3-22-06 Operation Permit by: James Allen date 9-15-06

Authorization to Construct by: James Allen date 3-22-06 Existing System Inspection by: date

HEALTH DEPT. COPY: WHITE OWNER COPY (FINAL): YELLOW OWNER COPY (INITIAL): PINK