IREDELL COUNTY HEALTH DEPARTMENT

STATESVILLE 704-878-5305 MOORESVILLE 704-664-5281

IMPROVEMENT PERMIT / AUTHORIZATION TO CONSTRUCT / OPERATION PERMIT / EXISTING SYSTEM INSPECTION

PERMIT# 81122 PIN# 4730158067 DATE May 19. 99

OWNER OR CONTRACTOR Tim Poff PHONE: Business 704 528 0826 Home

ADDRESS PO Box 1175 Troutman NC

LOCATION State Park Rd (R) Hicks Creek on 5th on Right

SUBDIVISION Brevle Hills BLOCK / SECTION LOT 4 LOT AREA 1/2 Ac SITE CLASS B3 DESIGN FLOW 360 L.T.A.R. 43

Septic Tank: 1000 Gallons: STB 794 Date 1-10-00

Pump Tank: Gallons; PT Date

Pump Make: Model Serial No.

Nitrification Field: No Fields 1 Square Feet 1200 Linear Feet 300

No Lines 4 @ 80' Trench Width 36" Max Trench Bottom Depth 36" Gravel Depth Sand 6"

☒ New System ☐ Repair System Type: I, II, ⓘ, IV, V, VI

System Description: Graun A 25% Reduction

Repair System Description: Temp - 50% possible

Maintenance Agreement Required: ☐ Yes ☒ No

☒ House/Mod. Home ☐ Mobile Home ☐ Business ☐ Other

No. Bedrooms 3 No. Bathrooms 2 No. Employees


Water Supply: ☒ Individual ● Public ☐ Community WELL

☐ Slab ☒ Crawl Space ☐ Basement w/plumbing ☐ Basement wo/plumbing


Comments/Conditions: 50 Chambers or 30 HDS Sections
1) 13 Chambers per Line
2) Landscape To Provide Surface drainage
3) Well Located 10ft from Septic System

Comments/Conditions:

INITIAL SITE SKETCH

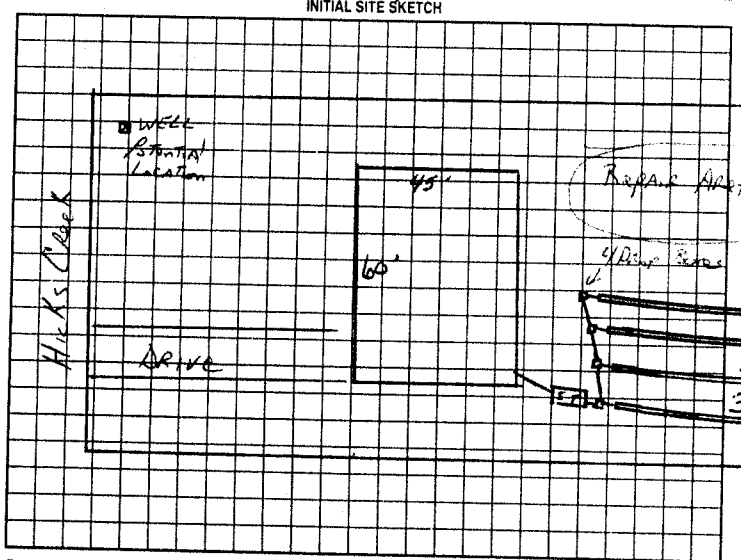

AS BUILT SKETCH

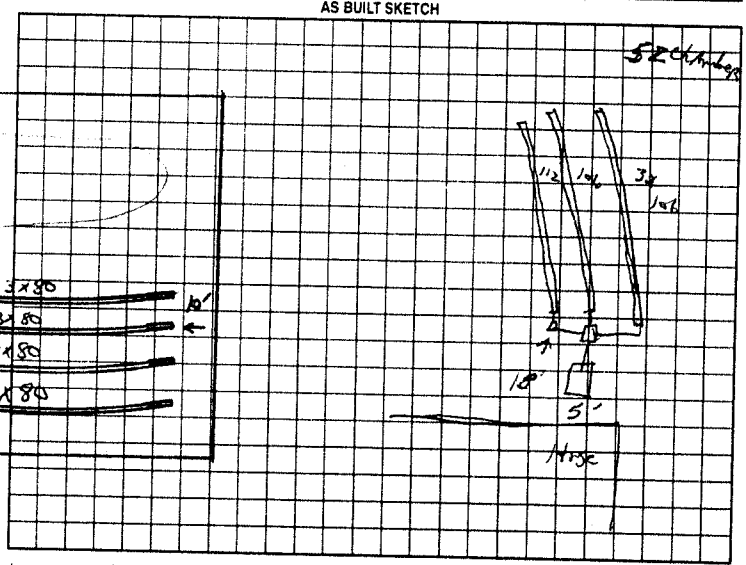

Permit can be suspended or revoked if any false information is supplied toward securing the permit/any unauthorized changes are made to the site/any unauthorized changes are made in the installation of the system. Improvement Permit with plat valid without expiration. Improvement Permit with site plan valid for sixty months. Authorization to Construct is valid for a period equal to that of Improvement Permit – not to exceed sixty months.

Signed: date 5-21-99

Improvement Permit by: C Potter date 5.19.99

Authorization to Construct by: C Potter date 5 19 99

Installed by: Wes Lytton

Operation Permit by: C Potter date 2-29-00

Existing System Inspection by: date

HEALTH DEPT. COPY: WHITE OWNER COPY (FINAL) YELLOW OWNER COPY (INITIAL) PINK