This Voids permit dated 3-17-97

IREDELL COUNTY HEALTH DEPARTMENT

STATESVILLE 704-878-5305 MOORESVILLE 704-664-5281

IMPROVEMENT PERMIT / AUTHORIZATION TO CONSTRUCT / OPERATION PERMIT / EXISTING SYSTEM INSPECTION

PERMIT# 2613306575a PIN# 4437025018 DATE 8-20-98

OWNER OR CONTRACTOR Richard C. Hagar PHONE: Business _____ Home 872-2344

ADDRESS 107 Skyuka Rd Statesville

LOCATION Perth Rd TR State Park Rd TR Hicks Creek TR Brendle Ln 1st on Corner. on (L)

SUBDIVISION Brendle Hills BLOCK / SECTION _____ LOT 3 LOT AREA _____ SITE CLASS. P/S DESIGN FLOW 360 L.T.A.R. 0.3

Septic Tank: 1000 Gallons; STB 791 Date 7-17-98

Pump Tank: _____ Gallons; PT _____ Date _____

Pump Make: _____ Model _____ Serial No. _____

Nitrification Field: No Fields 1 Square Feet _____ Linear Feet 200

No Lines 4 Trench Width 24in Max Trench Bottom Depth 36in Gravel Depth Sand

[X] New System [ ] Repair System Type: I, II, III (IV), V, VI

System Description: Graviti Panels

Repair System Description: Ramp Panels

Maintenance Agreement Required: [ ] Yes [ ] No

[X] House/Mod. Home [ ] Mobile Home [ ] Business [ ] Other

No. Bedrooms 3 No. Bathrooms 2 No. Employees ____

[ ] Slab [ ] Crawl Space [X] Basement w/plumbing [X] Basement wo/plumbing


Water Supply: [X] Individual [ ] Public [ ] Community

Comments:/Conditions:


Install 4 lines @ 50Ft of Panels using Dist Box w/speed levelers keep 10Ft from Property line

Comments:/Conditions:

INITIAL SITE SKETCH

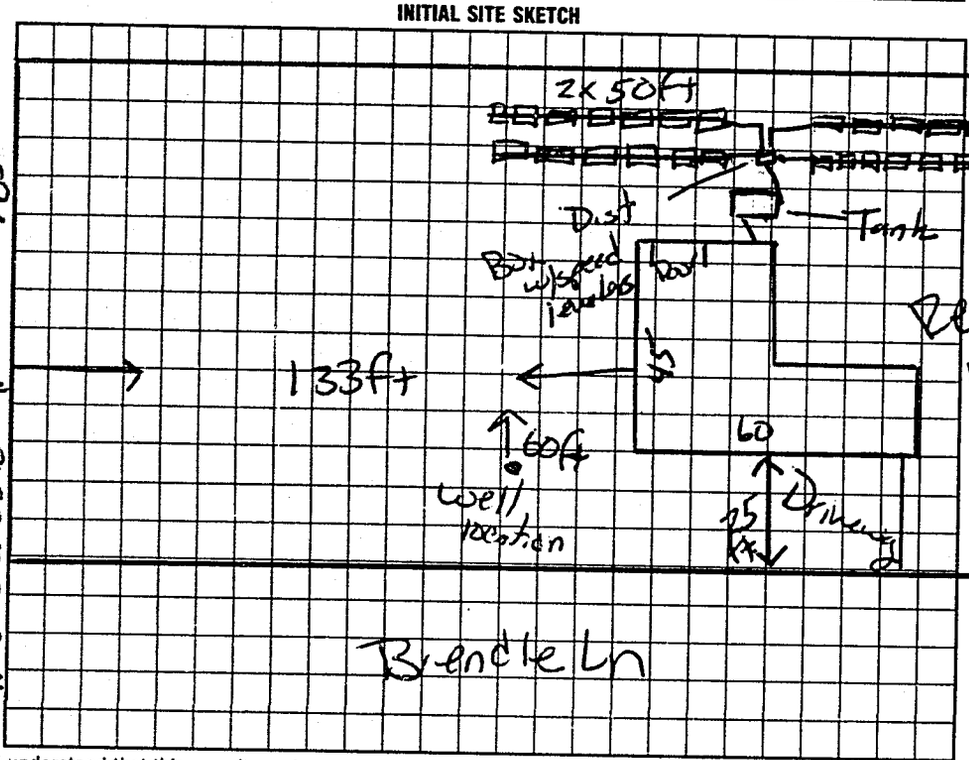

AS BUILT SKETCH

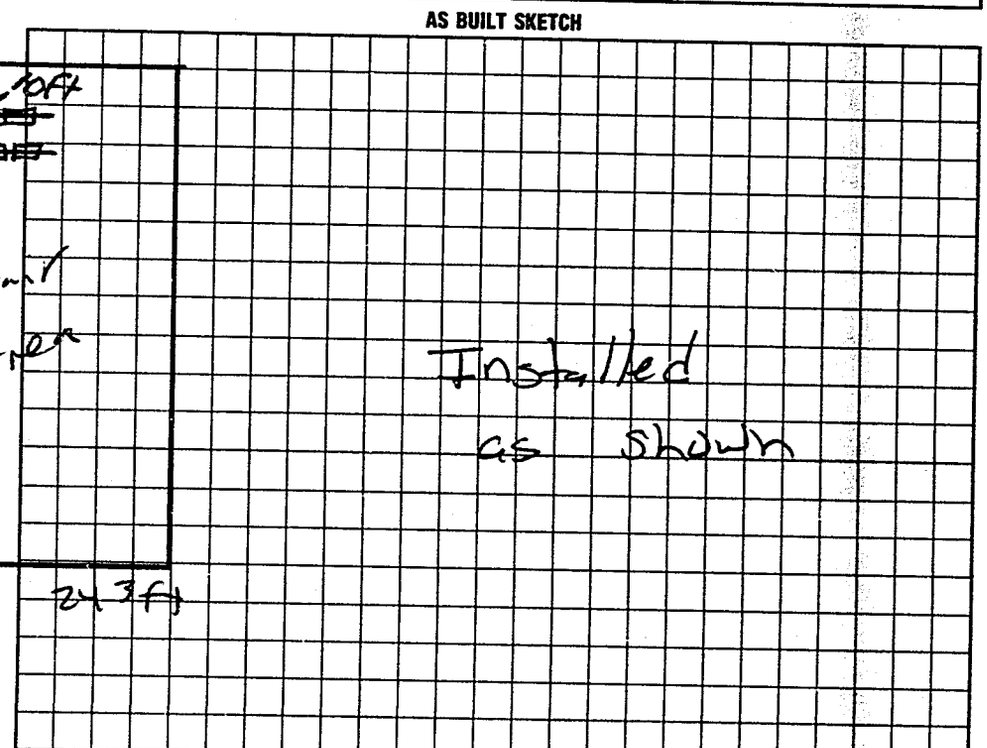

I understand that this permit can be suspended or revoked if any false information is supplied toward securing the permit/any unauthorized changes are made to the site/any unauthorized changes are made in the installation of the system. Improvement Permit with plat valid without expiration. Improvement Permit with site plan valid for sixty months. Authorization to Construct is valid for a period equal to that of Improvement Permit – not to exceed sixty months.

Signed: Richard C. Hagar date 8/31/98

Improvement Permit by: Mark Coutts date 8-21-98

Authorization to Construct by: Mark Coutts date 8-21-98

Installed by: James Hudlar

Operation Permit by: Mark Coutts date 9-3-98

Existing System Inspection by: _____ date _____

HEALTH DEPT. COPY WHITE INSPECTION COPY (FINAL) GREEN OWNER COPY (FINAL) YELLOW INSPECTION COPY (INITIAL) PINK OWNER COPY (INITIAL) GOLD