IREDELL COUNTY HEALTH DEPARTMENT

STATESVILLE 704-878-5305 CJ MOORESVILLE 704-664-5281

IMPROVEMENT PERMIT / AUTHORIZATION TO CONSTRUCT / OPERATION PERMIT / EXISTING SYSTEM INSPECTION

PERMIT# [redacted] 13/082 PIN# [redacted] 4730-15-9246 DATE 5-24-01

OWNER OR CONTRACTOR [redacted] CLAYTON MARKHAM PHONE: Business 704-791-5310 Home 704-786-9827

ADDRESS [redacted] 1205 BETHEL CHURCH RD Mt. PLEASANT NC 28124

LOCATION STATE PARK RD, (L) Hicks Creek, (R) BRENDLE AT END

SUBDIVISION BRENDLE HILLS BLOCK / SECTION ____ LOT X6 LOT AREA .51 SITE CLASS. PS DESIGN FLOW 360 L.T.A.R. .3

Septic Tank: 1000 Gallons; STB 825 Date 10-1-05
Pump Tank: ____ Gallons; PT ____ Date ____
Pump Make: ____ Model ____ Serial No. ____
Nitrification Field: No Fields 1 Square Feet 1200' Linear Feet 400'
No Lines 4 Trench Width 36" Max Trench Bottom Depth 36" Gravel Depth 12"

☒ New System ☐ Repair System Type: I, II, III, IV, V, VI
System Description: CONV GRAV
Repair System Description: GRAV / Pump PANEL
Maintenance Agreement Required: ☐ Yes ☒ No


☒ House/Mod. Home No. Bedrooms 3
☐ Mobile Home No. Bathrooms 2
☐ Business No. Employees ____
☐ Other ____
☐ Slab ☒ Crawl Space ☐ Basement w/plumbing ☐ Basement wo/plumbing


Water Supply: ☒ Individual ☐ Public ☐ Community
WELL

Comments:/Conditions: ① MAINTAIN SETBACKS FROM WELLS & NEIGHBORS SEPTIC SYSTEM ② INSTALL LINES ON CONTOURS ③ KEEP SYSTEM 5' off house & 10' off property lines. ④ STUB OUT AT BACK RIGHT CORNER OF HOUSE

Comments:/Conditions: ⑤ CALL FOR FLAGOUT PRIOR TO INSTALLATION
* Approved 56'x46' HOUSE PLAN MAINTAINING 15' OFF BOTH SIDE P/L & BACK OF HOME STILL 90' OFF FRONT P/L AS BUILT SKETCH XTRA WIDTH OF HOUSE WILL BE SLID TOWARD FRONT OF ROAD MAKING FRONT OF HOUSE NOW 44' OFF FRONT P/L. WELL LOCATION HAS ALSO CHANGED,

INITIAL SITE SKETCH "NOT TO SCALE"

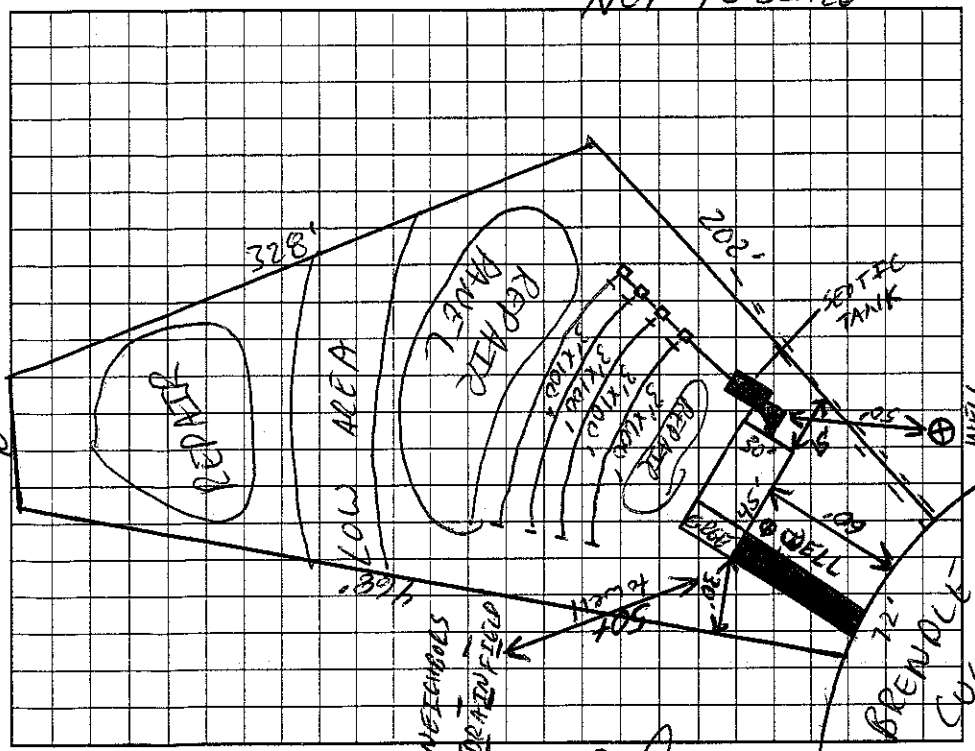

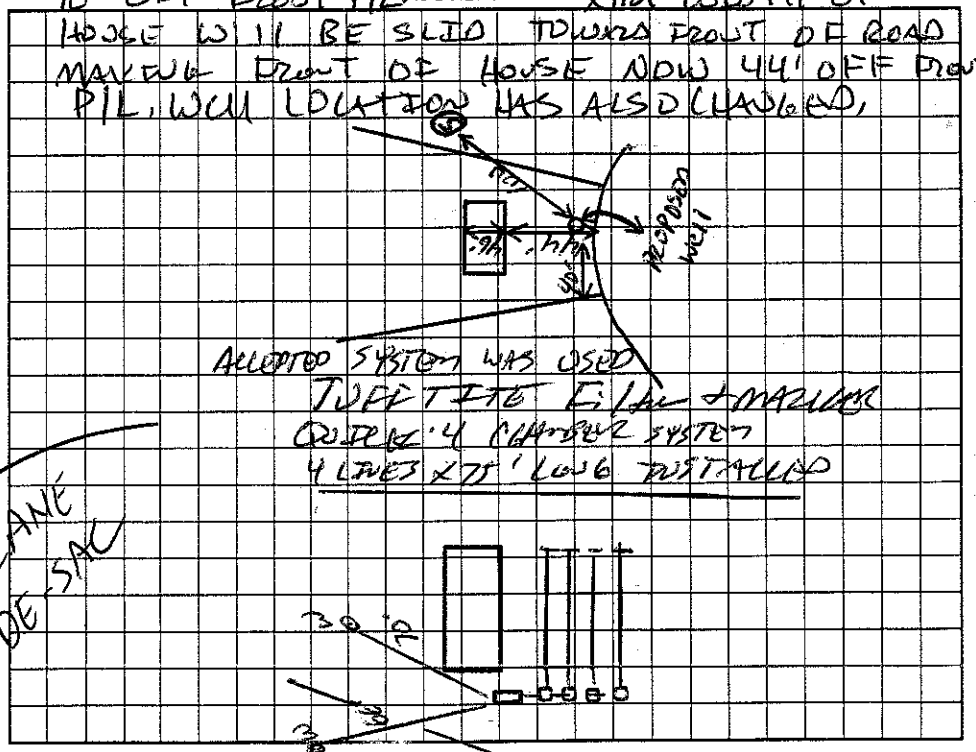

Permit can be suspended or revoked if any false information is supplied toward securing the permit/any unauthorized changes are made to the site/any unauthorized changes are made in the installation of the system. Improvement Permit with plat valid without expiration. Improvement Permit with site plan valid for sixty months. Authorization to Construct is valid for a period equal to that of Improvement Permit – not to exceed sixty months.

Signed: [signature] date 9/12/05 Installed by: ROWAN SEPTIC

Improvement Permit by: [signature] RS date 5-24-01 Operation Permit by: [signature] 05 date 12-28-05

Authorization to Construct by: [signature] RS date 9-12-05 Existing System Inspection by: ____ date ____

HEALTH DEPT. COPY: WHITE OWNER COPY (FINAL): YELLOW OWNER COPY (INITIAL): PINK