IREDELL COUNTY HEALTH DEPARTMENT

THIS PERMIT VOIDS PREVIOUS ISSUED 12-20-02

STATESVILLE 704-878-5305 (C1) MOORESVILLE 704-664-5281

IMPROVEMENT PERMIT / AUTHORIZATION TO CONSTRUCT / OPERATION PERMIT / EXISTING SYSTEM INSPECTION

PERMIT# 110272 PIN# 4730-16-9606 4730-17-2078 DATE 9-27-03

OWNER OR CONTRACTOR SALLY McLESTER PHONE: Business 704-664-4400 Home 704-528-1013

ADDRESS 292 STATE PARK ROAD, TROUTMAN, NC 28166

LOCATION US 21 S, TR PERTH ROAD, TR STATE PARK ROAD, 0.8 MILE ON RIGHT AT #292 BACK OFF ROAD 0.5MI

SUBDIVISION _____ BLOCK / SECTION _____ LOT _____ LOT AREA 10+ACRES SITE CLASS. PS DESIGN FLOW 480 L.T.A.R. 0.30 GPD/FT²

Septic Tank: 1000 Gallons; STB 312 Date 8-25-03

Pump Tank: _____ Gallons; PT _____ Date _____

Pump Make: _____ Model _____ Serial No. _____

Nitrification Field: No Fields 1 Square Feet EQ. FT 1600 Linear Feet 400

No Lines FOUR Trench Width 36" Max Trench Bottom Depth 36" Gravel Depth N/A

☑ New System ☐ Repair System Type: I, II, (III), IV, V, VI

System Description: 25% REDUCTION, GRAVITY

Repair System Description: CONVENTIONAL, GRAVITY

Maintenance Agreement Required: ☐ Yes ☑ No

☑ House/Mod. Home ☐ Mobile Home ☐ Business ☐ Other

No. Bedrooms 4 No. Bathrooms 3 No. Employees _____


☐ Slab ☐ Crawl Space ☐ Basement w/plumbing ☐ Basement wo/plumbing

Water Supply: ☑ Individual ☐ Public ☐ Community WELL


Comments:/Conditions: INSTALL 25% REDUCTION SYSTEM (AT REQUEST) ON CONTOUR IN FOUR EQUAL LENGTH LINES AS SHOWN

Comments:/Conditions: SEPTIC TANK WITH RISERS INSTALLED USING "POLYLOK" FILTER

INITIAL SITE SKETCH

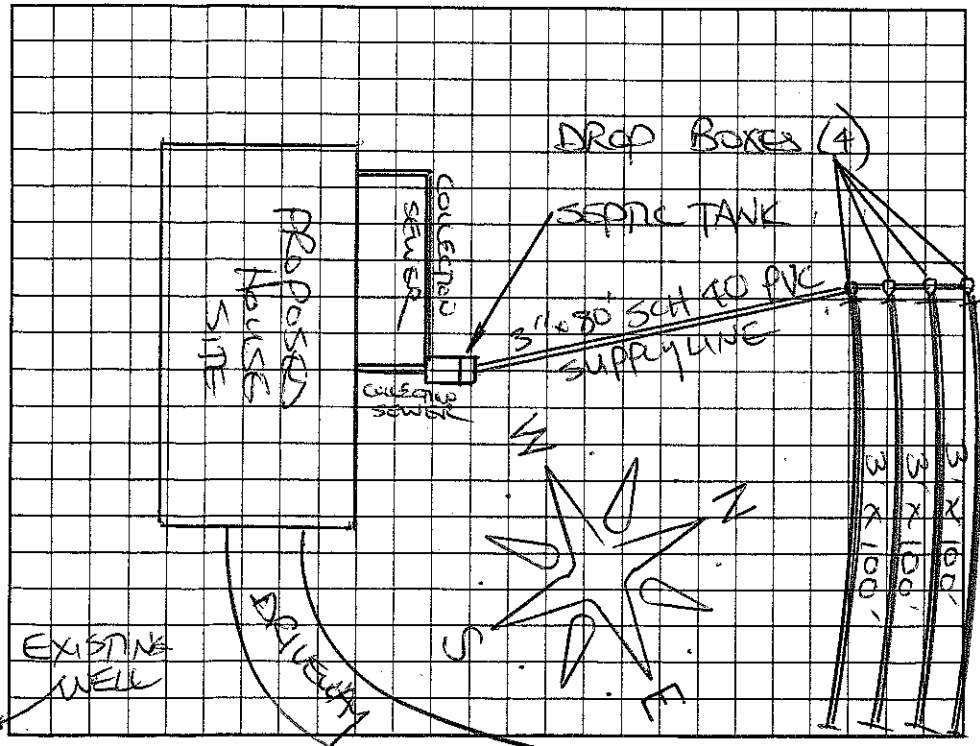

AS BUILT SKETCH

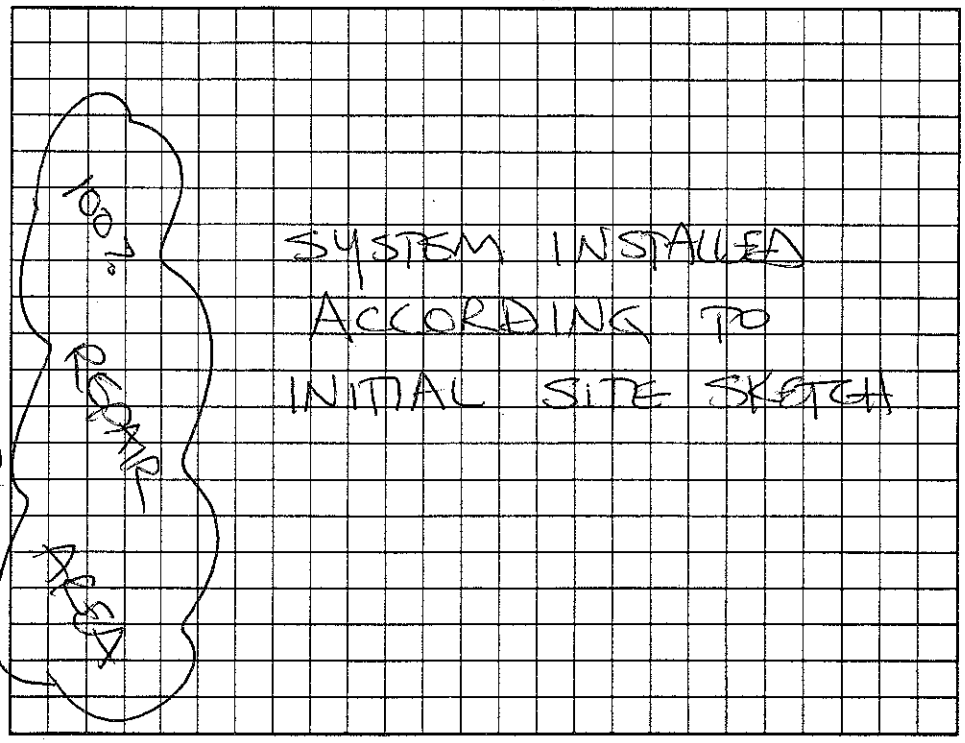

Permit can be suspended or revoked if any false information is supplied toward securing the permit/any unauthorized changes are made to the site/any unauthorized changes are made in the installation of the system. Improvement Permit with plat valid without expiration. Improvement Permit with site plan valid for sixty months. Authorization to Construct is valid for a period equal to that of Improvement Permit – not to exceed sixty months.

Signed: STEVE HENDRICK date 9-27-03 Installed by: R & H of LAKE NORMAN

Improvement Permit by: STEVE HENDRICK date 9-27-03 Operation Permit by: STEVE HENDRICK date 9-27-03

Authorization to Construct by: STEVE HENDRICK date 9-27-03 Existing System Inspection by: _____ date _____

HEALTH DEPT. COPY: WHITE OWNER COPY (FINAL): YELLOW OWNER COPY (INITIAL): PINK