IREDELL COUNTY HEALTH DEPARTMENT

STATESVILLE 704-878-5305 MOORESVILLE 704-664-5281

IMPROVEMENT PERMIT / AUTHORIZATION TO CONSTRUCT / OPERATION PERMIT / EXISTING SYSTEM INSPECTION

PERMIT # 162857 PIN # 4730-20-7333 DATE 8-19-10

OWNER or APPLICANT Superior Pools PHONE: Business 704-615-8546 Home:

OWNER or APPLICANT ADDRESS 20315 Knox Road, Cornelius

LOCATION / DIRECTIONS State Park Rd. (L) Morrison Farm (L) Silver Falls (L) Timber Lake

SUBDIVISION Parkwood - @ Falls Cap BLOCK / SECTION 6 LOT # 619 LOT AREA DESIGN FLOW 600 L.T.A.R. .3


Septic Tank	1500	Gallons: STB	238	Date	11-05-08	☐ New System ☐ Repair ☐ Expansion System Type I II III IV V VI	☒ Residence	No. Bedrooms	5	Water Supply
Pump Tank	1500	Gallons: P T	477	Date	6-12-08	System Description: LP 50% Reduction	☐ Business	No. Persons		☐ Private
Pump Make	Goulds	Model		Serial #		Repair System Description: Same	☐ Other	No. Employees		☒ Public
Nitrification Field	No Fields	No Lines 1	Linear Feet 335			Maintenance Agreement Required ☒ YES ☐ NO	☐ Slab	☐ Crawl Space		☐ Community
Trench Width	5	Max. Trench Bottom Depth	36"	Gravel Depth	n/a	☐ GRAVITY ☒ PRESSURE	☒ Basement w/plumbing	☐ Basement w/o plumbing		

Comments / Conditions


Comments / Conditions

18 x 35' Swimming Pool okayed

INITIAL SITE SKETCH

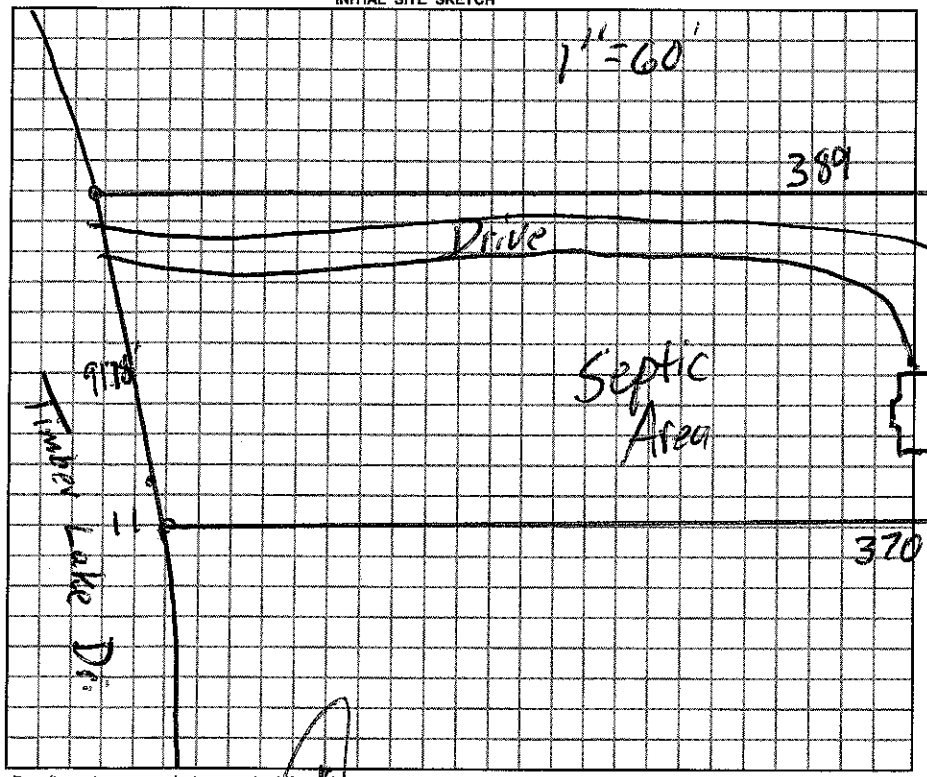

AS BUILT SKETCH

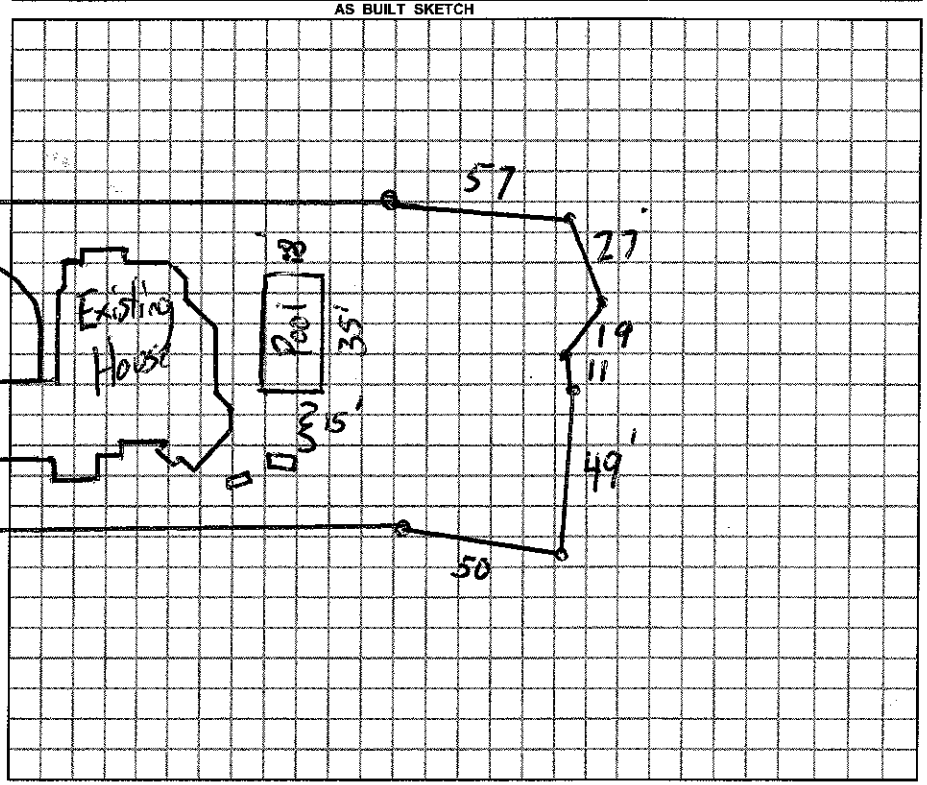

Permit can be suspended or revoked if any false information is supplied toward securing the permit / any unauthorized changes are made to the site / any unauthorized changes are made in the installation of the system.

☐ *IMPROVEMENT PERMIT w / plat valid without expiration.* ☐ *IMPROVEMENT PERMIT w / site plan valid for 60 mos.* ☐ *AUTHORIZATION TO CONSTRUCT valid for period equal to IMPROVEMENT PERMIT-not to exceed 60 mo.*

Owner / Applicant Signature: Date 8/20/10

Improvement Permit by: Date

Authorization to Construct by: Date

YOU SHOULD CONTACT A LOCATOR SERVICE PRIOR TO ANY EXCAVATION.

Installed by:

Operation Permit by: Date:

Existing System Inspected by: Date: 8-19-10

WHITE COPY Environmental Health YELLOW COPY (Final) Owner / Applicant PINK COPY (Initial) Owner / Applicant