44528

# IREDELL COUNTY HEALTH DEPARTMENT

STATESVILLE 704-878-5305 MOORESVILLE 704-664-5281

## IMPROVEMENT PERMIT / CERTIFICATE OF COMPLETION / OPERATION PERMIT / EXISTING SYSTEM INSPECTION

PROPERTY DESCRIPTION NO. 15039 DATE 6-4-93 TAX MAP NO. Pt. of 3E-E-8A

OWNER OR CONTRACTOR Thomas A. Comer PHONE: Business _____ Home _____

ADDRESS 1

LOCATION From Troutman take Perth Rd. TR State Park Rd. TL Lockhart Rd. TR 1st Gravel Rd. Lot at end

SUBDIVISION Spring Oaks Dev. BLOCK / SECTION _____ LOT 1 LOT AREA 4.886 acres SITE CLASS. PS L.T.A.R. .3 gpd/ft²

Water Supply: ☑ Individual ☐ Community ☐ Public Well

Septic Tank: 1000 Gallons; STB 794 Date 3-13-93

Pump Tank: 1000 Gallons; PT PT-27 Date 3-12-93

Nitrification Field: No Fields 1 Square Feet 1200 Linear Feet 400'

No Lines 7 Trench Width 36" Trench Depth 24"-36" Gravel Depth 12"

☐ New System ☐ Repair System Type: I. II. III. IV. V. VI

System Description: Pump to conventional

Repair System Description: "

Maintenance Agreement Required: ☐ Yes ☑ No

☑ House/Mod. Home No. Bedrooms 3

☐ Mobile Home No. Bathrooms 3

☐ Business No. Employees ~

☐ Other _____

☑ Slab ☐ Crawl Space ☐ Basement w/plumbing ☐ Basement wo/plumbing

Garbage Disposal: ☐ Yes ☑ No


Auto. Dishwasher: ☑ Yes ☐ No

Auto. Washing Machine: ☑ Yes ☐ No


Other _____

Comments Keep check on manifold box for 2' of Pressure head periodically

INITIAL SITE SKETCH

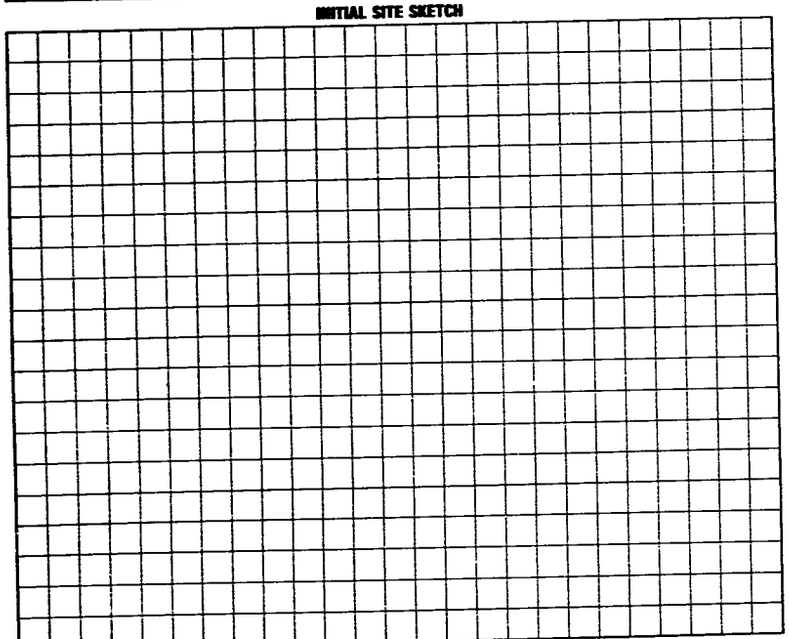

AS BUILT SKETCH

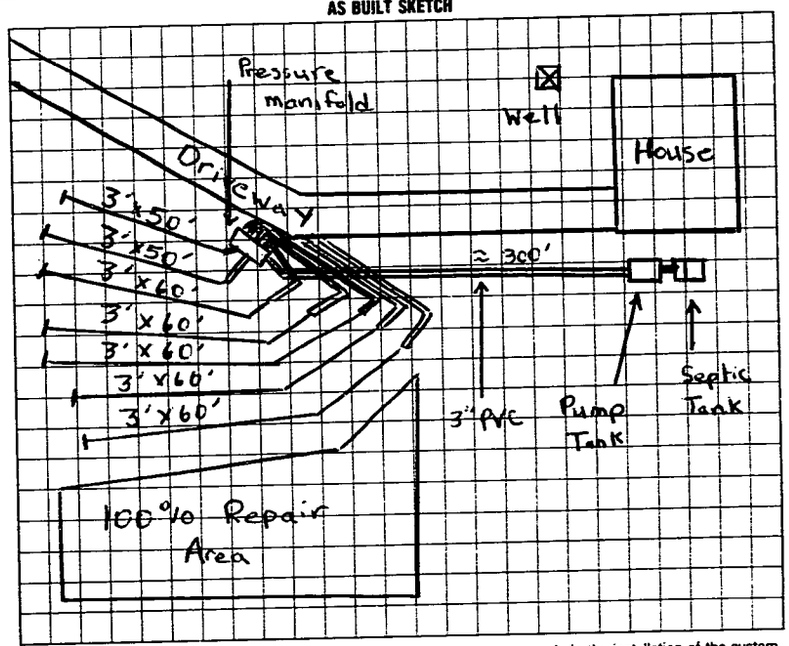


I understand that this permit can be suspended or revoked if any false information is supplied toward securing the permit/any unauthorized changes are made to the site/any unauthorized changes are made in the installation of the system. Improvement Permit is valid for 60 months from date of issuance.

Signed: _____

Improvement Permit by: Steve Brown date 8-12-92

Existing System Inspection by: _____ date _____

Installed by: Denver Plumbing

Certificate of Completion by: Michael D. Dennis date 6-4-93

Operation Permit by: _____ date _____

HEALTH DEPT. COPY: WHITE INSPECTION COPY (FINAL): GREEN OWNER COPY (FINAL): YELLOW INSPECTION COPY (INITIAL): PINK OWNER COPY (INITIAL): GOLD