48197

IREDELL COUNTY HEALTH DEPARTMENT

STATESVILLE 704-878-5305 MOORESVILLE 704-664-5281

IMPROVEMENT PERMIT / CERTIFICATE OF COMPLETION / OPERATION PERMIT / EXISTING SYSTEM INSPECTION

PROPERTY DESCRIPTION NO. 16468 DATE 6-9-93 TAX MAP NO. 3E-E-13

OWNER OR CONTRACTOR Jim Leonard PHONE: Business Home 663-4207

ADDRESS

LOCATION State Park Rd. TL Lockhard Rd. TR 1st dirt rd. to R. 2nd to last house on L.

SUBDIVISION Spring Oaks BLOCK / SECTION LOT 3 LOT AREA 2.025 acres SITE CLASS. P.S. L.T.A.R. .3 gpd/ft²

Water Supply: ☑ Individual ☐ Community ☐ Public Well To Be Located

Septic Tank: 1000 Gallons; STB 358 Date 2-14-94

Pump Tank: 1000 Gallons; PT 1103 Date 9-21-93

Nitrification Field: No Fields 1 Square Feet 900 Linear Feet 300'

No Lines 3 Trench Width 36" Trench Depth 30" Gravel Depth 12"

☑ New System ☐ Repair System Type: I, II, III, IV, V, VI

System Description: Pump to conventional

Repair System Description: " "

Maintenance Agreement Required: ☐ Yes ☑ No

☑ House/Mod. Home No. Bedrooms 2

☐ Mobile Home No. Bathrooms 2.5

☐ Business No. Employees —

☐ Other

Garbage Disposal: ☐ Yes ☑ No

Auto. Dishwasher: ☑ Yes ☐ No


Auto. Washing Machine: ☑ Yes ☐ No

Other

☐ Slab ☑ Crawl Space ☐ Basement w/plumbing ☐ Basement wo/plumbing

Comments INSTALL SYSTEM SHALLOW (no deeper than 30" to trench bottom) Keep Nitrification Lines on contour, Keep system 5' from foundation of home, 10' from all property lines, and 50' min. from any well. Keep system 20' from any other septic system. Install pump that will deliver 40 gpm at 63.917 TDH (see Attached) Pump to manifold. (see Attached) Copies of as built sketch needed at Final.

INITIAL SITE SKETCH

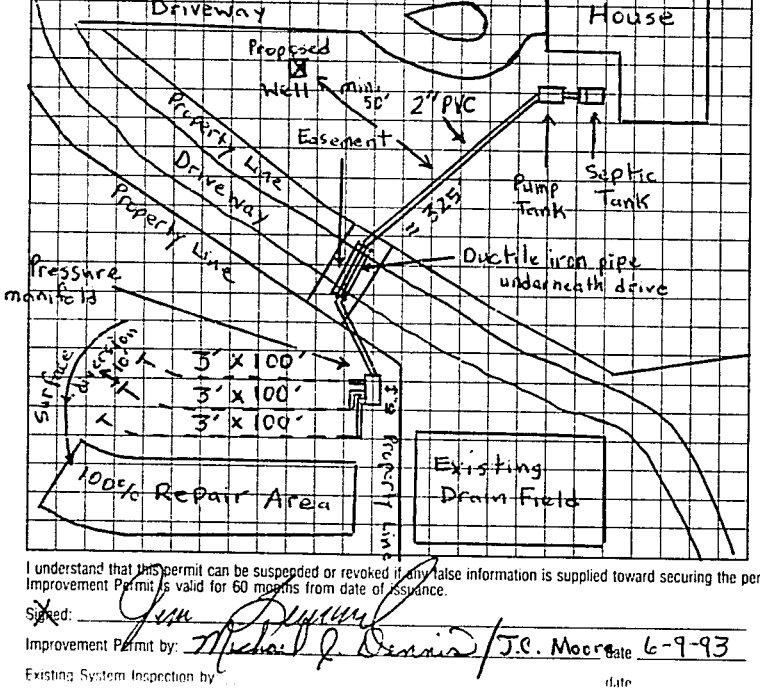

LAKE

Install ductile iron underneath driveway

* Checked drainlines, pump tank, septic tank. 3-15-94 *

SAME AS INITIAL SKETCH

Checked Pump, manifold and Alarm box. --Could not check float position, tank full of water.

I understand that this permit can be suspended or revoked if any false information is supplied toward securing the permit/any unauthorized changes are made to the site/any unauthorized changes are made in the installation of the system. Improvement Permit is valid for 60 months from date of issuance.

Signed: Jim Leonard

Improvement Permit by: Michael J. Dennis / J.C. Moore date 6-9-93

Existing System Inspection by date

Installed by: Kenny Pearson

Certificate of Completion by: Michael J. Dennis date 3-31-94

Operation Permit by date

HEALTH DEPT COPY WHITE INSPECTION COPY (FINAL) GREEN OWNER COPY (FINAL) YELLOW INSPECTION COPY (INITIAL) PINK OWNER COPY (INITIAL) GOLD

S 6 6 0 0 0