IREDELL COUNTY HEALTH DEPARTMENT

Statesville Office (704) 878-5305 Mooresville Office (704) 660-3625 PERMIT # 211424

IMPROVEMENT PERMIT / AUTHORIZATION TO CONSTRUCT / OPERATION PERMIT / EXISTING SYSTEM

PIN # 4730220242

APPLICANT: ELG Investments APPLICANT ADDRESS: 16108 Northpoint Rd Huntersville NC

SITE ADDRESS: 139 Silver Falls Dr. Troutman NC PHONE: — ALT. PHONE: —

SITE DIRECTIONS: Perth To State Park, TL Morrison Farm, TL Silver Falls, Site on L

SUBDIVISION: Falls Cove (Parkwood @ Falls) SECTION: 6 LOT # 605 LOT AREA: 59,790 Sq. Ft. DESIGN FLOW: 480 GPD L.T.A.R.: .25

Septic Tank 1500 * (gal) STB 825 Date 10-2-15
Pump Tank N/A (gal) PT N/A Date N/A
Pump Make N/A Model N/A Serial # N/A
Nitrification Fields 1 # Lines 4 @ 120' Linear Ft: 480'
Trench Width 36" Max. Trench Bottom Depth 24" - 36" Gravel Depth N/A

☑ New System ☐ Repair ☐ Expansion System Type: I II ☑ III IV V VI
System Description: 25% Reduction - Gravity
Repair System Description: PPBTS
Maintenance Agreement Required: ☐ YES ☒ NO
☑ GRAVITY ☐ PRESSURE

☑ Residence No. Bedrooms 4
☐ Business No. Persons 8
☐ Other No. Employees
☐ Slab ☒ Crawl Space
☐ Basement w/plumbing ☐ Basement w/o plumbing

Water Supply: ☐ Private ☒ Public ☐ Community

Comments / Conditions: * Per Design Specs.

INITIAL SITE SKETCH

See Attached Approved Design By Michael Stevens & Associates Dated 6/29/15

AS BUILT SKETCH

Installed Well Pump as drawn

Permit can be suspended or revoked if any false information is supplied toward securing the permit / any unauthorized changes are made to the site / any unauthorized changes are made in the installation of the system. **CONTACT A LOCATOR SERVICE PRIOR TO ANY EXCAVATION**


☐ **IMPROVEMENT PERMIT** *with plat valid without expiration.* ☑ **IMPROVEMENT PERMIT** *with site plan valid for 60 mos.* ☒ **AUTHORIZATION TO CONSTRUCT** *valid for period equal to IMPROVEMENT PERMIT--not to exceed 60 mo.*

Owner / Applicant Signature: Date: 7/1/15 Installed by: Rowan Septic

IMPROVEMENT PERMIT by: Date: 6/29/15 OPERATION PERMIT by: Date: 11/18/15

AUTHORIZATION TO CONSTRUCT by: Date: 6/29/15 Existing System Inspected by: Date:

Health Dept. Copy - WHITE Applicant (Final Approval) - YELLOW Applicant (Conditional Approval) - PINK

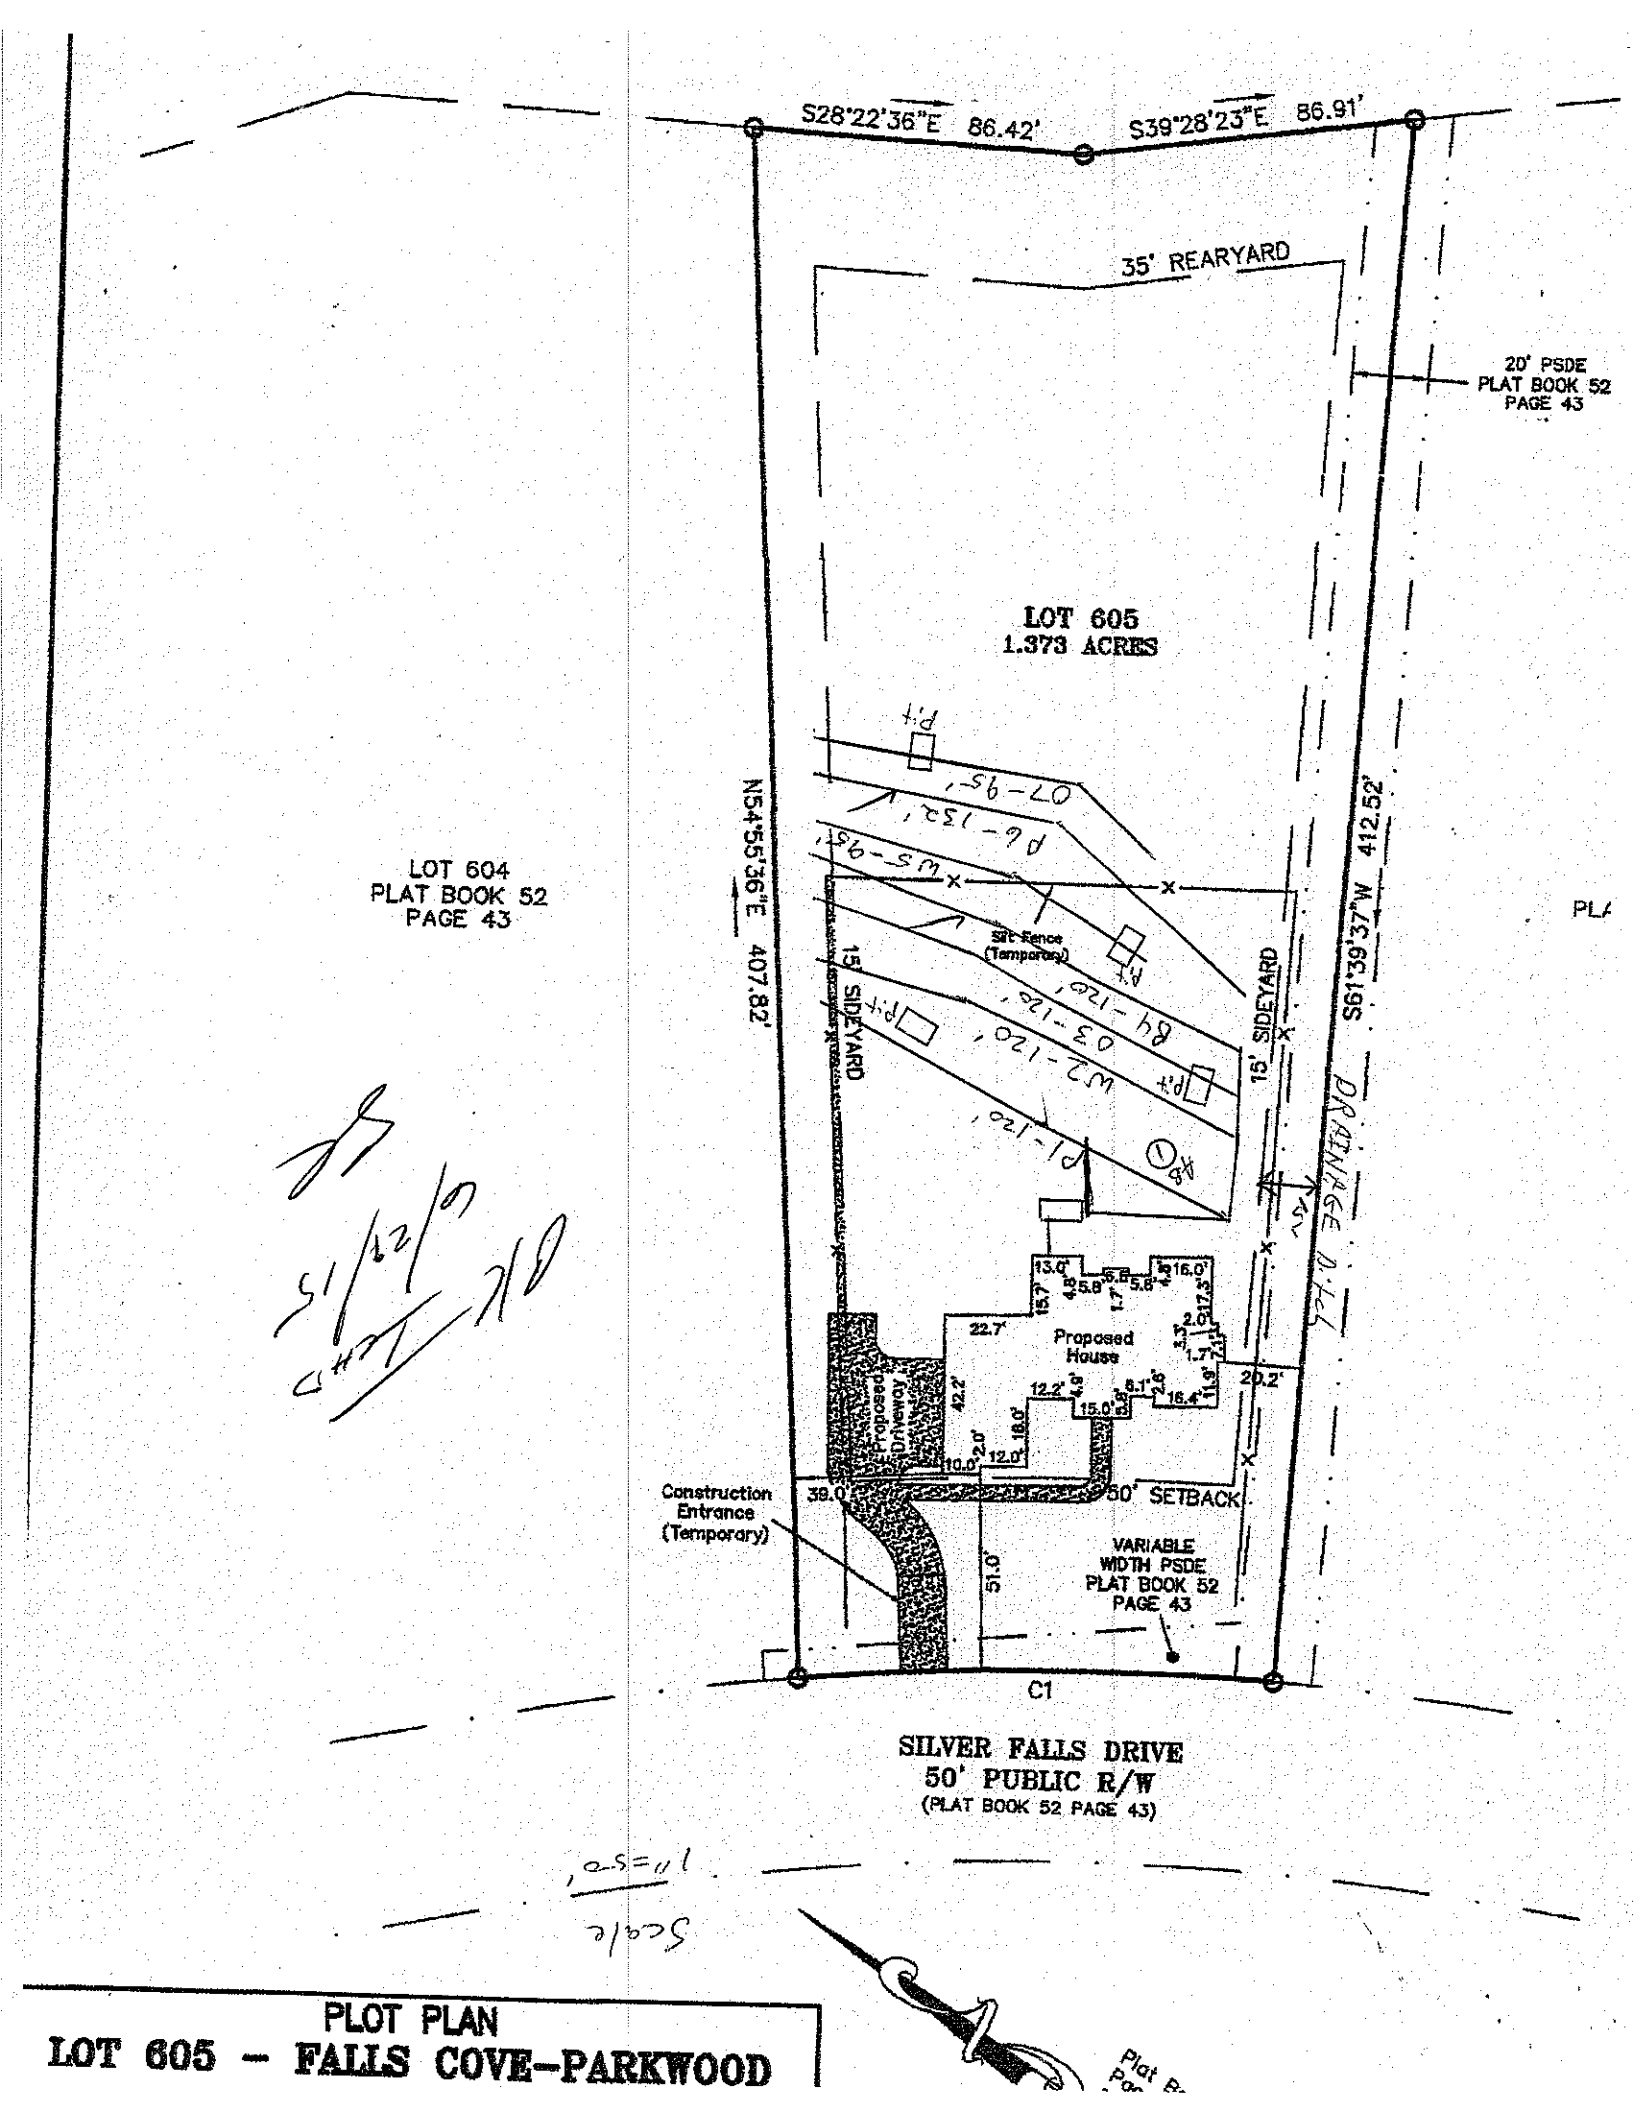

PLOT PLAN
LOT 605 - FALLS COVE-PARKWOOD