reenters 219629

IREDELL COUNTY HEALTH DEPARTMENT

Statesville Office (704) 878-5305 Mooresville Office (704) 660-3625 PERMIT # 219160

IMPROVEMENT PERMIT / AUTHORIZATION TO CONSTRUCT / OPERATION PERMIT / ~~EXISTING SYSTEM~~

PIN # 4730-22-0242 ✓

APPLICANT: ELG INVESTMENTS APPLICANT ADDRESS: 16108 NORTH POINT RD. HUNTERSVILLE

SITE ADDRESS: 139 SILVER FALL DR. TROUTMAN PHONE: 704-578-4951 ALT. PHONE:

SITE DIRECTIONS: PERTH, TL STATE PARK, TL MORRISON FARM, TL SILVER FALLS, ON L

SUBDIVISION: FALLS COVE SECTION: 6 LOT # 605 LOT AREA: 1.373 AC DESIGN FLOW: 480 L.T.A.R.: .25

Septic Tank Ex 1500 (gal) STB Date
Pump Tank (gal) PT Date
Pump Make Model Serial #
Nitrification Fields Ex 1 STNG # Lines Linear Ft:
Trench Width Max. Trench Bottom Depth Gravel Depth —

☐ New System ☐ Repair ☐ Expansion System Type: I II (III) IV V VI
System Description: 25% REDUCTION
Repair System Description: PANEL BLOCK
Maintenance Agreement Required: ☐ YES ☒ NO
☒ GRAVITY ☐ PRESSURE

☐ Residence No. Bedrooms 4
☐ Business No. Persons 8
☒ Other No. Employees
☐ Slab ☒ Crawl Space
☐ Basement w/plumbing ☐ Basement w/o plumbing

Water Supply
☐ Private
☒ Public
☐ Community

Comments / Conditions:

DECK

INITIAL SITE SKETCH

SEE PLAN FROM THE OAKS GROUP

AS BUILT SKETCH

Permit can be suspended or revoked if any false information is supplied toward securing the permit, / any unauthorized changes are made to the site / any unauthorized changes are made in the installation of the system. **CONTACT A LOCATOR SERVICE PRIOR TO ANY EXCAVATION**


☐ **IMPROVEMENT PERMIT** *with plat valid without expiration.* ☐ **IMPROVEMENT PERMIT** *with site plan valid for 60 mos.* ☐ **AUTHORIZATION TO CONSTRUCT** *valid for period equal to IMPROVEMENT PERMIT--not to exceed 60 mo.*

Owner / Applicant Signature: Date: 6/24/16 Installed by:

IMPROVEMENT PERMIT by: Date: OPERATION PERMIT by: Date:

AUTHORIZATION TO CONSTRUCT by: Date: Existing System Inspected by: APPROVED Date: JUN 14 2016

Health Dept. Copy - WHITE Applicant (Final Approval) - YELLOW Applicant (Conditional Approval) - PINK

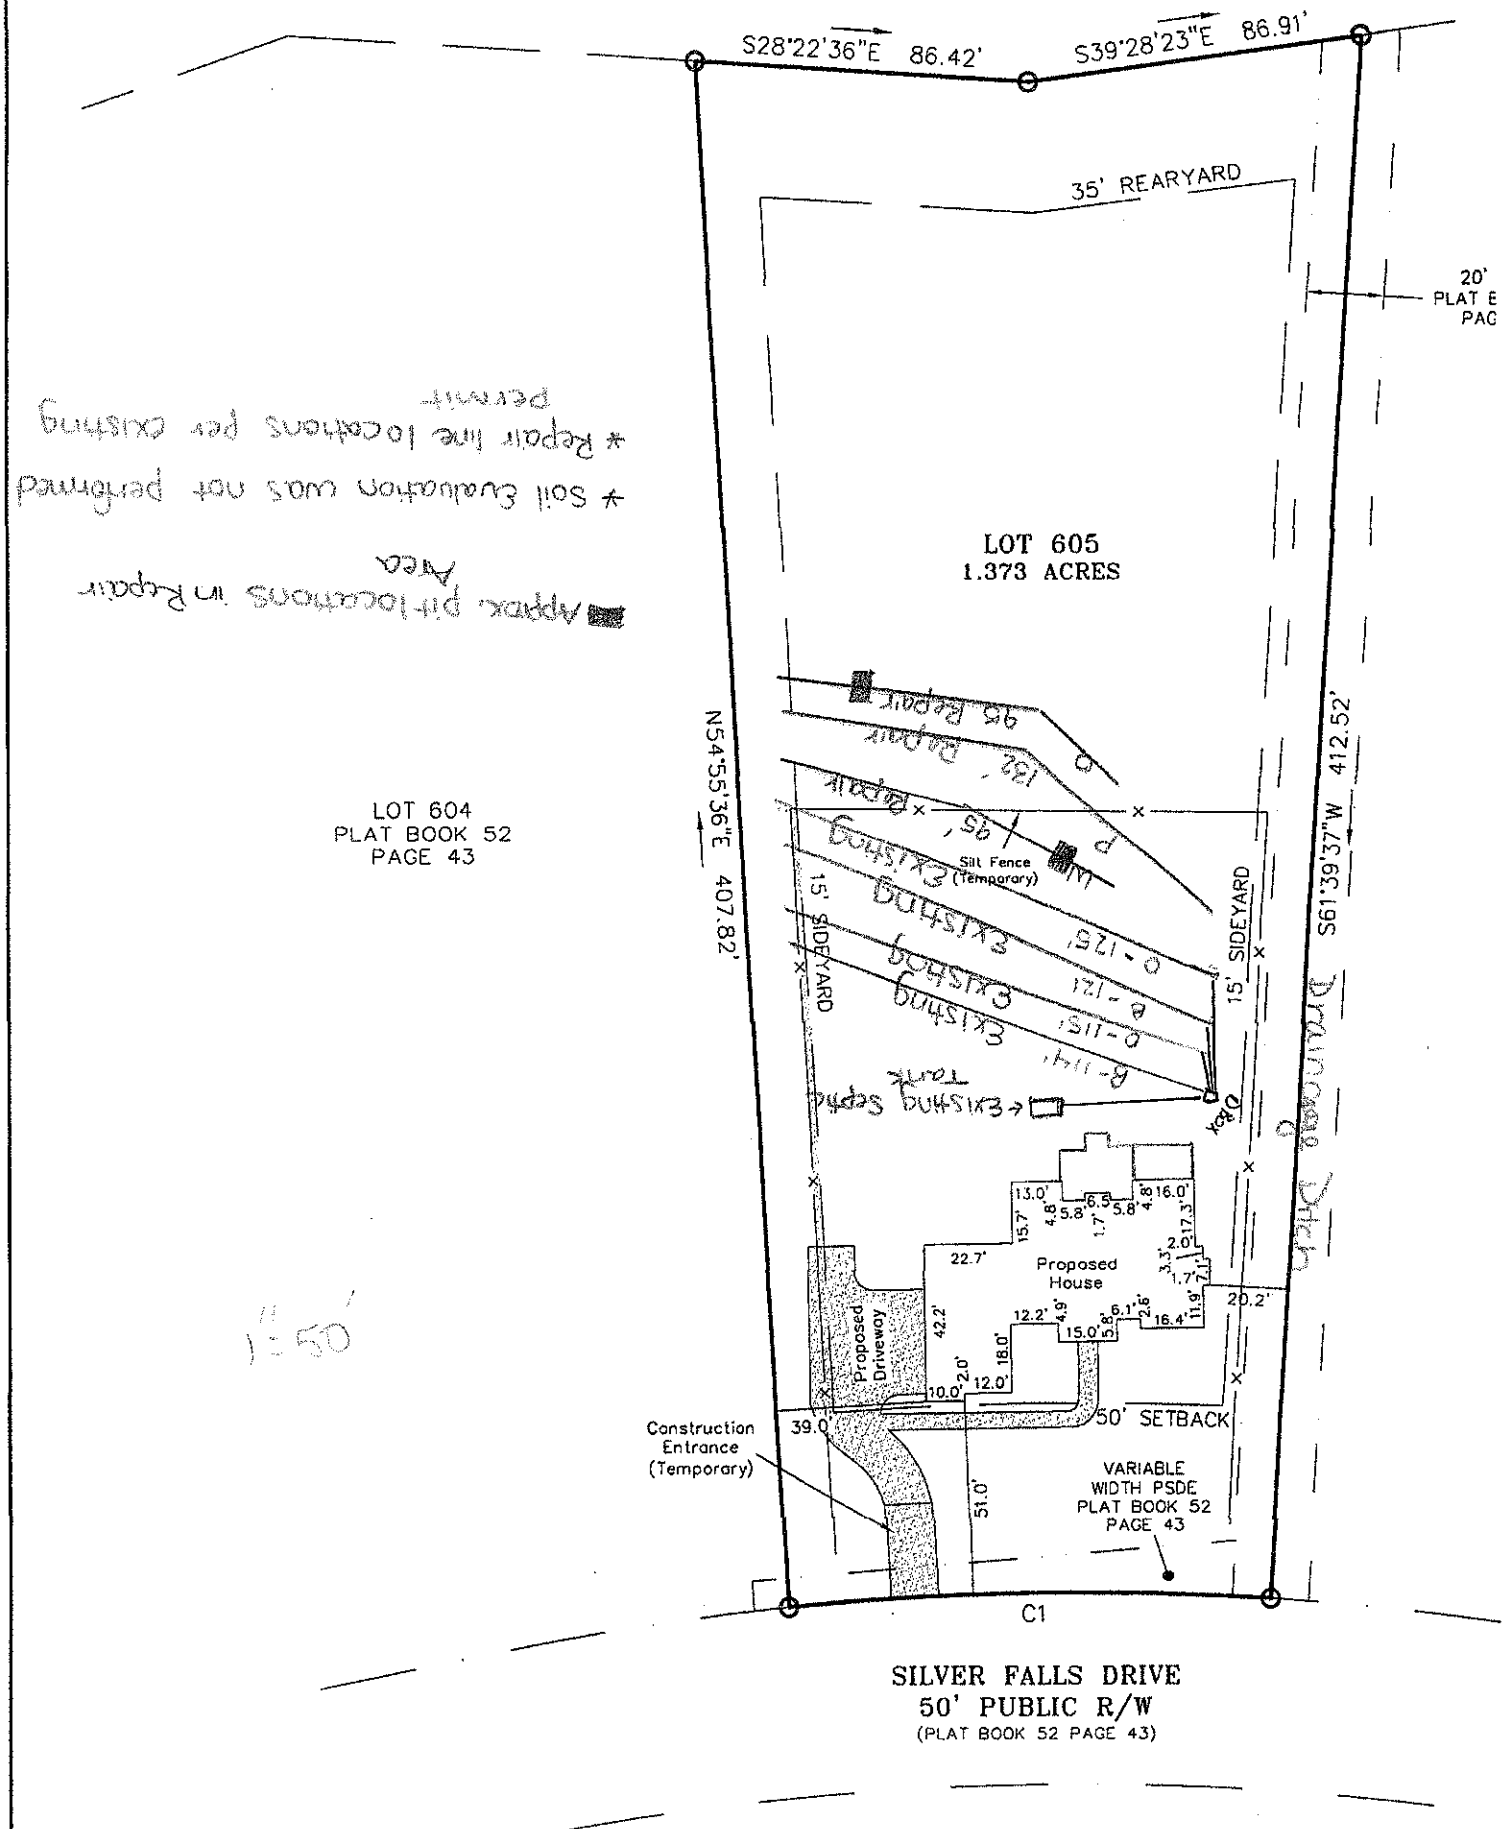

* Repair line locations per existing permit

* Soil Evaluation was not performed

Approx pit locations in Repair Area

1" = 50'

PLOT PLAN
LOT 605 – FALLS COVE–PARKWOOD