2:00

IREDELL COUNTY HEALTH DEPARTMENT

STATESVILLE 704-878-5305 MOORESVILLE 704-664-5281

IMPROVEMENT PERMIT / CERTIFICATE OF COMPLETION / OPERATION PERMIT / EXISTING SYSTEM INSPECTION

PROPERTY DESCRIPTION NO. Repair DATE 6-28-95 TAX MAP NO. Repair Watershed: ☐ Yes ☑ No

OWNER OR CONTRACTOR Randy Garwood PHONE: Business (828) 932-7873 Home 528-3600

ADDRESS 407 State Park Rd. Troutman, N.C. 28166

LOCATION From Troutman take Perth Rd TR State Park Rd 1st house on L past Luckhard Rd. (on corner)

SUBDIVISION NA BLOCK / SECTION — LOT — LOT AREA ~20 acres SITE CLASS. P.S. DESIGN FLOW 480 L.T.A.R. .3 gal/ft²

Septic Tank: Existing Gallons; STB — Date —
Pump Tank: — Gallons; PT — Date —
Pump Make: — Model — Serial No. —
Nitrification Field: No Fields 2 Square Feet ~~1000~~ 1125 Linear Feet ~~750~~ 375
No Lines 3 Trench Width 36" Max Trench Bottom Depth 36" Gravel Depth 12"

☐ New System ☑ Repair System Type: I, II, III, IV, V, VI
System Description: conventional, gravity fed
Repair System Description:
Maintenance Agreement Required: ☐ Yes ☑ No


☑ House/Mod. Home No. Bedrooms 4
☐ Mobile Home No. Bathrooms 2
☐ Business No. Employees —
☐ Other —
☐ Slab ☑ Crawl Space ☐ Basement w/plumbing ☐ Basement wo/plumbing

Water Supply: ☑ Individual ☐ Community ☐ Public

Comments: Install drop Box in the end of existing drainfield, run to Dbox and add 333' of drain line, 200' for repair and 133' for additional Bedroom. Re-cut ditches as shown on permit to run surface water away from system. Fill in low area over existing drainlines.

Comments: New Tee set Sch40 + 80' 3" Sch Pipe Run to 1st box 12-5-95

INITIAL SITE SKETCH (smooth off)

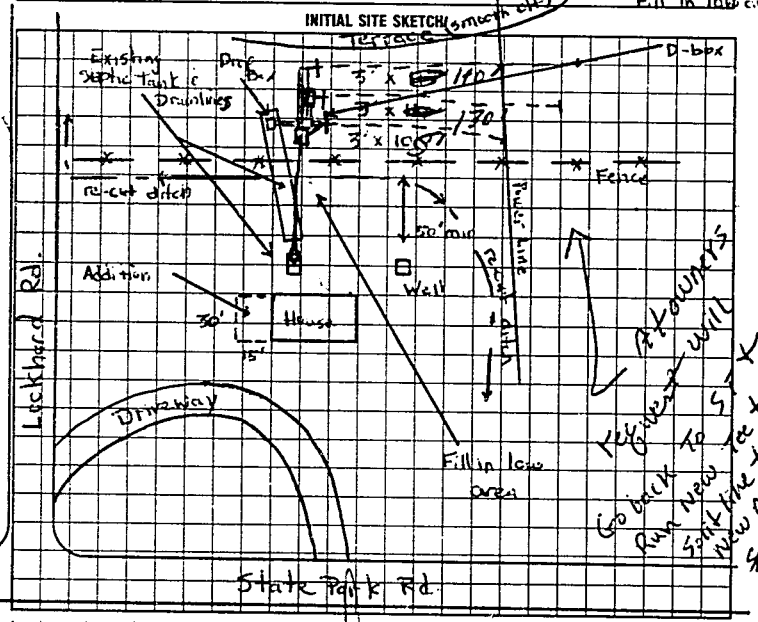

AS BUILT SKETCH

Install washing machine line into septic system. Smooth off terrace below repair lines. Check integrity of septic tank and add new sanitary tee if needed. Keep system 6' from existing drain lines and max feasable distance from well and no closer than 50'.

* System installed to accomodate a 4 Bedroom home. House is a 3 Bedroom at current time. Adding 200' for repair., 133' for the addition of one bedroom

Homeowners will Go back to Tee & Run new line to split line to new drain

Start & Ast 10 360' of Elimwater Dist Box 10-16-95

I understand that this permit can be suspended or revoked if any false information is supplied toward securing the permit/any unauthorized changes are made to the site/any unauthorized changes are made in the installation of the system. Improvement Permit is valid for 60 months from date of issuance.

Signed: X

Improvement Permit by: Michael O. Dawson date 6-28-95

Existing System Inspection by — date —

Installed by: A-1 Backhoe

Certificate of Completion by: — date —

Operation Permit by: L. C. Moore date 12-5-95

HEALTH DEPT. COPY: WHITE INSPECTION COPY (FINAL): GREEN OWNER COPY (FINAL): YELLOW INSPECTION COPY (INITIAL): PINK OWNER COPY (INITIAL): GOLD

92E000