IREDELL COUNTY HEALTH DEPARTMENT


ENVIRONMENTAL HEALTH DIVISION

PAGE 2: *SITE PLAN WORKSHEET*

SEE THE "SAMPLE SITE PLAN" BELOW. *INCOMPLETE SITE PLANS WILL BE RETURNED TO YOU FOR COMPLETION AND MAY RESULT IN A DELAY IN THE ISSUANCE OF YOUR SEPTIC SYSTEM PERMIT!!!*

Place an (X) beside each item as you complete the site plan:

( ) Property Line measurements are clearly identified
( ) All proposed structures are indicated
( ) Front and side setbacks from property line
( ) Preferred driveway location and well location
( ) Area you prefer your septic system to be placed
( ) North arrow, or other sufficient indicator of direction

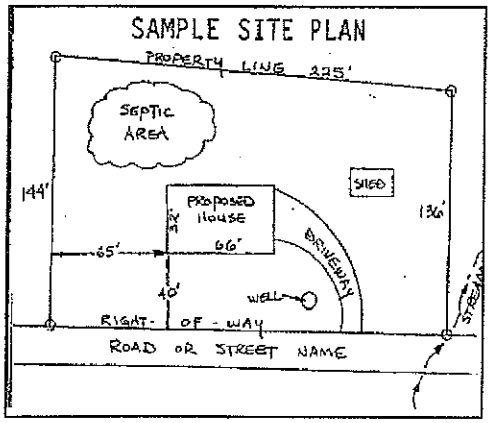

Circle N/A on the following if appropriate:

Location of septic systems and wells within 100' of your property	N/A
Location of easements and rights of ways on your property	N/A
Location of any designated wetlands on the property	N/A

USE THIS SPACE TO DRAW YOUR SITE PLAN

Show: proposed house or business footprint, wells, water lines, patios, pools and decks, and any other item that will occupy space on the site

SEE ATTACHED

Signature: _____ 10/29/15

Property owner or owner's legal representative signature (SIGNATURE REQUIRED) DATE

IREDELL COUNTY HEALTH DEPARTMENT

STATESVILLE 704-878-5305 MOORESVILLE 704-664-5281

IMPROVEMENT PERMIT / AUTHORIZATION TO CONSTRUCT / OPERATION PERMIT / EXISTING SYSTEM INSPECTION

DATE 10/24/00

PERMIT# PINE

OWNER OR CONTRACTOR Sandi Micael PHONE: Business Home 799-8154

ADDRESS Po Box 1234 Troutman NC 28166

LOCATION Perth, R State Park, on Lt just Past Henry Cutt Rd

SUBDIVISION BLOCK / SECTION LOT LOT AREA SITE CLASS PS DESIGN FLOW 360 L.T.A.R. 0.3

Septic Tank: 1000 Gallons: STS 312 Date 3/27/00

Pump Tanic Gallons: PT Date

Pump Make: Model Serial No.

Nitrification Field: No Fields 1 Square Feet 960 Linear Feet 300

No Lines 4 @ 25 Trench Width 36" Max Trench Bottom Depth 36" Gravel Depth

New System ☐ Repair System Type: I, II, III, IV, V

System Description: Gravity 25% Rock

Repair System Description: Conv PPBS

Maintenance Agreement Received: ☐ Yes ☐ No

☒ House/Mod. Home ☐ Mobile Home ☐ Business ☐ Other

No. Bedrooms 3 No. Bathrooms 2 No. Employees

☐ Slab ☒ Crawl Space ☐ Basement w/plumbing ☐ Basement w/o plumbing


Water Supply: ☒ Individual ☐ Public ☐ Community

Comments/Conditions: Keep system 50' minimum from well - Existing tank needs to be pumped, crushed & Filled


System upgrade for property sale

Comments/Conditions: C-1 & C installed

INITIAL SITE SKETCH

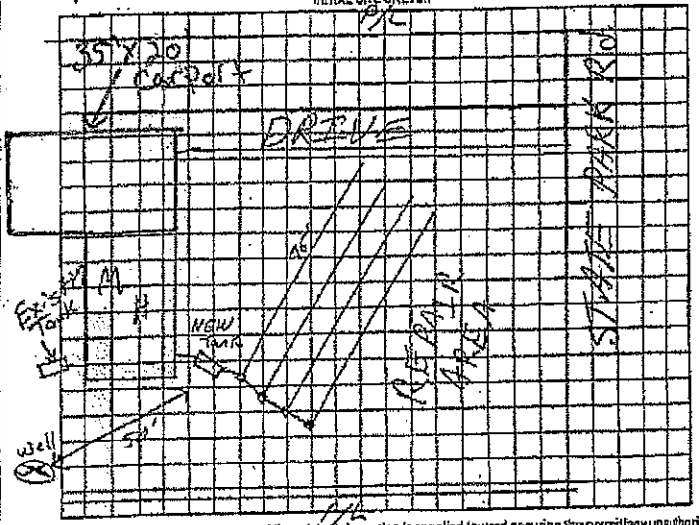


AS BUILT SKETCH

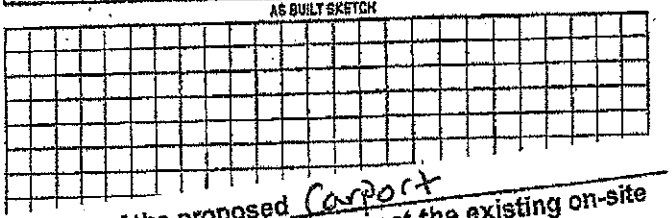

Location of the proposed Carport addition does not appear to impact the existing on-site septic system.**NOTE: with Reservation REHS

Date: 7-6-12

ICHD-Environmental Health Division

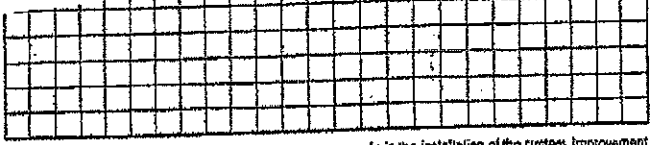

Permit can be suspended or revoked if any false information is supplied toward securing the permit any unauthorized changes are made to the site any unauthorized changes are made in the installation of the system. Improvement Permit with plat valid without expiration, Improvement Permit with site plan valid for sixty months. Authorization to Construct is valid for a period equal to that of Improvement Permit -- not to exceed sixty months.

Signed: Rosemary Micael date 11-1-00

Installed by: G. Sigmon Grading

Improvement Permit by: [signature] RST date 10/24/00

Operation Permit by: [signature] RST date 11/16/00

Authorization to Construct by: [signature] RST date 10/24/00

Existing System Inspection by: date

HEALTH DEPT. COPY: WHITE OWNER COPY (FINAL): YELLOW OWNER COPY (INITIAL): PINK