IREDELL COUNTY HEALTH DEPARTMENT

STATESVILLE 704-878-5305 MOORESVILLE 704-664-5281

IMPROVEMENT PERMIT / CERTIFICATE OF COMPLETION / OPERATION PERMIT / EXISTING SYSTEM INSPECTION

PROPERTY DESCRIPTION NO. 21.077 SR#203 DATE 2-3-97 TAX MAP NO. 4730250180 Watershed: ☐ Yes ☐ No

OWNER OR CONTRACTOR Keith Nance PHONE: Business _____ Home 528-4225 WSIV PA

ADDRESS PO Box 1310 Troutman NC

LOCATION Perth Rd. TR State Perth TR Hicks Creek TR Brendle Hill Upon Right at Cul de sack

SUBDIVISION Brendle Hill BLOCK / SECTION _____ LOT 8 & 9 LOT AREA 1.19ac. SITE CLASS. P/S DESIGN FLOW 360 L.T.A.R. 0.3

Septic Tank: 1000 Gallons; STB 1012 Date 10-13-97

Pump Tank: _____ Gallons; PT _____ Date _____

Pump Make: _____ Model _____ Serial No. _____

Nitrification Field: No Fields 4 Square Feet 1200 Linear Feet 400

No Lines 4 Trench Width 30 Max Trench Bottom Depth 36 Gravel Depth 12

☒ New System ☐ Repair System Type: I, II, III, IV, V, VI

System Description: Gravity Conventional "C" chamber/Pane

Repair System Description: _____

Maintenance Agreement Required: ☐ Yes ☒ No

☒ House/Mod. Home No. Bedrooms 3

☐ Mobile Home No. Bathrooms 2½

☐ Business No. Employees _____

☐ Other _____


☐ Slab ☒ Crawl Space ☐ Basement w/plumbing ☐ Basement wo/plumbing

Water Supply: ☒ Individual ☐ Community ☐ Public

Comments: Keep lines on contour 9ft on center. 125' Keepwell 50ft from systems

Comments:

INITIAL SITE SKETCH

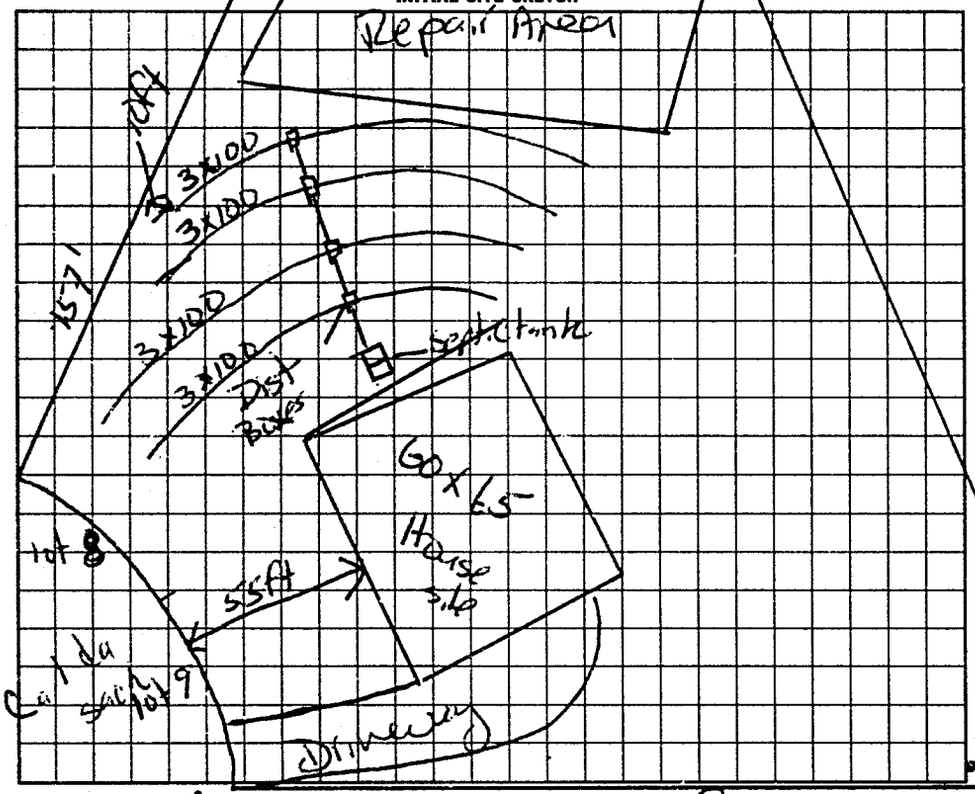

AS BUILT SKETCH

Installed as shown

I understand that this permit can be suspended or revoked if any false information is supplied toward securing the permit/any unauthorized changes are made to the site/any unauthorized changes are made in the installation of the system. Improvement Permit is valid for 60 months from date of issuance. Authorization to construct expires 5 yrs from issue date

Signed: Keith Nance

Improvement Permit by: Mark C Ort RS date 2-3-97

Existing System Inspection by: Authorization to re-use Mark C Ort RS. date 2-3-97

Installed by: David Yountz

Certificate of Completion by: _____ date _____

Operation Permit by: Mark C Ort RS date 1-21-98

HEALTH DEPT. COPY: WHITE INSPECTION COPY (FINAL): GREEN OWNER COPY (FINAL): YELLOW INSPECTION COPY (INITIAL): PINK OWNER COPY (INITIAL): GOLD