44665

TOWN OF TROUTMAN.

IREDELL COUNTY HEALTH DEPARTMENT

IMPROVEMENT PERMIT AND CERTIFICATE OF COMPLETION / OPERATIONS PERMIT

OWNER OR CONTRACTOR JERRY KENNEDY DATE 9-3-92. PERMIT NO. 3E-A-38.

PHONE: Business _____ Home _____

LOCATION Talley St. off Hwy 21S - go past Inglewood Dev. T.L. on Lytton Rd. - follow straight to end on R.

S.R. No. _____

SUBDIVISION NAME _____ LOT NO. _____ SECTION OR BLOCK NO. _____

House ☐ Mobile Home ☑ Business ☐ Other _____

No. Bedrooms 3 No. Bathrooms 1

Garbage Disposal Unit Yes ☐ No ☑

Auto. Dishwasher Yes ☐ No ☑

Auto. Wash. Maching Yes ☑ No ☐

Lot Area 375' X 200'

Soil Characteristics Prov. Suitable.

Application Rate 4 gal./sq. ft.

Topography 6-10%

Depth to Water Table 18"

Rock or other impervious formations none observed.

Basement with Plumbing _____ Basement without Plumbing _____ No Basement _____ Crawl Space _____

Size of Tank 1000 Gals.

Nitrification Field:


No. of Lines 4

Sq. Ft. 900 Linear Ft. 300

Depth of Stone in Lines 12"

Water Supply: Individual ☑

Public ☐

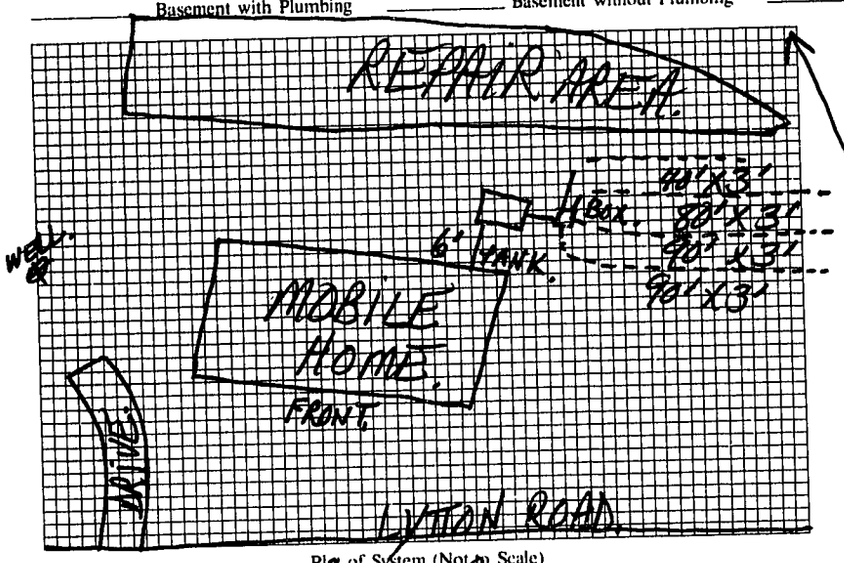

Plan of System (Not to Scale)

Installed by James Hudler

I understand and agree to install a septic tank system as specified on this Improvement Permit.

Signed: _____

(IMPROVEMENT PERMIT IS VALID FOR 60 MONTHS FROM DATE OF ISSUE.)

IMPROVEMENT PERMIT BY Steve Brown

COMMENTS _____

CERTIFICATE OF COMPLETION BY Steve Brown DATE 9-3-92.

EXISTING SYSTEM CHECKED BY _____ DATE _____

CONSTRUCTION MUST COMPLY WITH ALL OTHER APPLICABLE STATE AND LOCAL REGULATIONS

Permit is VOID if any unauthorized changes are made in installation of system, and/or if any unapproved changes are made to the site, and/or if any false information is supplied toward securing Improvement Permit.

Health Dept. Copy: White Inspection Dept. Copy: Yellow Sanitarian's Copy: Pink Owner's Copy: Gold