IREDELL COUNTY HEALTH DEPARTMENT

STATESVILLE 704-878-5305 MOORESVILLE 704-664-5281

IMPROVEMENT PERMIT / AUTHORIZATION TO CONSTRUCT / OPERATION PERMIT / EXISTING SYSTEM INSPECTION

PERMIT# 92114 PIN# 4730330610 DATE 10/3/00

OWNER OR CONTRACTOR Sam Gandy PHONE: Business 704 892-9039 Home

ADDRESS PO Box 4182 Mooresville NC 28117

LOCATION ST Park, L Lockhard, 5th Lot on Lt.

SUBDIVISION ST Park Meadows BLOCK / SECTION LOT 6 LOT AREA 4.23 SITE CLASS PS DESIGN FLOW 360 L.T.A.R. 0.25

Septic Tank: 1000 Gallons; STB 312 Date 11/6/00
Pump Tank: Gallons; PT Date
Pump Make: Model Serial No.
Nitrification Field: No Fields 1 Square Feet 1440 Linear Feet 480
No Lines 4@120 Trench Width 36" Max Trench Bottom Depth 36" Gravel Depth 12"

[X] New System [ ] Repair System Type: [I] II, III, IV, V, VI
System Description: Gravity Conventional
Repair System Description: Pump Conventional
Maintenance Agreement Required: [ ] Yes [X] No

[X] House/Mod. Home [ ] Mobile Home [ ] Business [ ] Other
No. Bedrooms 3 No. Bathrooms 2 No. Employees


[ ] Slab [X] Crawl Space [ ] Basement w/plumbing [ ] Basement wo/plumbing

Water Supply: [X] Individual [ ] Public [ ] Community


Comments:/Conditions:
Keep well 100' from septic system
1:100 Scale

Comments:/Conditions:

INITIAL SITE SKETCH

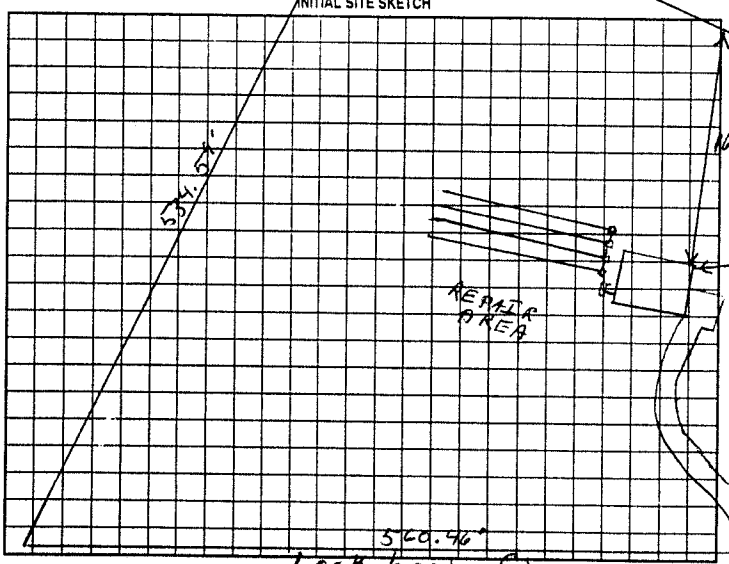

AS BUILT SKETCH

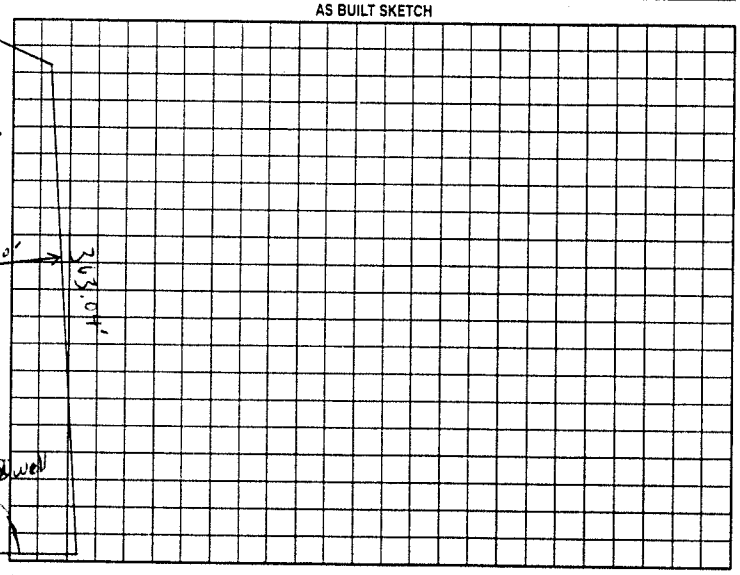

Permit can be suspended or revoked if any false information is supplied toward securing the permit/any unauthorized changes are made to the site/any unauthorized changes are made in the installation of the system. Improvement Permit with plat valid without expiration. Improvement Permit with site plan valid for sixty months. Authorization to Construct is valid for a period equal to that of Improvement Permit – not to exceed sixty months.

Signed: Dinah Gandy date 10/4/00 Installed by: F J Ervin

Improvement Permit by: RSI date 10/3/00 Operation Permit by: RSI date 1/16/00

Authorization to Construct by: RSI date 10/3/00 Existing System Inspection by: date

HEALTH DEPT. COPY: WHITE OWNER COPY (FINAL): YELLOW OWNER COPY (INITIAL): PINK