IREDELL COUNTY HEALTH DEPARTMENT

STATESVILLE 704-878-5305 MOORESVILLE 704-664-5281

IMPROVEMENT PERMIT / AUTHORIZATION TO CONSTRUCT / OPERATION PERMIT / EXISTING SYSTEM INSPECTION

PERMIT# 76579 PIN# 4730 32 3181 DATE 9-29-98

OWNER OR CONTRACTOR Kay B. Champion PHONE: Business Home 528 9931

ADDRESS 215 Lockhart Cir.

LOCATION St. Park Rd TL Lockhart 1/2 mi left

SUBDIVISION BLOCK / SECTION LOT LOT AREA .88 acres SITE CLASS. DESIGN FLOW L.T.A.R.

Septic Tank: 1000 Gallons; STB Date

Pump Tank: Gallons; PT Date

Pump Make: Model Serial No.

Nitrification Field: No Fields 1 Square Feet 300 Linear Feet 100

No Lines 1 Trench Width 36" Max Trench Bottom Depth 36" Gravel Depth 12"

☒ New System ☐ Repair System Type: I, ☒ II, III, IV, V, VI

System Description: Con Gravity

Repair System Description:

Maintenance Agreement Required: ☐ Yes ☐ No

☐ House/Mod. Home ☒ Mobile Home ☐ Business ☐ Other

No. Bedrooms 3 No. Bathrooms 2 No. Employees

Water Supply: ☒ Individual ☐ Public ☐ Community

☐ Slab ☒ Crawl Space ☐ Basement w/plumbing ☐ Basement wo/plumbing


Comments:/Conditions:

Cut existing line that will be covered by Deck

Comments:/Conditions:

System installed 5-26-88
Nolan Champion For 3 Bedroom Home

INITIAL SITE SKETCH

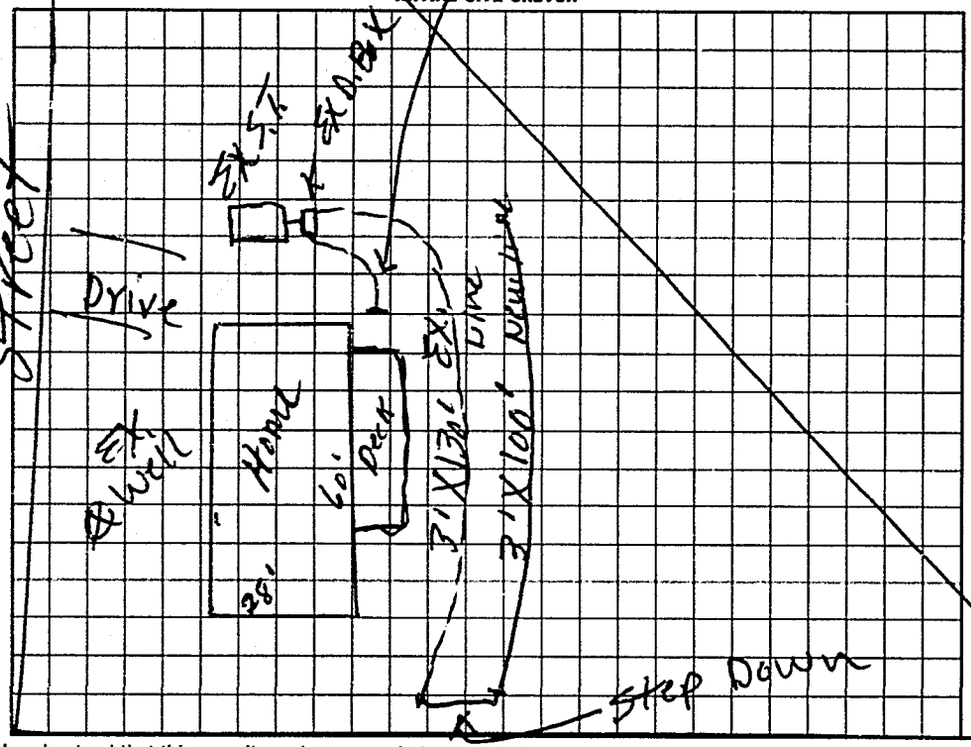

AS BUILT SKETCH

Add 100' of Drain line To Replace what is covered By New Home + Deck

Installed as shown

I understand that this permit can be suspended or revoked if any false information is supplied toward securing the permit/any unauthorized changes are made to the site/any unauthorized changes are made in the installation of the system. Improvement Permit with plat valid without expiration. Improvement Permit with site plan valid for sixty months. Authorization to Construct is valid for a period equal to that of Improvement Permit – not to exceed sixty months.

Signed: Kay Champion Cook date 9-29-98 Installed by: Tim Ammons

Improvement Permit by: P. C. Moore date 9-29-98 Operation Permit by: Mat Coffey RS date 10-13-98

Authorization to Construct by: P. C. Moore date 9-29-98 Existing System Inspection by: date

HEALTH DEPT. COPY, WHITE INSPECTION COPY (FINAL), GREEN OWNER COPY (FINAL), YELLOW INSPECTION COPY (INITIAL), PINK OWNER COPY (INITIAL), GOLD