IREDELL COUNTY HEALTH DEPARTMENT

CI

STATESVILLE 704-878-5305 MOORESVILLE 704-664-5281

IMPROVEMENT PERMIT / AUTHORIZATION TO CONSTRUCT / OPERATION PERMIT / EXISTING SYSTEM INSPECTION

PERMIT# 135932 PIN# 4730-32-9940 704-902-5826 DATE 06/30/06

OWNER OR APPLICANT JEFFERY MORRISON PHONE: Business 704-902-5412 Home 704-892-8261

ADDRESS 110 STEAM ENGINE DR. UNIT 209 MOORESVILLE, NC 28115

LOCATION HWY 21 SOUTH, (R) PERTH RD., (R) STATE PARK RD., (L) HONEYCUTT RD., (R) HOLLY BRANCH, PROPERTY ON LEFT.

SUBDIVISION HOLLY BRANCH BLOCK / SECTION _____ LOT 22 LOT AREA 1.73 ACRES SITE CLASS. PS DESIGN FLOW 480 GPD L.T.A.R. 0.30 GPD/FT²

Septic Tank: 1,000 Gallons; STB 1007 Date 9-29-06
Pump Tank: _____ Gallons; PT _____ Date _____
Pump Make: _____ Model _____ Serial No. _____
Nitrification Field: No Fields 1 Square Feet EQ to 1,600 Linear Feet 400'
No Lines 4@100' Trench Width 36" Max Trench Bottom Depth 24"

☒ New System ☐ Repair ☐ Expansion System Type: I II III IV V VI
System Description: 25% REDUCTION, GRAVITY
Repair System Description: 25% REDUCT, GRAVITY/Pump
Maintenance Agreement Required: ☐ Yes ☒ No
Gravel Depth N/A ☒ Gravity ☐ Pressure ☒ Slab ☐ Crawl Space ☐ Basement w/plumbing ☐ Basement wo/plumbing


☒ House/Mod. Home No. Bedrooms 4
☐ Mobile Home No. Persons ____
☐ Business No. Employees ____
☐ Other ____

Water Supply: ☒ Individual WELL ☐ Public ☐ Community


Comments:/Conditions: (1) DO NOT GRADE OR FILL ANY SOIL IN SEPTIC AREA. (2) MAXIMUM TRENCH BOTTOM DEPTH OF 24".

Comments:/Conditions: Brown Filter

INITIAL SITE SKETCH

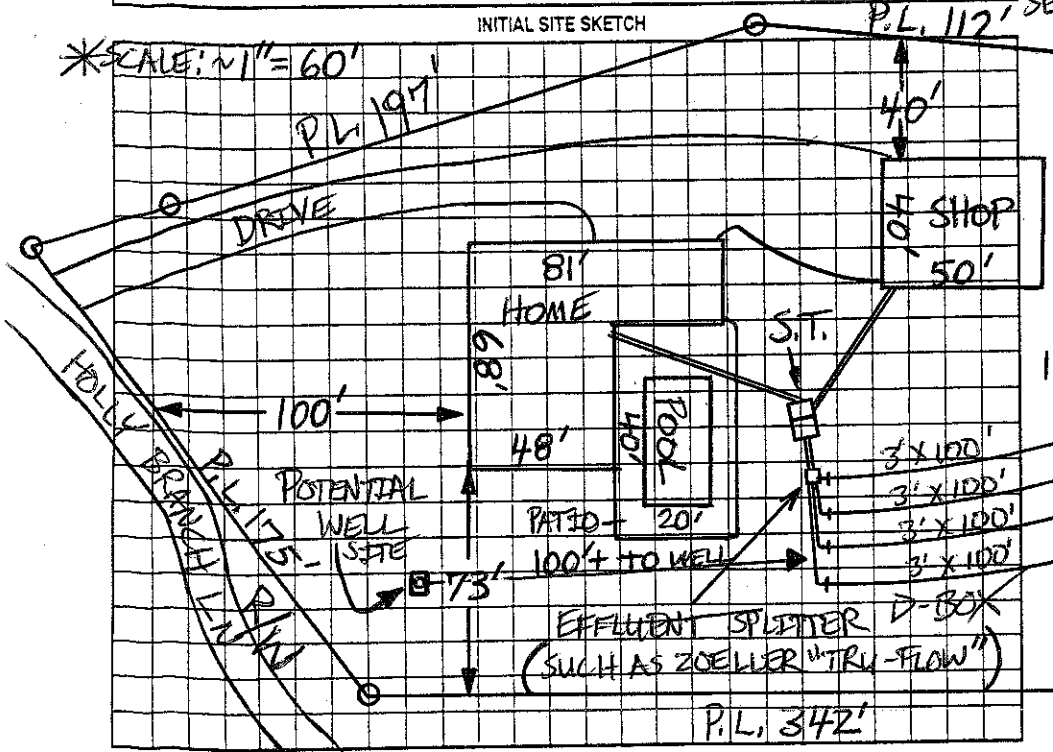

AS BUILT SKETCH

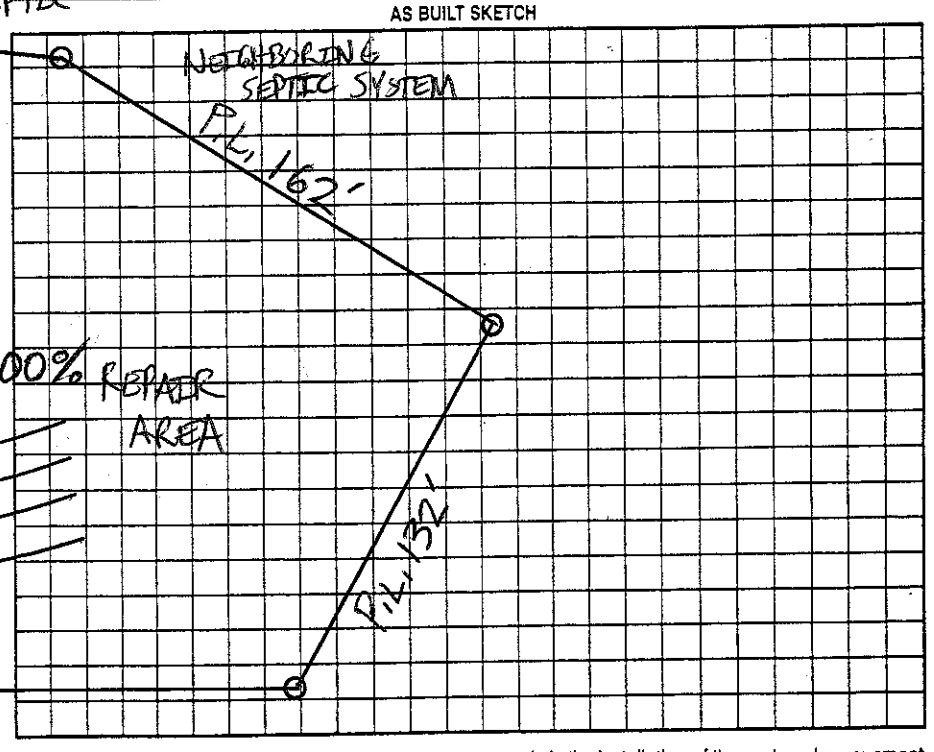

Permit can be suspended or revoked if any false information is supplied toward securing the permit/any unauthorized changes are made to the site/any unauthorized changes are made in the installation of the system. Improvement Permit with plat valid without expiration ☐ Improvement Permit with site plan valid for sixty months ☒ Authorization to Construct is valid for a period equal to that of Improvement Permit – not to exceed sixty months.

Issued: _____ date 07-30-06 Installed by: James Huddle

Improvement Permit by: _____ date 06/30/06 Operation Permit by: _____ date 11/28/06

Authorization to Construct by: _____ date 06/30/06 Existing System Inspection by: _____ date _____

HEALTH DEPT. COPY: WHITE OWNER COPY (FINAL): YELLOW OWNER COPY (INITIAL): PINK