# IREDELL COUNTY HEALTH DEPARTMENT

STATESVILLE 704-878-5305 MOORESVILLE 704-664-5281

## IMPROVEMENT PERMIT / CERTIFICATE OF COMPLETION / OPERATION PERMIT / EXISTING SYSTEM INSPECTION

PROPERTY DESCRIPTION NO. 25044 DATE 9-25-96 TAX MAP NO. 3F7A22J Watershed: ☐ Yes ☐ No

OWNER OR CONTRACTOR Douglas Dunham PHONE: Business Home 664 7292 WSIV CA

ADDRESS 1180 Brawley Sch Rd Mooresville NC

LOCATION Perth Rd TR State Park Rd TL Honeycutt Rd lot on left Before Holly Branch

SUBDIVISION BLOCK / SECTION LOT LOT AREA 6 acres SITE CLASS. I/S DESIGN FLOW 360 L.T.A.R. .23

Septic Tank: 1000 Gallons; STB OB Date 2-4-98

Pump Tank: Gallons; PT Date

Pump Make: Model Serial No.

Nitrification Field: No Fields 1 Square Feet 1200 Linear Feet 400

No Lines 4 Trench Width 36in Max Trench Bottom Depth 36in Gravel Depth 12in

☒ New System ☐ Repair System Type: I, II, III, IV, V, VI

System Description: gravity Conventional

Repair System Description: gravity Conventional

Maintenance Agreement Required: ☐ Yes ☒ No

☒ House/Mod. Home ☐ Mobile Home ☐ Business ☐ Other


No. Bedrooms 3 No. Bathrooms 2 No. Employees

☐ Slab ☒ Crawl Space ☐ Basement w/plumbing ☐ Basement wo/plumbing

Water Supply: ☒ Individual ☐ Community ☐ Public


Comments: keep lines on contour, 9ft on center
keep tank min 5ft from crawlspace

INITIAL SITE SKETCH

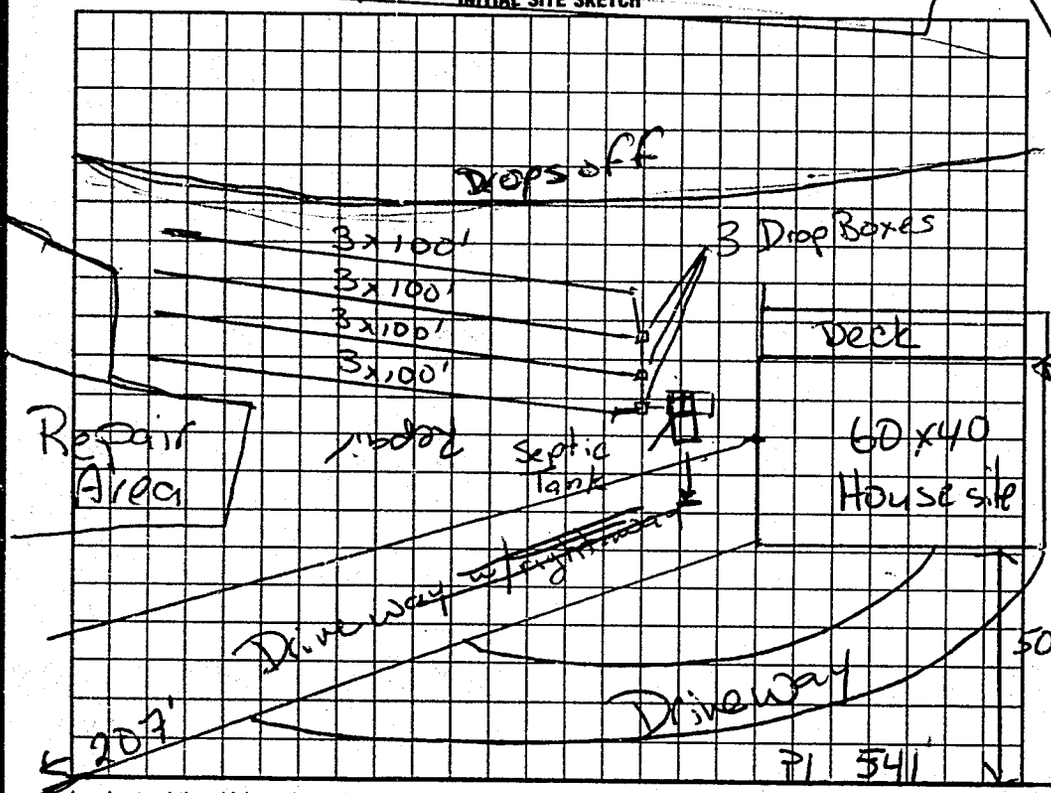


Comments: Driveway moved
Tank moved up closer to corner.

AS BUILT SKETCH

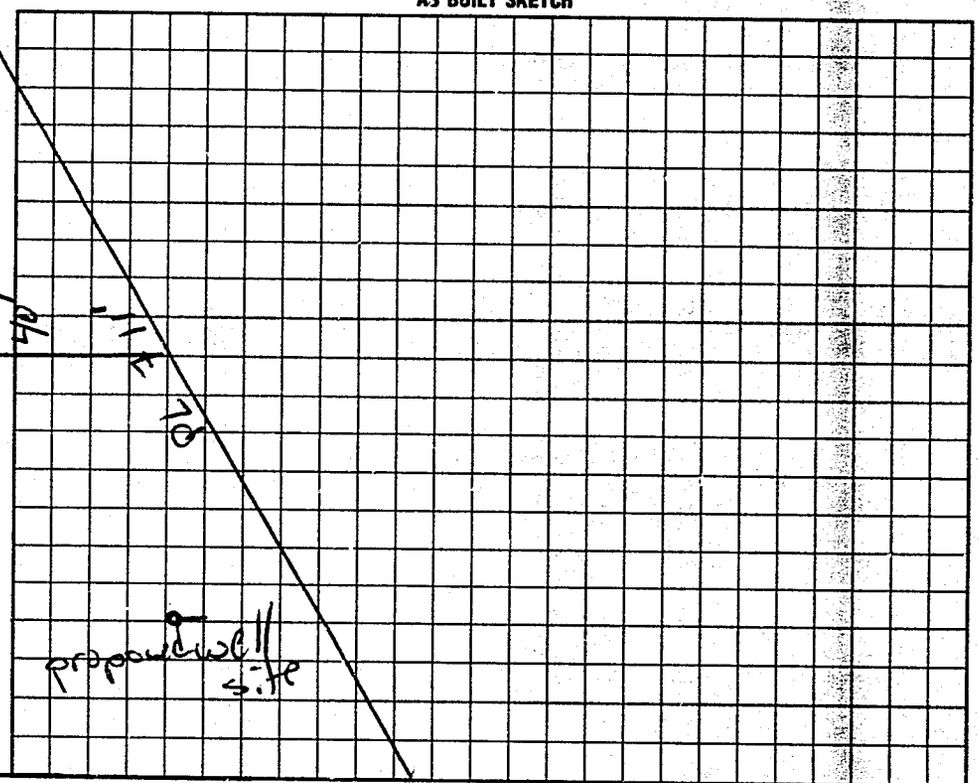


I understand that this permit can be suspended ~~or revoked~~ if any false information is supplied toward securing the permit/any unauthorized changes are made to the site/any unauthorized changes are made in the installation of the system.

Signed: X Honeycutt Rd

Improvement Permit by: Mary C Ort date 9-25-96

Existing System Inspection by: Mary C Ort date 9-25-96

Installed by: Atlantic Grading

Certificate of Completion by: date

Operation Permit by: Mary C Ort RS date 4-8-98

HEALTH DEPT. COPY: WHITE INSPECTION COPY (FINAL): GREEN OWNER COPY (FINAL): YELLOW INSPECTION COPY (INITIAL): PINK OWNER COPY (INITIAL): GOLD