9:30

IREDELL COUNTY HEALTH DEPARTMENT

STATESVILLE 704-878-5305 MOORESVILLE 704-664-5281

IMPROVEMENT PERMIT / AUTHORIZATION TO CONSTRUCT / OPERATION PERMIT / EXISTING SYSTEM INSPECTION

PERMIT# 71602 PIN# 4730 33 7646 DATE 3-9-98

OWNER OR CONTRACTOR Robert Durham PHONE: Business Home 663-6831

ADDRESS 338 Sunsown Rd mooresville

LOCATION State Rd 1148 TL Honeycutt TR Kimmel Rd on left

SUBDIVISION Holly Branch BLOCK / SECTION LOT 22K LOT AREA 3.0 acres SITE CLASS PS DESIGN FLOW 360 L.T.A.R. .73

Septic Tank: 1000 Gallons; STB #94 Date 11-6-98
Pump Tank: Gallons; PT Date
Pump Make: Model Serial No.
Nitrification Field: No Fields 1 Square Feet 1080 Linear Feet 360
No Lines 3 Trench Width 36" Max Trench Bottom Depth 36" Gravel Depth 12"

[X] New System [ ] Repair System Type: [X] II III IV V VI
System Description: conv. Gravity
Repair System Description:
Maintenance Agreement Required: [ ] Yes [X] No


[X] House/Mod. Home No. Bedrooms 3
[ ] Mobile Home No. Bathrooms 2½
[ ] Business No. Employees
[ ] Other
[ ] Slab [ ] Crawl Space [ ] Basement w/plumbing [ ] Basement wo/plumbing

Water Supply: [X] Individual [ ] Public [ ] Community

Comments:/Conditions: 108'

Comments:/Conditions:

INITIAL SITE SKETCH

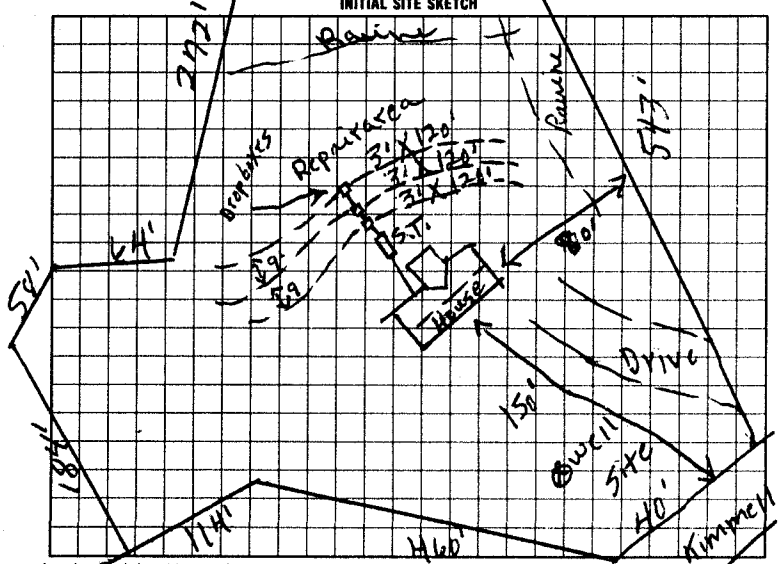

AS BUILT SKETCH

Installed as shown

I understand that this permit can be suspended or revoked if any false information is supplied toward securing the permit/any unauthorized changes are made to the site/any unauthorized changes are made in the installation of the system. Improvement Permit with plat valid without expiration. Improvement Permit with site plan valid for sixty months. Authorization to Construct is valid for a period equal to that of Improvement Permit – not to exceed sixty months.

Signed: X date

Improvement Permit by: L.C. Moore date 3-9-98

Authorization to Construct by: L.C. Moore date 3-9-98

Installed by: Alkntic Exc

Operation Permit by: May Co. of Iredell date 2-11-99

Existing System Inspection by: date

HEALTH DEPT. COPY: WHITE INSPECTION COPY (FINAL) GREEN OWNER COPY (FINAL) YELLOW INSPECTION COPY (INITIAL) PINK OWNER COPY (INITIAL) GOLD