IREDELL COUNTY HEALTH DEPARTMENT

STATESVILLE 704-878-5305 MOORESVILLE 704-664-5281

IMPROVEMENT PERMIT / AUTHORIZATION TO CONSTRUCT / OPERATION PERMIT / EXISTING SYSTEM INSPECTION

PERMIT# 152344 PIN# 4730346446 7039 DATE 9-15-08

OWNER OR APPLICANT Shanna & Stacy McGlamery PHONE: Business 704-746-4034 cell Home 704-528-7808

ADDRESS 137 Meadow Fall Lane Troutman NC 28166

LOCATION State Park Rd @ Honeysuckle box # 172 on RT

SUBDIVISION _____ BLOCK / SECTION _____ LOT 1 LOT AREA 1.67 + 1.5 SITE CLASS. PS DESIGN FLOW 480 L.T.A.R. 13

Septic Tank: 1000 Gallons; STB 1001 Date 3/17/09

Pump Tank: _____ Gallons; PT _____ Date _____

Pump Make: _____ Model _____ Serial No 4001

Nitrification Field: No Fields 1 Square Feet EQ=1600' Linear Feet 933'

No Lines 5 4 Trench Width 36" Trench Bottom Depth 36" Gravel Depth 12"

☒ New System ☐ Repair ☐ Expansion System Type: I II III IV V VI

System Description: Quick 4 Conventional

Repair System Description: same

Maintenance Agreement Required: ☐ Yes ☒ No

☒ House/Mod. Home ☐ Mobile Home ☐ Business ☐ Other

No. Bedrooms 4 No. Persons 8 No. Employees ____

Water Supply: ☒ Individual ☐ Public ☐ Community

☒ Gravity ☐ Pressure ☐ Slab ☒ Crawl Space ☐ Basement w/plumbing ☐ Basement wo/plumbing

Comments/Conditions: ① An alleted system can be used ② *Install Drainlines at 36" deep due to heaps & bumps in centerline ③ Pickup trash, Fill old tank before adding fine

INITIAL SITE SKETCH

SEE ATTACHED SYSTEM DESIGN BY LORNE COOK, R.S.

*IP ONLY UNTIL LOTS ARE COMBINED *

Comments/Conditions: addition, See Recommendations on abandoning old drainlines. ② Maintain 1/8" FALL per foot on supply line. There is 34" of fall from Stubout to 1st Drainline. ③ Addition + system flagged out completely

AS BUILT SKETCH

ALLEGATED SYSTEM WAS USED

7 QUICK 4 CHAMBERS

SEE Drawings & CHANGES

Permit can be suspended or revoked if any false information is supplied toward securing the permit/any unauthorized changes are made to the site/any unauthorized changes are made in the installation of the system. Improvement Permit with plat valid without expiration ☐ Improvement Permit with site plan valid for sixty months ☒ Authorization to Construct is valid for a period equal to that of Improvement Permit – not to exceed sixty months.

Signed: _____ date 9-15-08

Improvement Permit by: _____ date 9-15-08

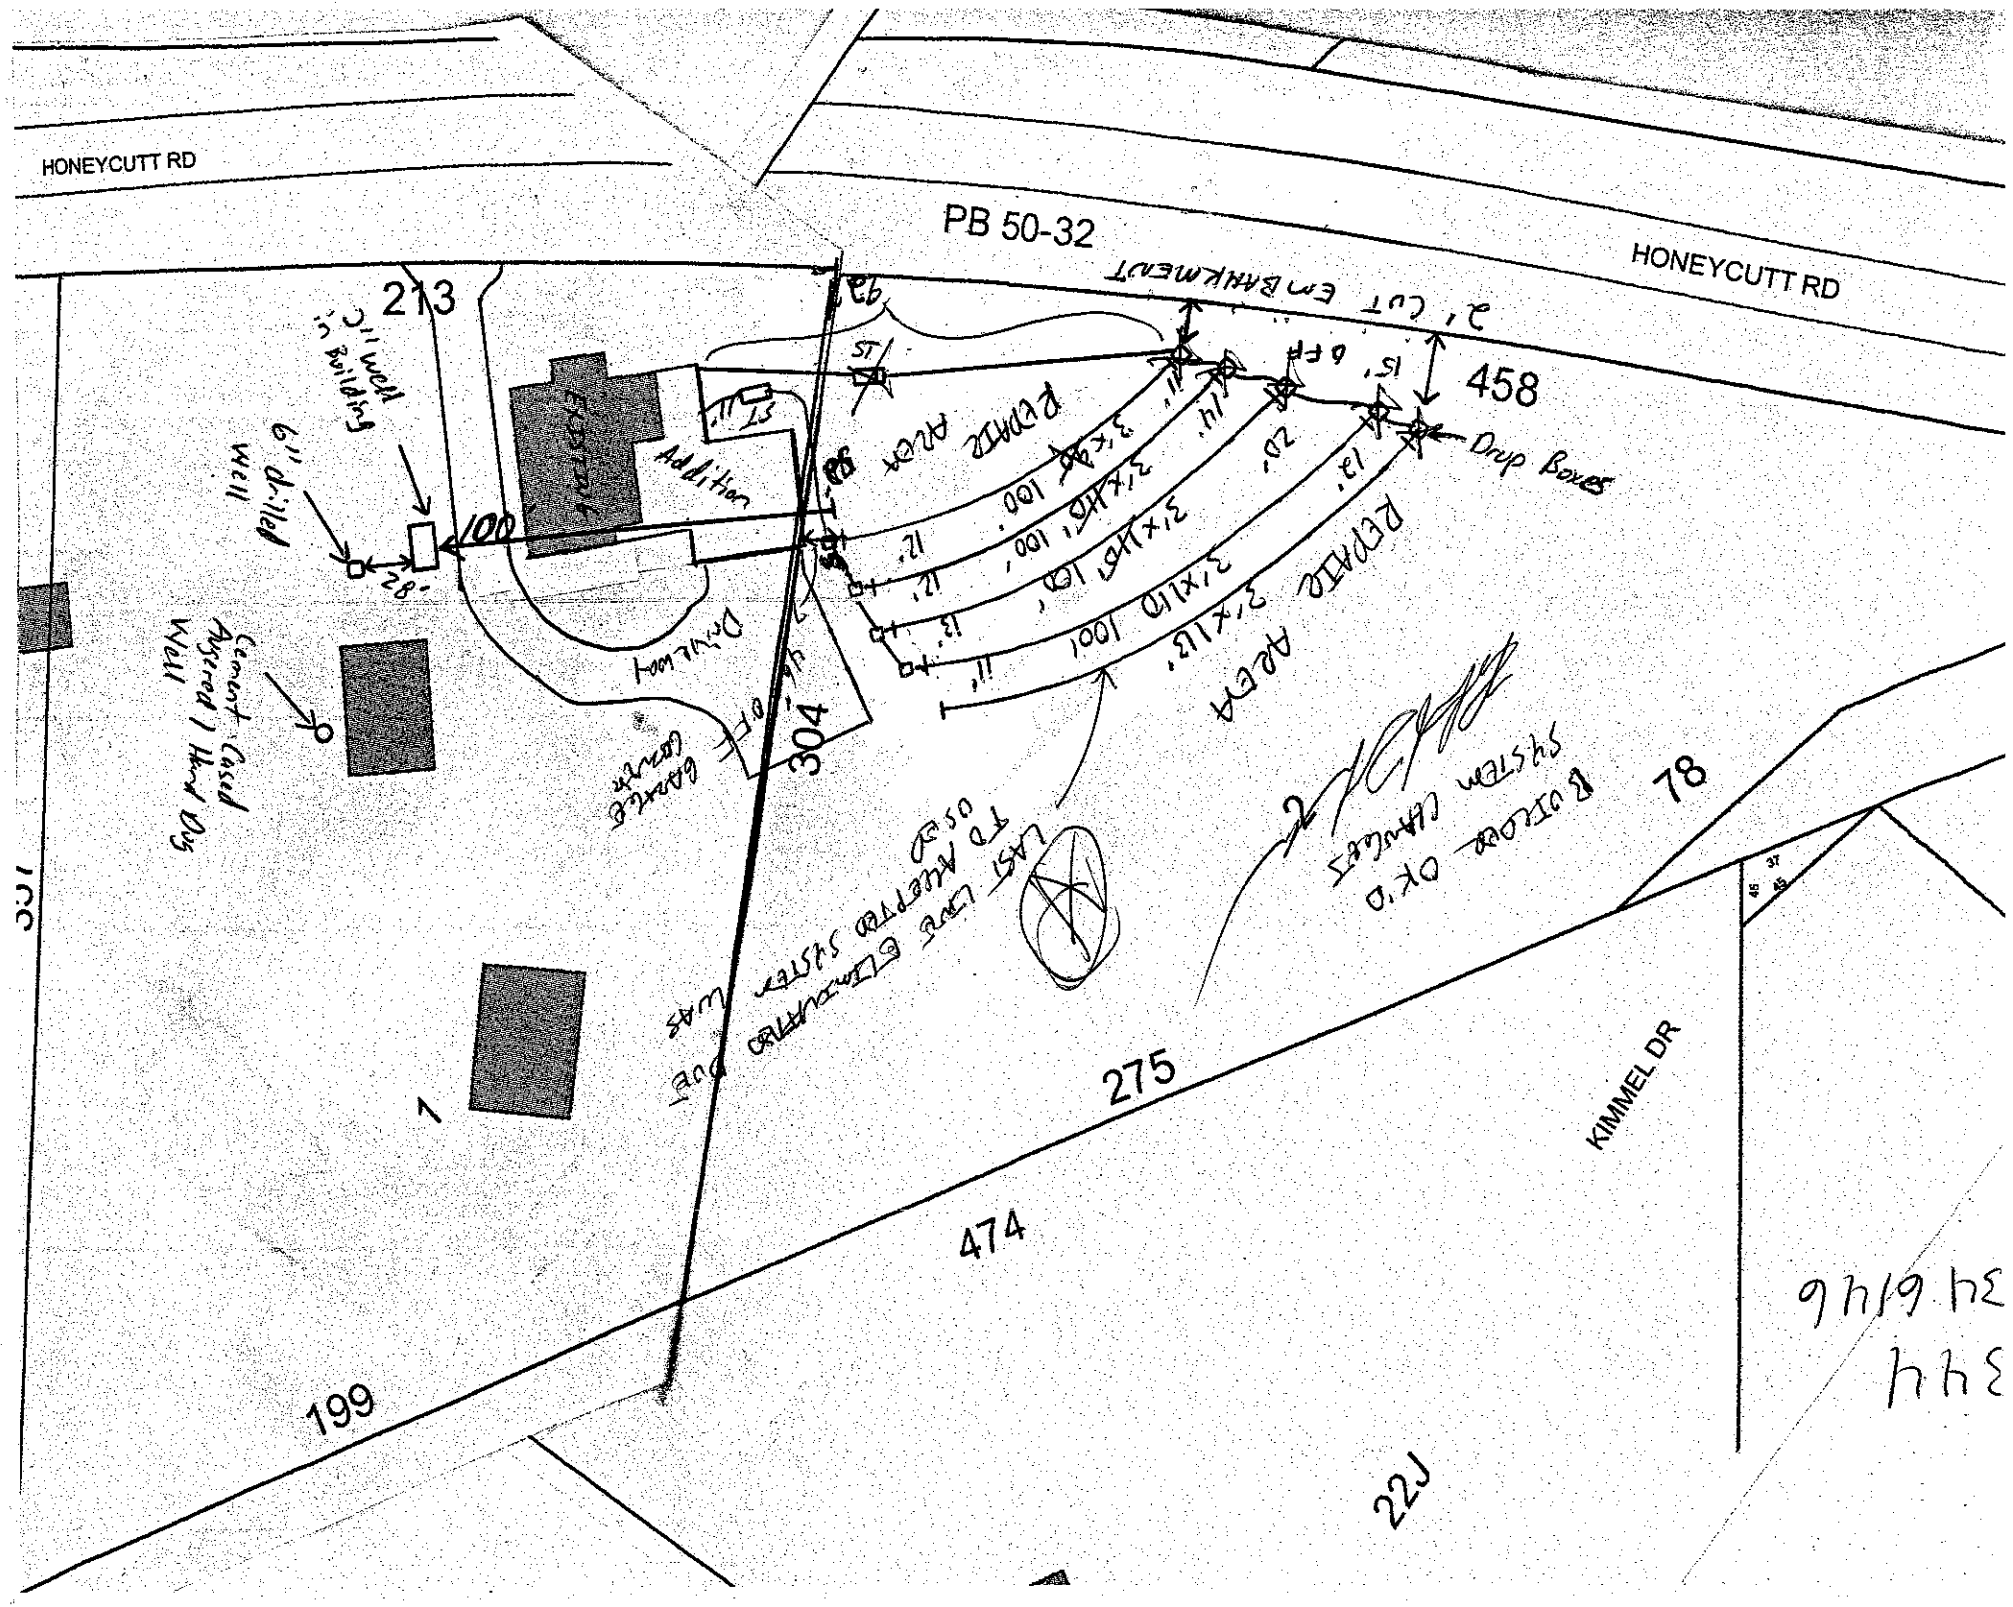
Authorization to Construct by: _____ date 11-7-08

Installed by: James Hodder #1791 Danny Lambert

Operation Permit by: _____ date 5-21-09

Existing System Inspection by: _____ date _____

HEALTH DEPT. COPY: WHITE OWNER COPY (FINAL): YELLOW OWNER COPY (INITIAL): PINK


HONEYCUTT RD
PB 50-32
HONEYCUTT RD
213
458
304
100
Addition
Existing Building
6" drilled well
Cement Cased Agxicad Well
Drive way
Drop Boxes
Existing Chimneys
Disconnected
78
275
474
199
KIMMEL DR
1
22J