IREDELL COUNTY HEALTH DEPARTMENT

STATESVILLE 704-878-5305 MOORESVILLE 704-664-5281

IMPROVEMENT PERMIT / AUTHORIZATION TO CONSTRUCT / OPERATION PERMIT / EXISTING SYSTEM INSPECTION

PERMIT# 124879 PIN# 4730-35-2803 DATE 12-6-04

OWNER OR CONTRACTOR GERALD RIMMER CONSTRUCTION, INC PHONE: Business (704) 902-1080 Home (704) 528-5724

ADDRESS 307 STATE PARK RD. TROUTMAN NC 28166

LOCATION US 21 S TR PERTH RD TR STATE PARK RD. 1ST HOUSE ON LEFT PAST FALLSTOWN BAPTIST CHURCH

SUBDIVISION _____ BLOCK / SECTION _____ LOT _____ LOT AREA 4.84 SITE CLASS. PS DESIGN FLOW 360 L.T.A.R. 0.30 gpd/ft²

Septic Tank: EXISTING Gallons; STB _____ Date _____

Pump Tank: _____ Gallons; PT _____ Date _____

Pump Make: _____ Model _____ Serial No. _____

Nitrification Field: No Fields 1 Square Feet 1200 Linear Feet 400

No Lines 5 Trench Width 36" Max Trench Bottom Depth 36" Gravel Depth 12"

☑ New System ☐ Repair System Type: I (II) III, IV, V, VI

System Description: CONVENTIONAL GRAVITY

Repair System Description: LP PANEL 50% RED

Maintenance Agreement Required: ☐ Yes ☑ No

☑ House/Mod. Home No. Bedrooms 3

☐ Mobile Home No. Bathrooms ____

☐ Business No. Employees ____

☐ Other _____

☐ Slab ☑ Crawl Space ☐ Basement w/plumbing ☐ Basement wo/plumbing


Water Supply: ☑ Individual ☐ Public ☐ Community

Comments/Conditions: (1) MAINTAIN ALL SETBACKS (2) INSTALL LINES ON CONTOUR (3) IF EXISTING SEPTIC TANK IS IN GOOD REPAIR PUMP OUT TANK, INSTALL NEW FILTER, DISCONNECT OLD LINES, REROUTE PLUMBING TO NEW SYSTEM

Comments/Conditions: (4) IF SEPTIC TANK IS IN POOR REPAIR, PUMP, CRUSH, AND FILL EXISTING TANK / INSTALL NEW TANK BEHIND HOUSE AND GRAVITY FEED NEW SYSTEM *(5) BORED WELL MUST BE ABANDONED & RECORDED (5) DROP BOXES BEFORE PERMIT CAN BE ISSUED.

*1"=50'

INITIAL SITE SKETCH

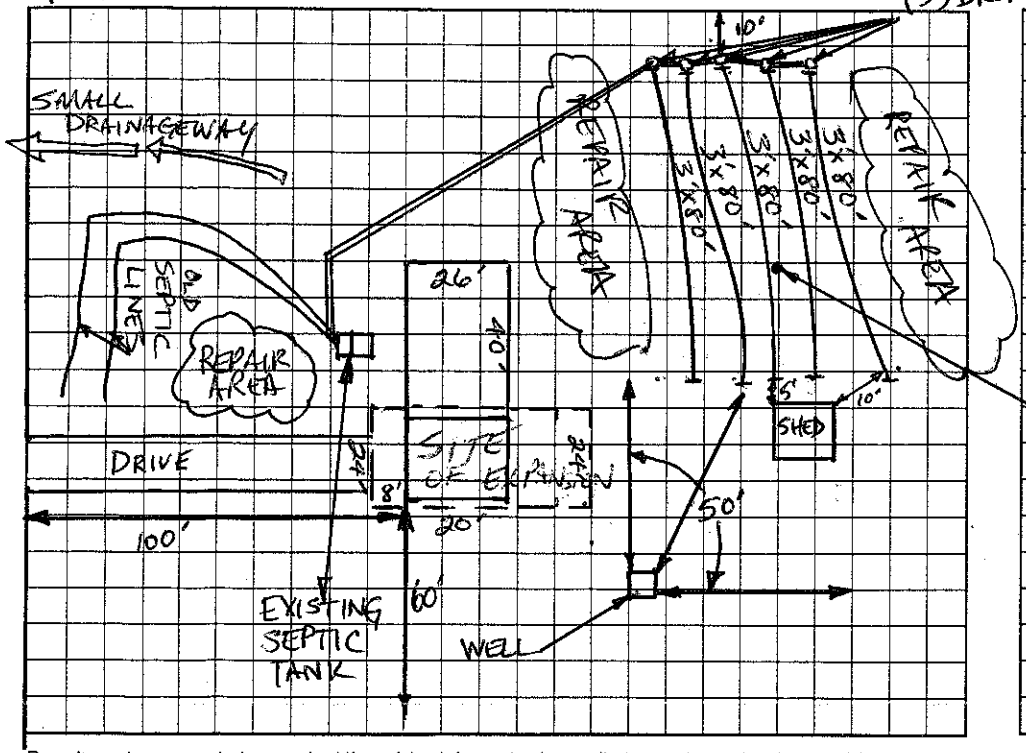

AS BUILT SKETCH

*TUFF-TITE FILTER IN TANK

*#57 STONE IN TRENCHES

*SYSTEM INSTALLED AS SHOWN

Permit can be suspended or revoked if any false information is supplied toward securing the permit/any unauthorized changes are made to the site/any unauthorized changes are made in the installation of the system. Improvement Permit with plat valid without expiration. Improvement Permit with site plan valid for sixty months. Authorization to Construct is valid for a period equal to that of Improvement Permit – not to exceed sixty months.

Signed: _____ date 1-3-05 Installed by: PIEDMONT BACKHOE

Improvement Permit by: _____ date 12-6-04 Operation Permit by: _____ date 3-11-05

Authorization to Construct by: _____ date 1-6-05 Existing System Inspection by: _____ date _____

HEALTH DEPT. COPY: WHITE OWNER COPY (FINAL): YELLOW OWNER COPY (INITIAL): PINK